


SLEEVE CROSSINGS				
No.	Station	Ref.	Offset	Type
1	0+43.3'	"A"	23.0'L	1 each 4", 2" and 1" PVC Irrigation Sleeves
2	0+41.0'	"A"	22.0'R	
3	0+67.3'	"A"	20.5'L	1 - 4" Irrigation Sleeve
4	0+68.0'	"A"	21.5'L	
5	0+70.5'	"A"	00.0'	1 - 4" Island Feed
6	0+71.5'	"A"	21.5'L	
7	0+86.0'	"A"	20.5'L	2" PVC
8	0+88.0'	"A"	2.5'L	

HARBOURSIDE (SEE DWG. # "NBYR-0005" #17 & 18)

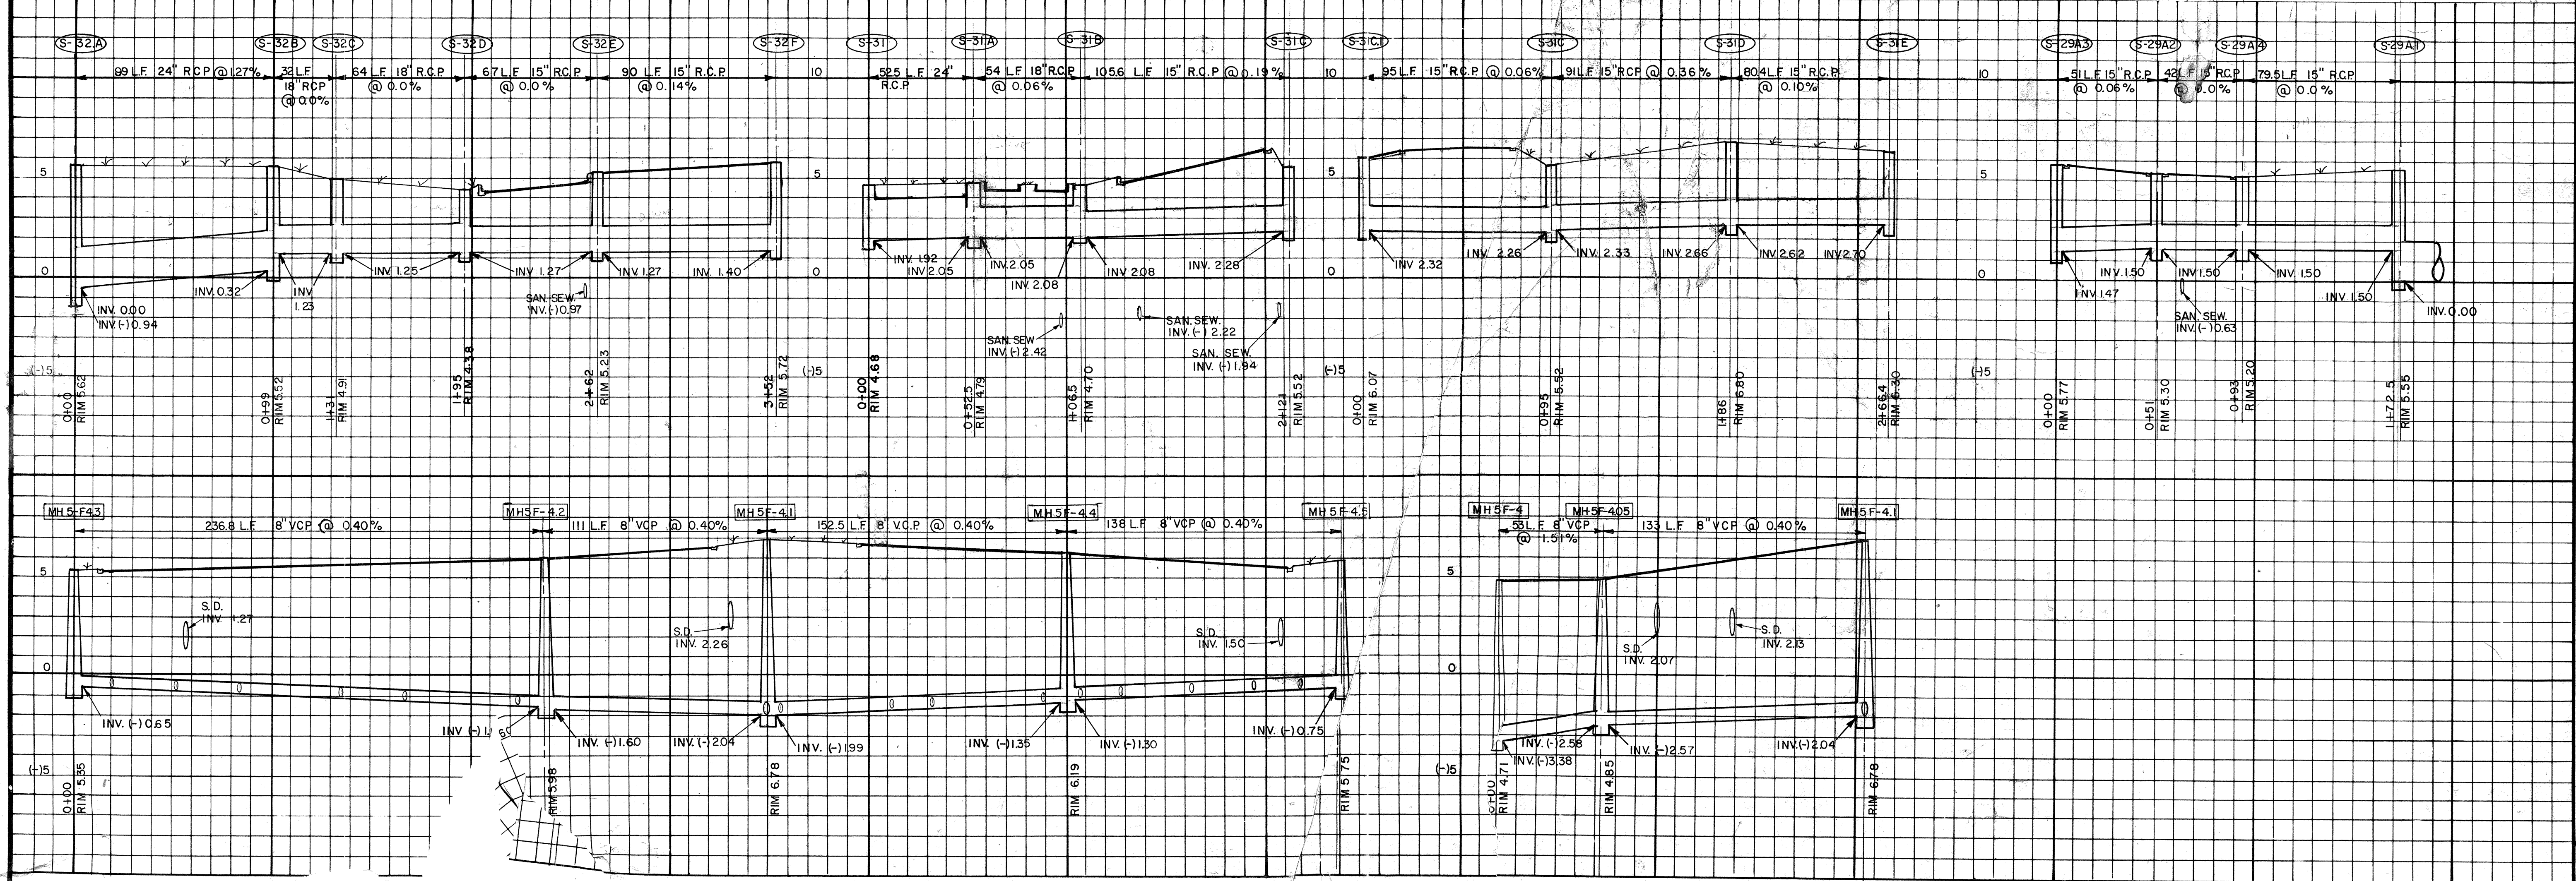

**TOWN OF LONGBOAT KEY, FLORIDA**  
 RECORD DRAWING HARBOUR COURT  
 ENGINEER & LOCATION WILLIAM F. BISHOP & ASSOCIATES, INC. 78 SARASOTA CENTER BLVD. SARASOTA, FL. 34240  
 SHEET NUMBER NBYR-0005  
 T.L.K. FILE NO.

DESIGNED BY	PROJECT ENGINEER
CHECKED BY	PROJECT NO.
DRAWN BY	DATE: 2-25-87
PJ / RWC	BY
	REVISION
	L.T.R. DATE