


NOTE: FOR DETAILS OF CONSTRUCTION OF FAIR OAKS LANE SEE SHEET NO. 9

NOTE: ALL STATIONING FOR SANITARY MANHOLE'S; STORM CATCH BASIN'S & INLETS ETC. ARE GIVEN RELATIVE TO THE CENTERLINE STATIONING FOR THE PROPOSED ROADWAY.

NOTE: FLARED END SECTIONS SHALL BE F.D.O.T. INDEX NO. 270.

FLOOD ZONE A13 (EL=12')

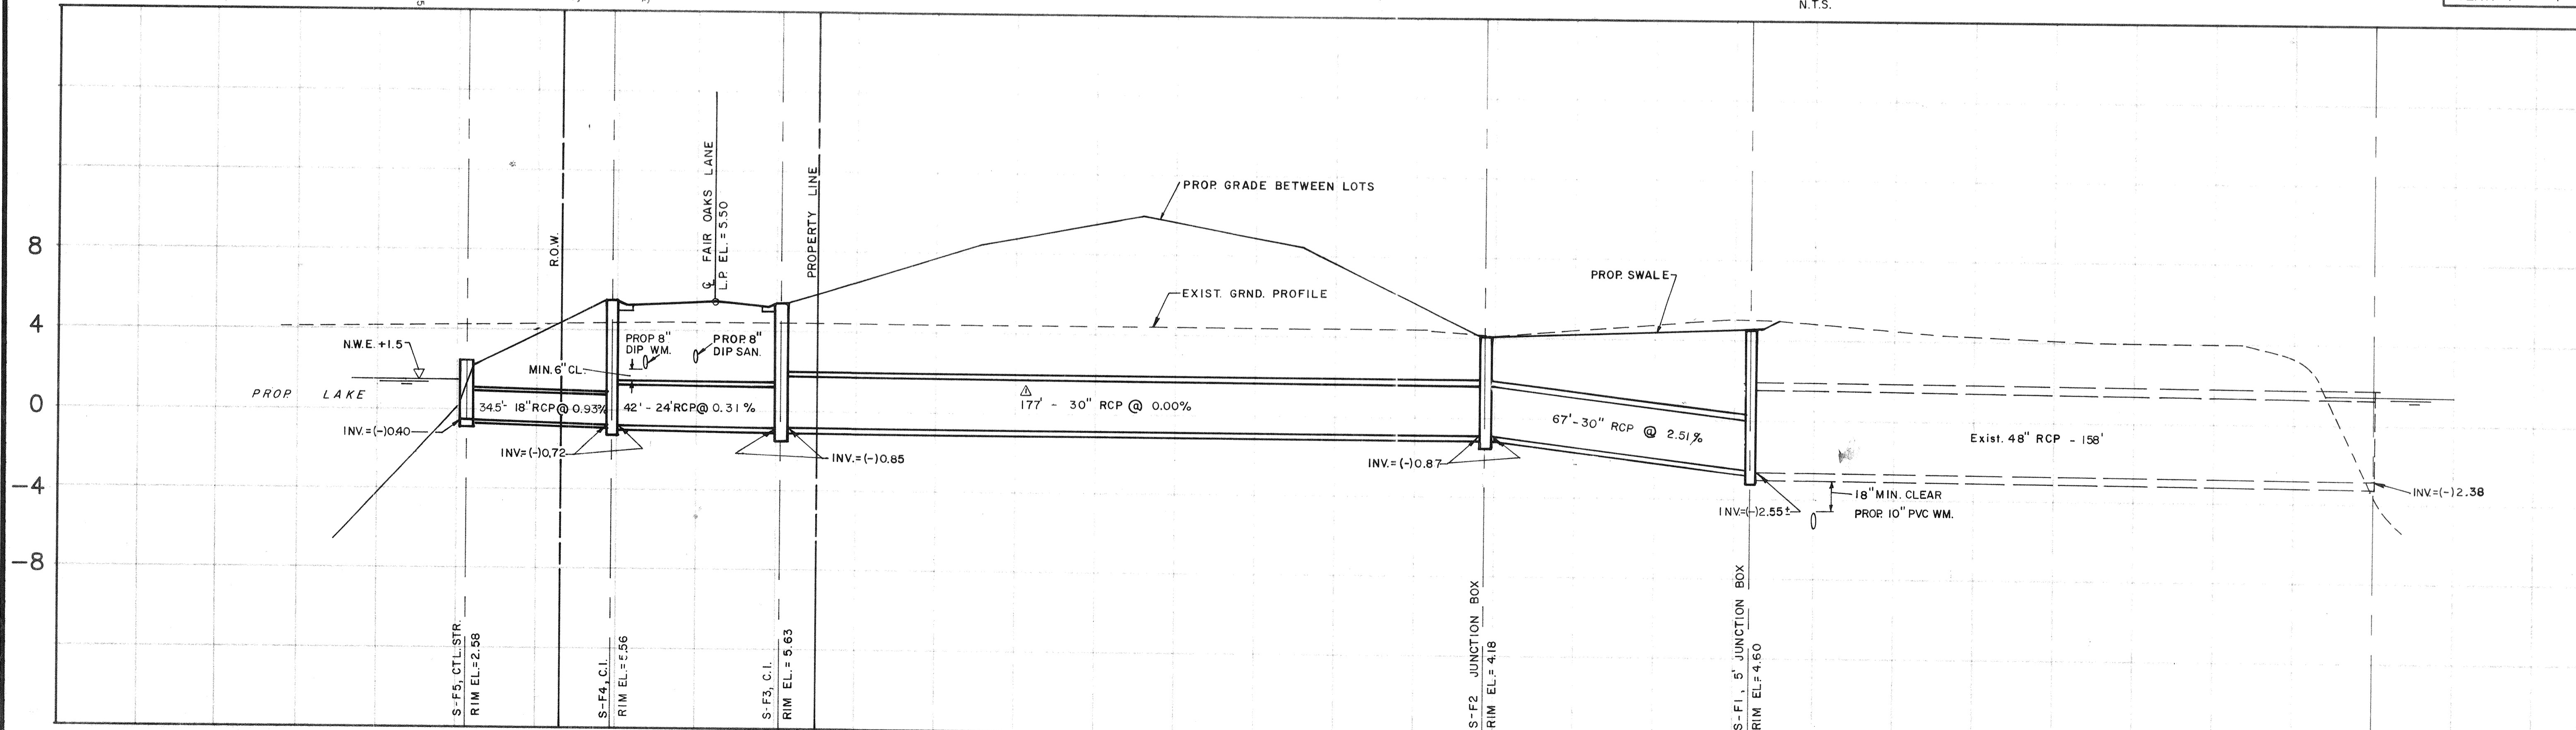

DESIGNED BY PROJECT ENGINEER
 DATE: 9-8-89
 SCALE: 1" = 20'
 CHECKED BY PROJECT NO. S.R.
 DRAWN BY PP/C/J/SR DBDS-0018
 R.W.C.
 BY REVISION
 L.T.R. DATE
 TOWN OF LONGBOAT KEY, FLORIDA
 MANCHESTER BAY
 DIAMOND - CARVER, INC.
 AS-BUILT/RECORD DRAWING OF STORM SEWER
 BISHOP & ASSOCIATES, INC. CONSULTING ENGINEERS - SURVEYORS
 78 Sarasota Center Blvd. Sarasota, Florida 34240
 Ph (813) 371-6362
 SHEET NUMBER 16RD
 REVISION
 K. FILE NO.