


FLOOD ZONE A13 (EL.11')

SCALE:
 HORZ. 1" = 20'
 VERT. 1" = 4'

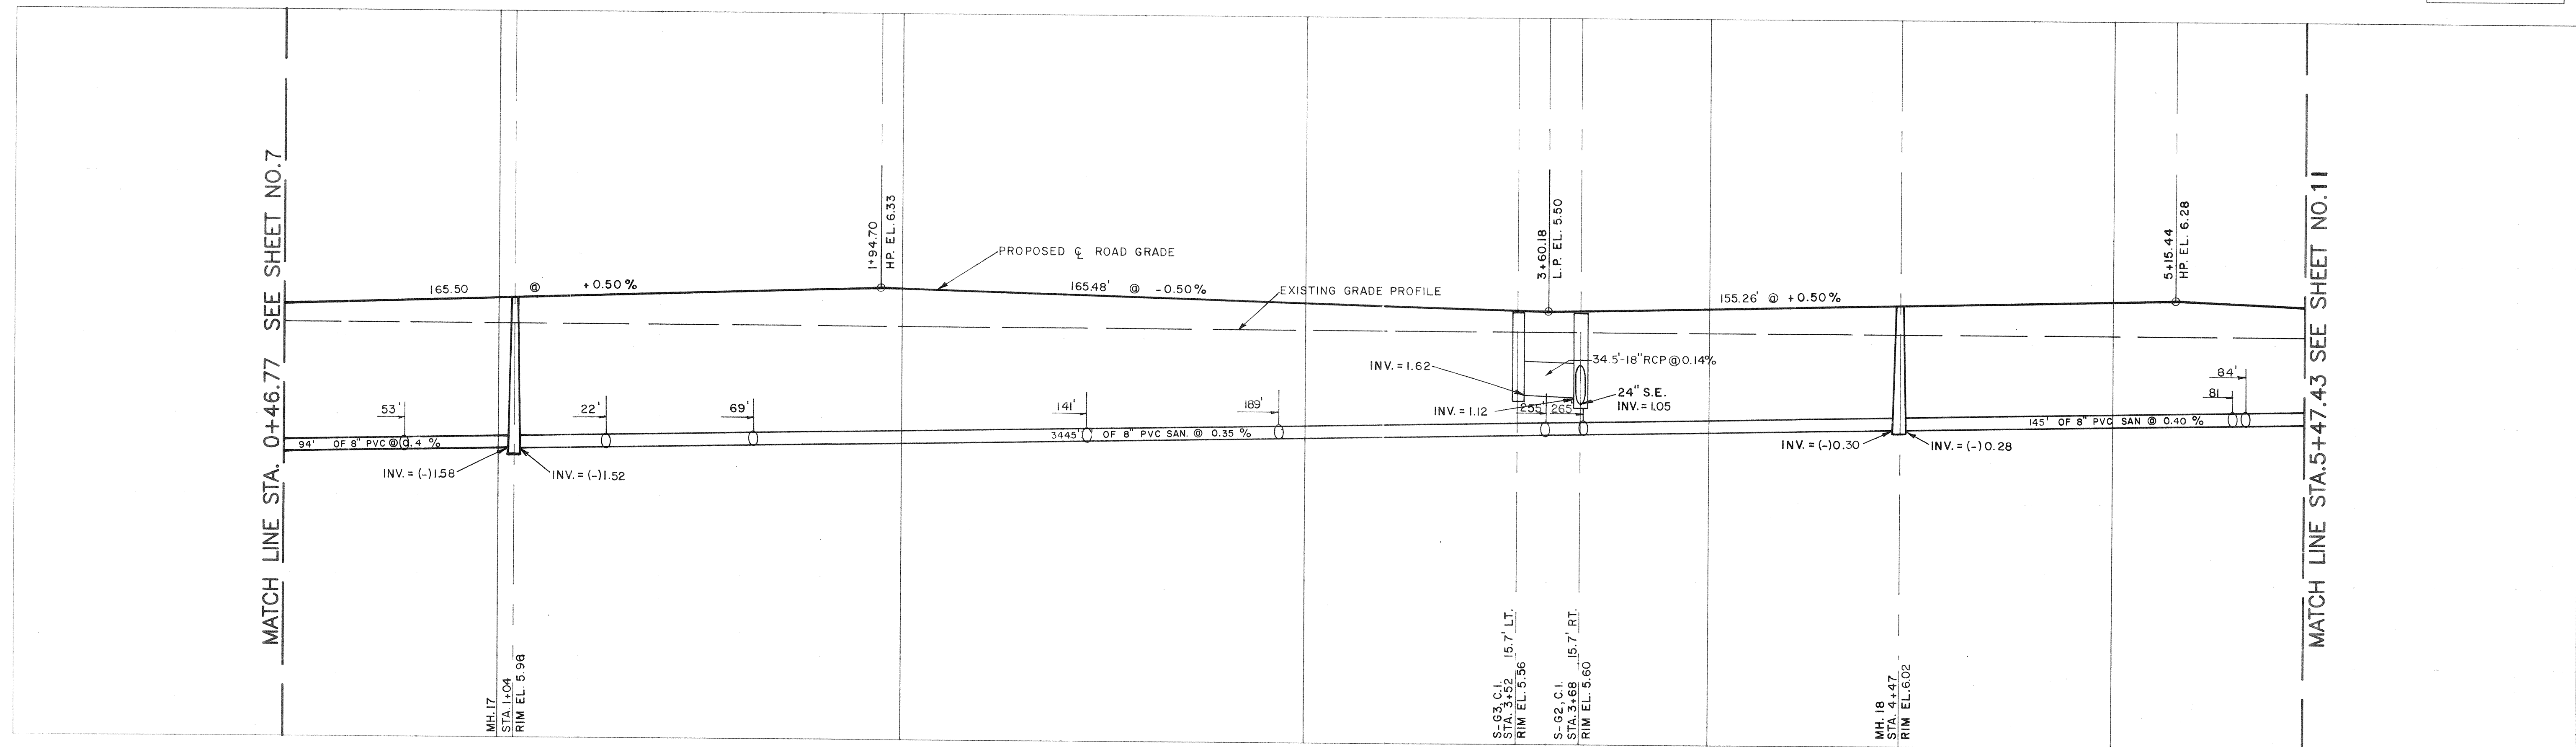

MATCH LINE STA. 0+46.77 SEE SHEET NO.7

MATCH LINE STA.5+47.43 SEE SHEET NO.11

SHEET NUMBER IORD	DESIGNED BY S.R.	PROJECT ENGINEER
	DATE: 9-8-89	
REVISION	DRAWN BY R.W.C.	CHECKED BY PP/C.J./SR.
L.T.R.	DATE	PROJECT NO. DBOS-008
TOWN OF LONGBOAT KEY, FLORIDA MANCHESTER BAY DIAMOND - GARVER, INC.		Ph (813) 371-6362
AS-BUILT/RECORD DRAWING OF WATERMAIN, SAN. & STORM SEWER		Sarasota, Florida 34240
BISHOP & ASSOCIATES, INC. CONSULTING ENGINEERS - SURVEYORS		78 Sarasota Center Blvd.
K. FILE NO.		