


NOTE: ALL CURB IS TYPE "K" CURB UNLESS OTHERWISE NOTED.


NOTE: ALL STATIONING FOR SANITARY MANHOLES, STORM CATCH BASIN'S & INLETS ETC. ARE GIVEN RELATIVE TO THE CENTERLINE STATIONING FOR THE PROPOSED ROADWAY.

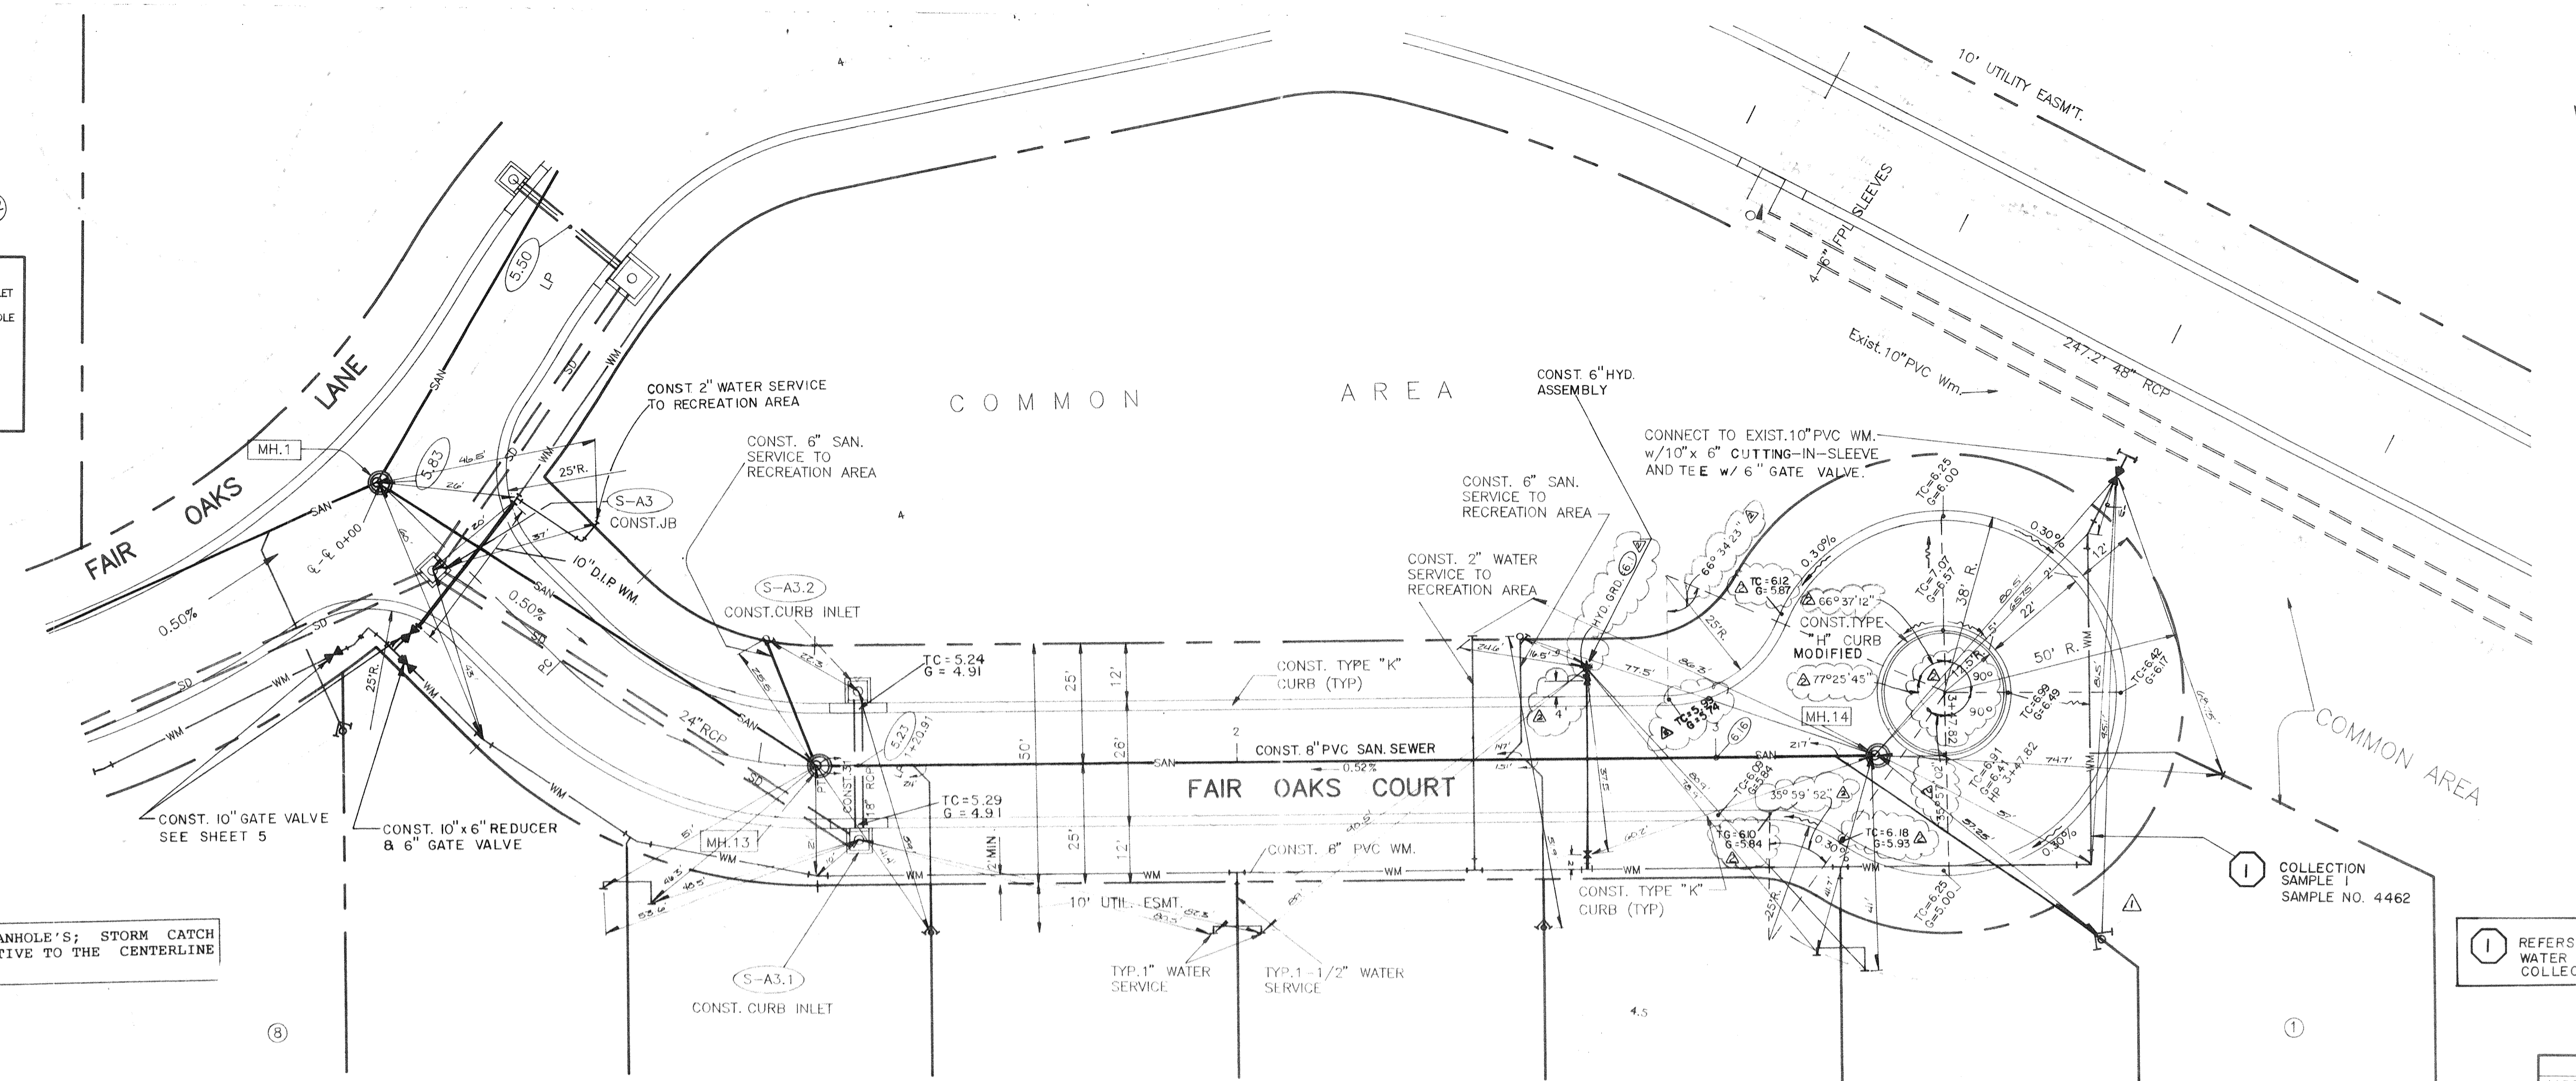

FLOOD ZONE A13 (EL.11')

REFERS TO H.R.S. WATER SAMPLE COLLECTION NO. TYP.

SCALE:
 HORZ. 1" = 20'
 VERT. 1" = 4'

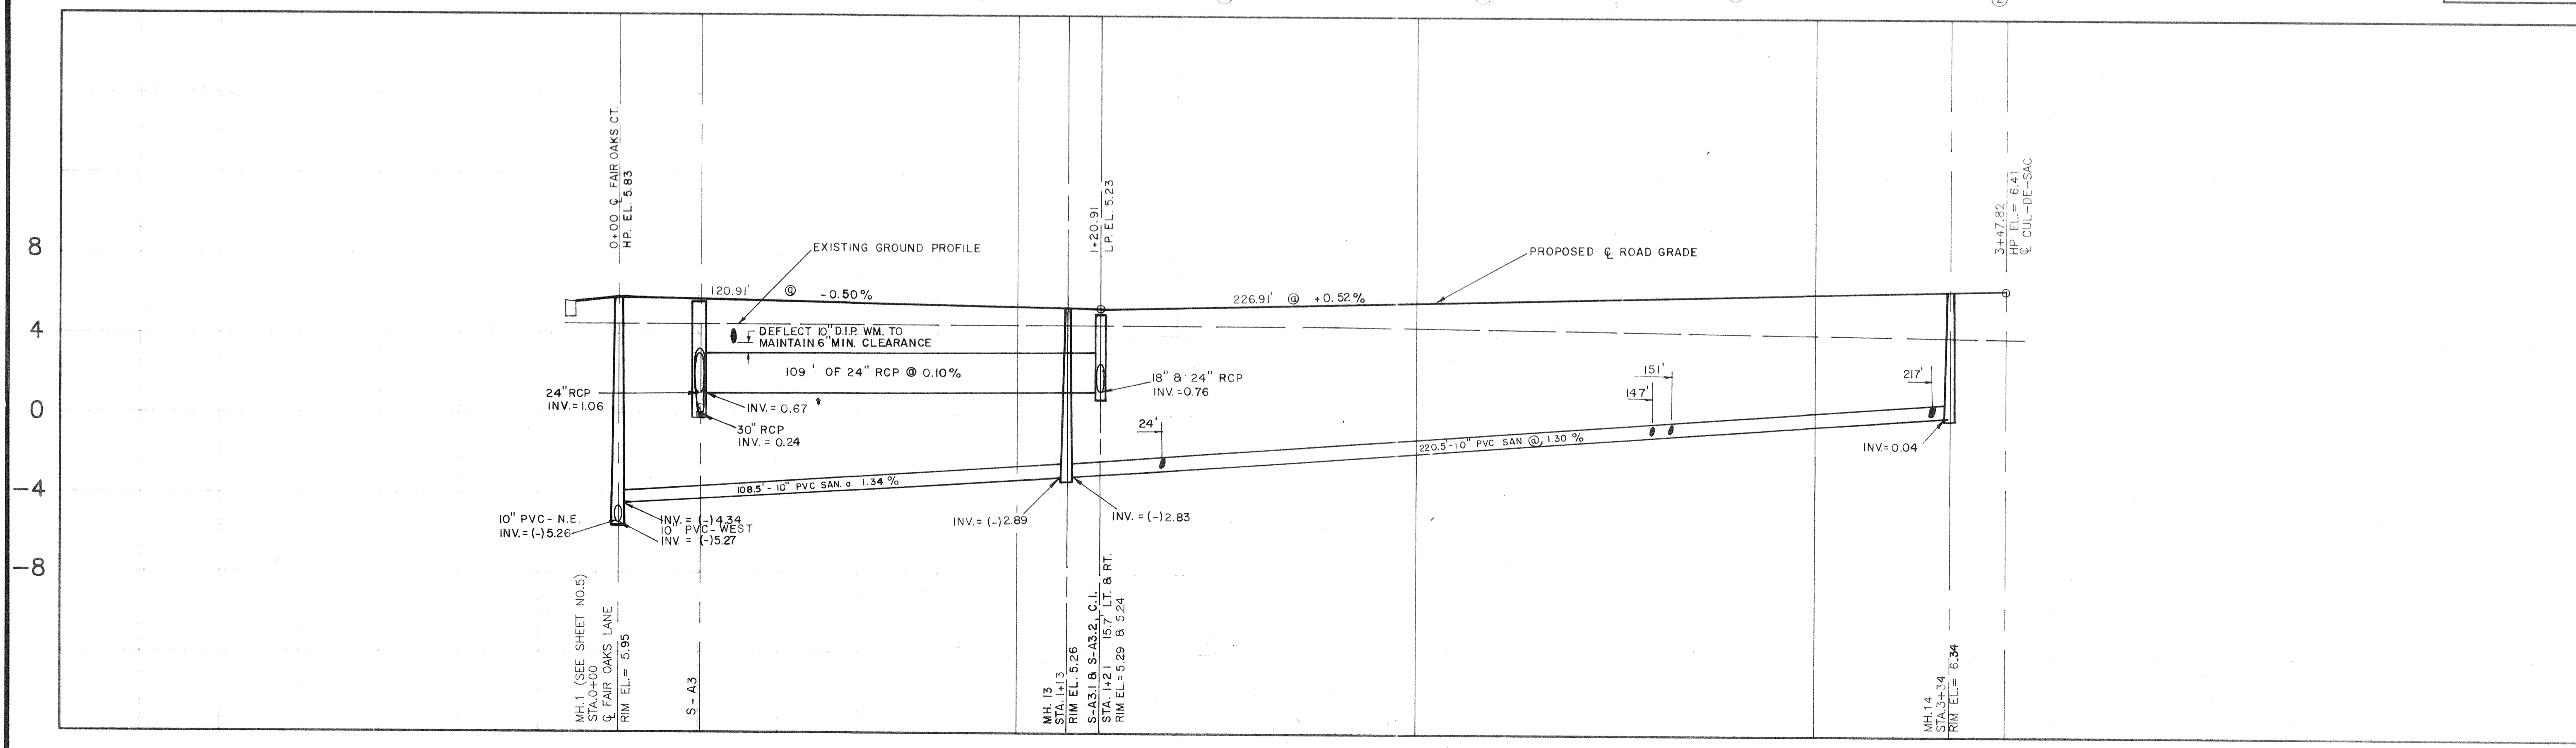

DESIGNED BY S.R.	DATE: 9-8-89	PROJECT ENGINEER
	CHECKED BY R.W.C.	
DRAWN BY R.W.C.	PROJECT NO. DBDS-0018	REVISION
	PP/C/J/SR	
78 Sarasota Center Blvd. Sarasota, Florida 34240		L.T.R. DATE
TOWN OF LONGBOAT KEY, FLORIDA		
MANCHESTER BAY		SHEET NUMBER 12RD
DIAMOND - CARVER, INC.		
A.S.-BUILT/RECORD DRAWING OF WATERMAIN, SAN. & STORM SEWER		REVISION
ELUCATOR BISHOP & ASSOCIATES, INC. CONSULTING ENGINEERS - SURVEYORS		