
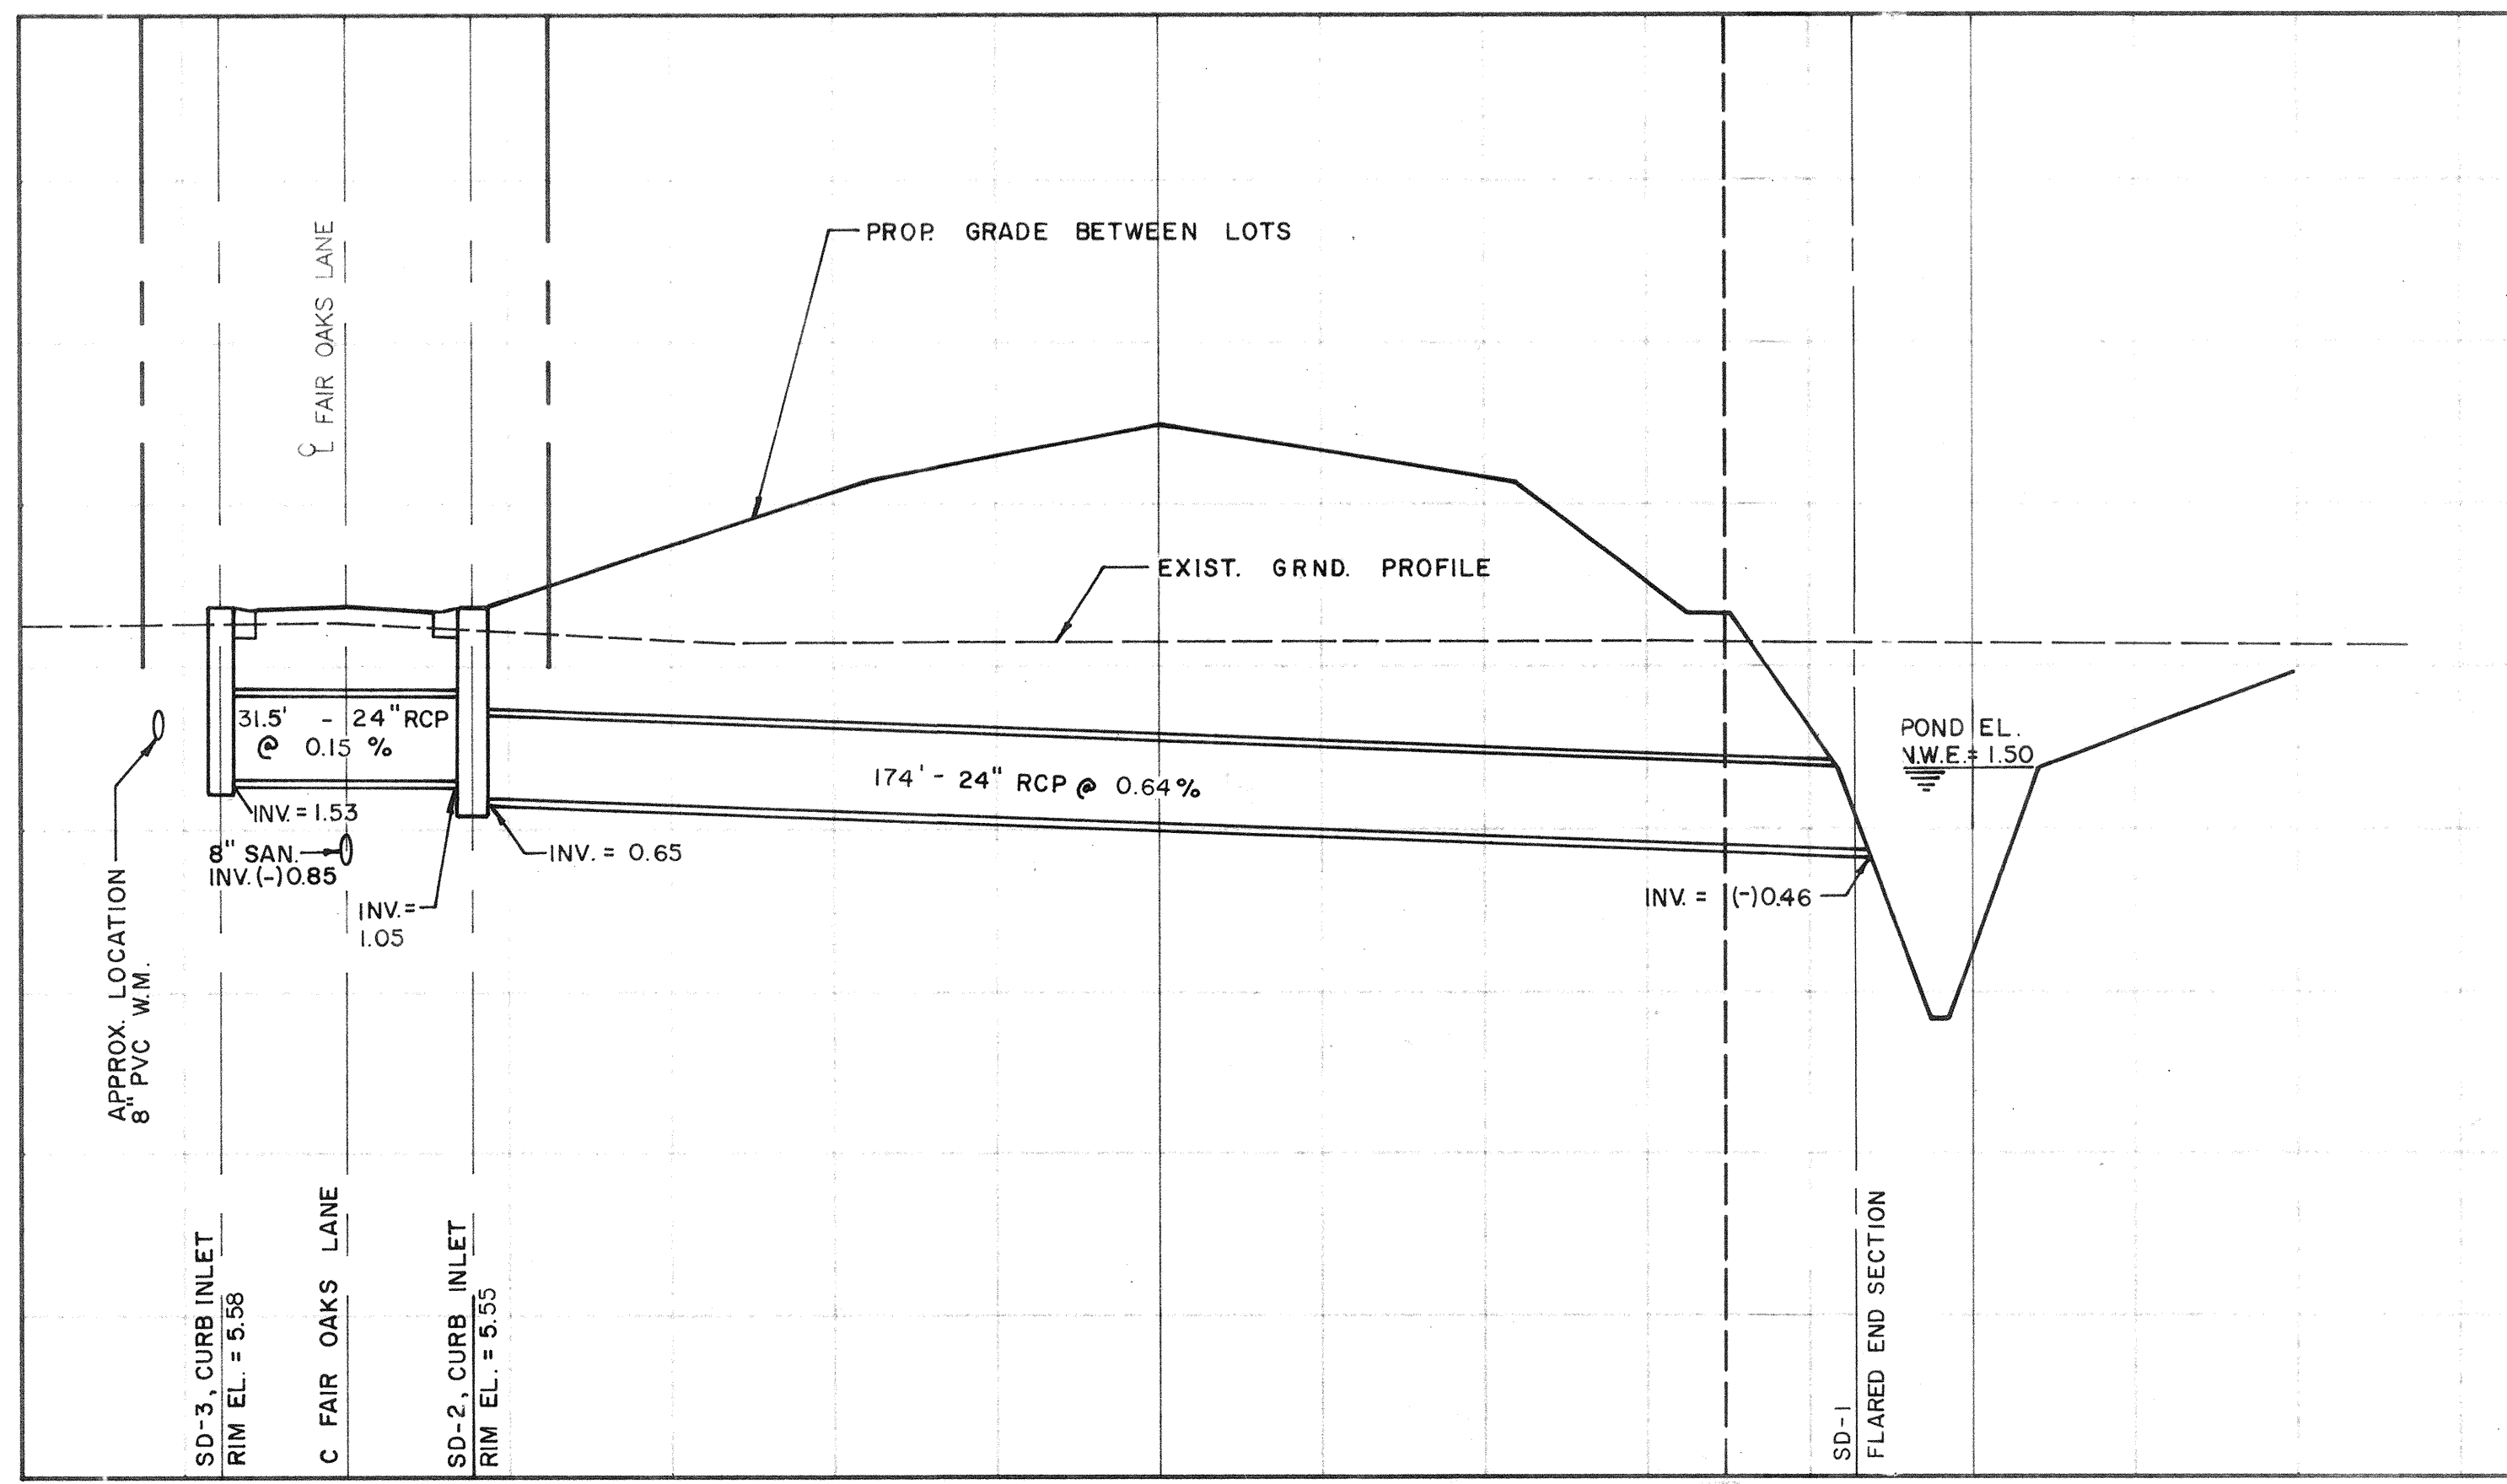


FLOOD ZONE A13 (EL.=12')

NOTE: FLARED END SECTIONS SHALL BE F.D.O.T. INDEX NO. 270.

SCALE:
 HORZ. 1" = 20'
 VERT. 1" = 4'

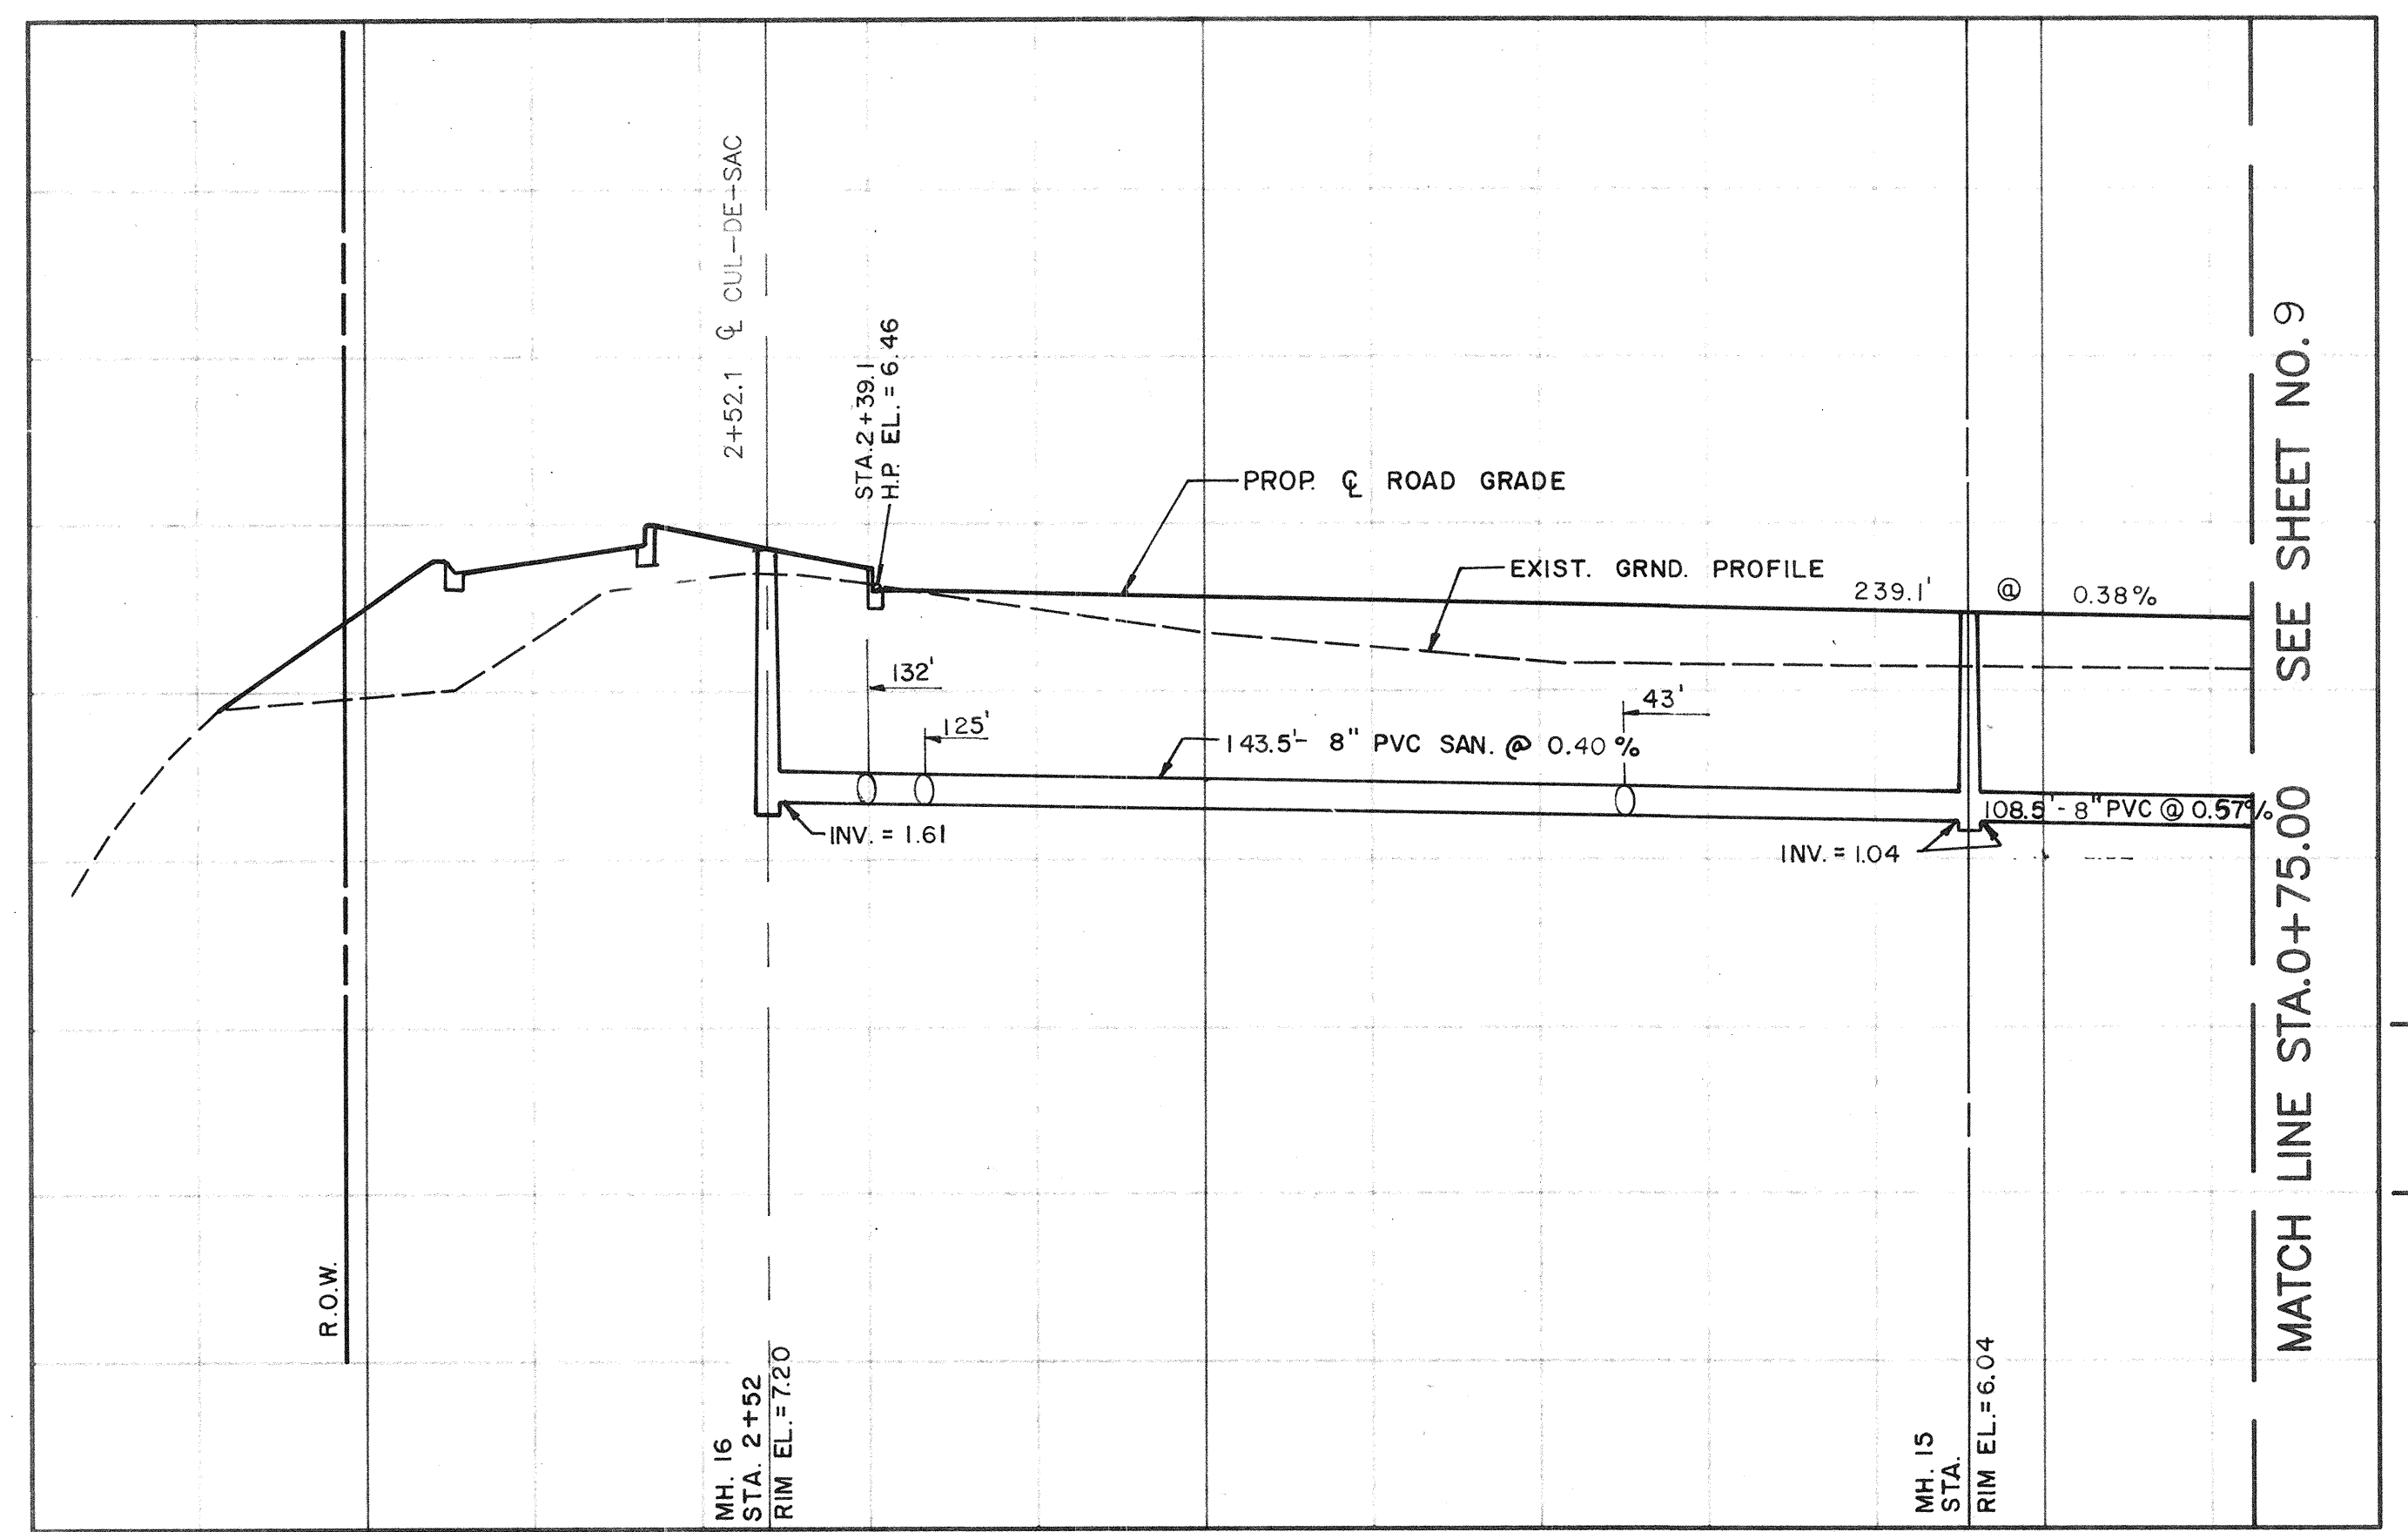

DESIGNED BY: PROJECT ENGINEER
 DATE: 9-8-89
 SCALE: 1" = 20'
 CHECKED BY: SR.
 DRAWN BY: PP/C.J./SR. DBDS-0018
 R.W.C.
 Ph (813) 371-6362

REVISION

BY

DATE

L.T.R.

88 Sarasota Center Blvd. Sarasota, Florida 34240

78 Sarasota Center Blvd. Sarasota, Florida 34240

TOWN OF LONGBOAT KEY, FLORIDA
 MANCHESTER BAY
 DIAMOND - CARVER, INC.
 AS - BUILT / RECORD DRAWING OF STORM SEWER
 BISHOP & ASSOCIATES, INC. CONSULTING ENGINEERS - SURVEYORS

ENGINEER'S LOCATION

K. FILE NO.

SHEET NUMBER
 13RD

REVISION

Ruepen's