

NOTE: FLARED END SECTIONS SHALL F.D.O.T. INDEX NO. 270.

LEGEND



- SD — PROP. STORM DRAIN w/ CURB INLET
- SN — PROP. SANITARY SEWER w/ MANHOLE
- WM — PROP. WATERMAIN w/ GATE VALVE
- △ — EXISTING SPOT ELEVATION
- — PROPOSED SPOT ELEVATION

NOTE: ALL CURB IS TYPE "K" CUI '9 UNLESS OTHERWISE NOTED

SCALE:
 HORZ. 1" = 20'
 VERT. 1" = 4'

FLOOD ZONE A13 (EL.12')

FLOOD ZONE A13 (EL.11')

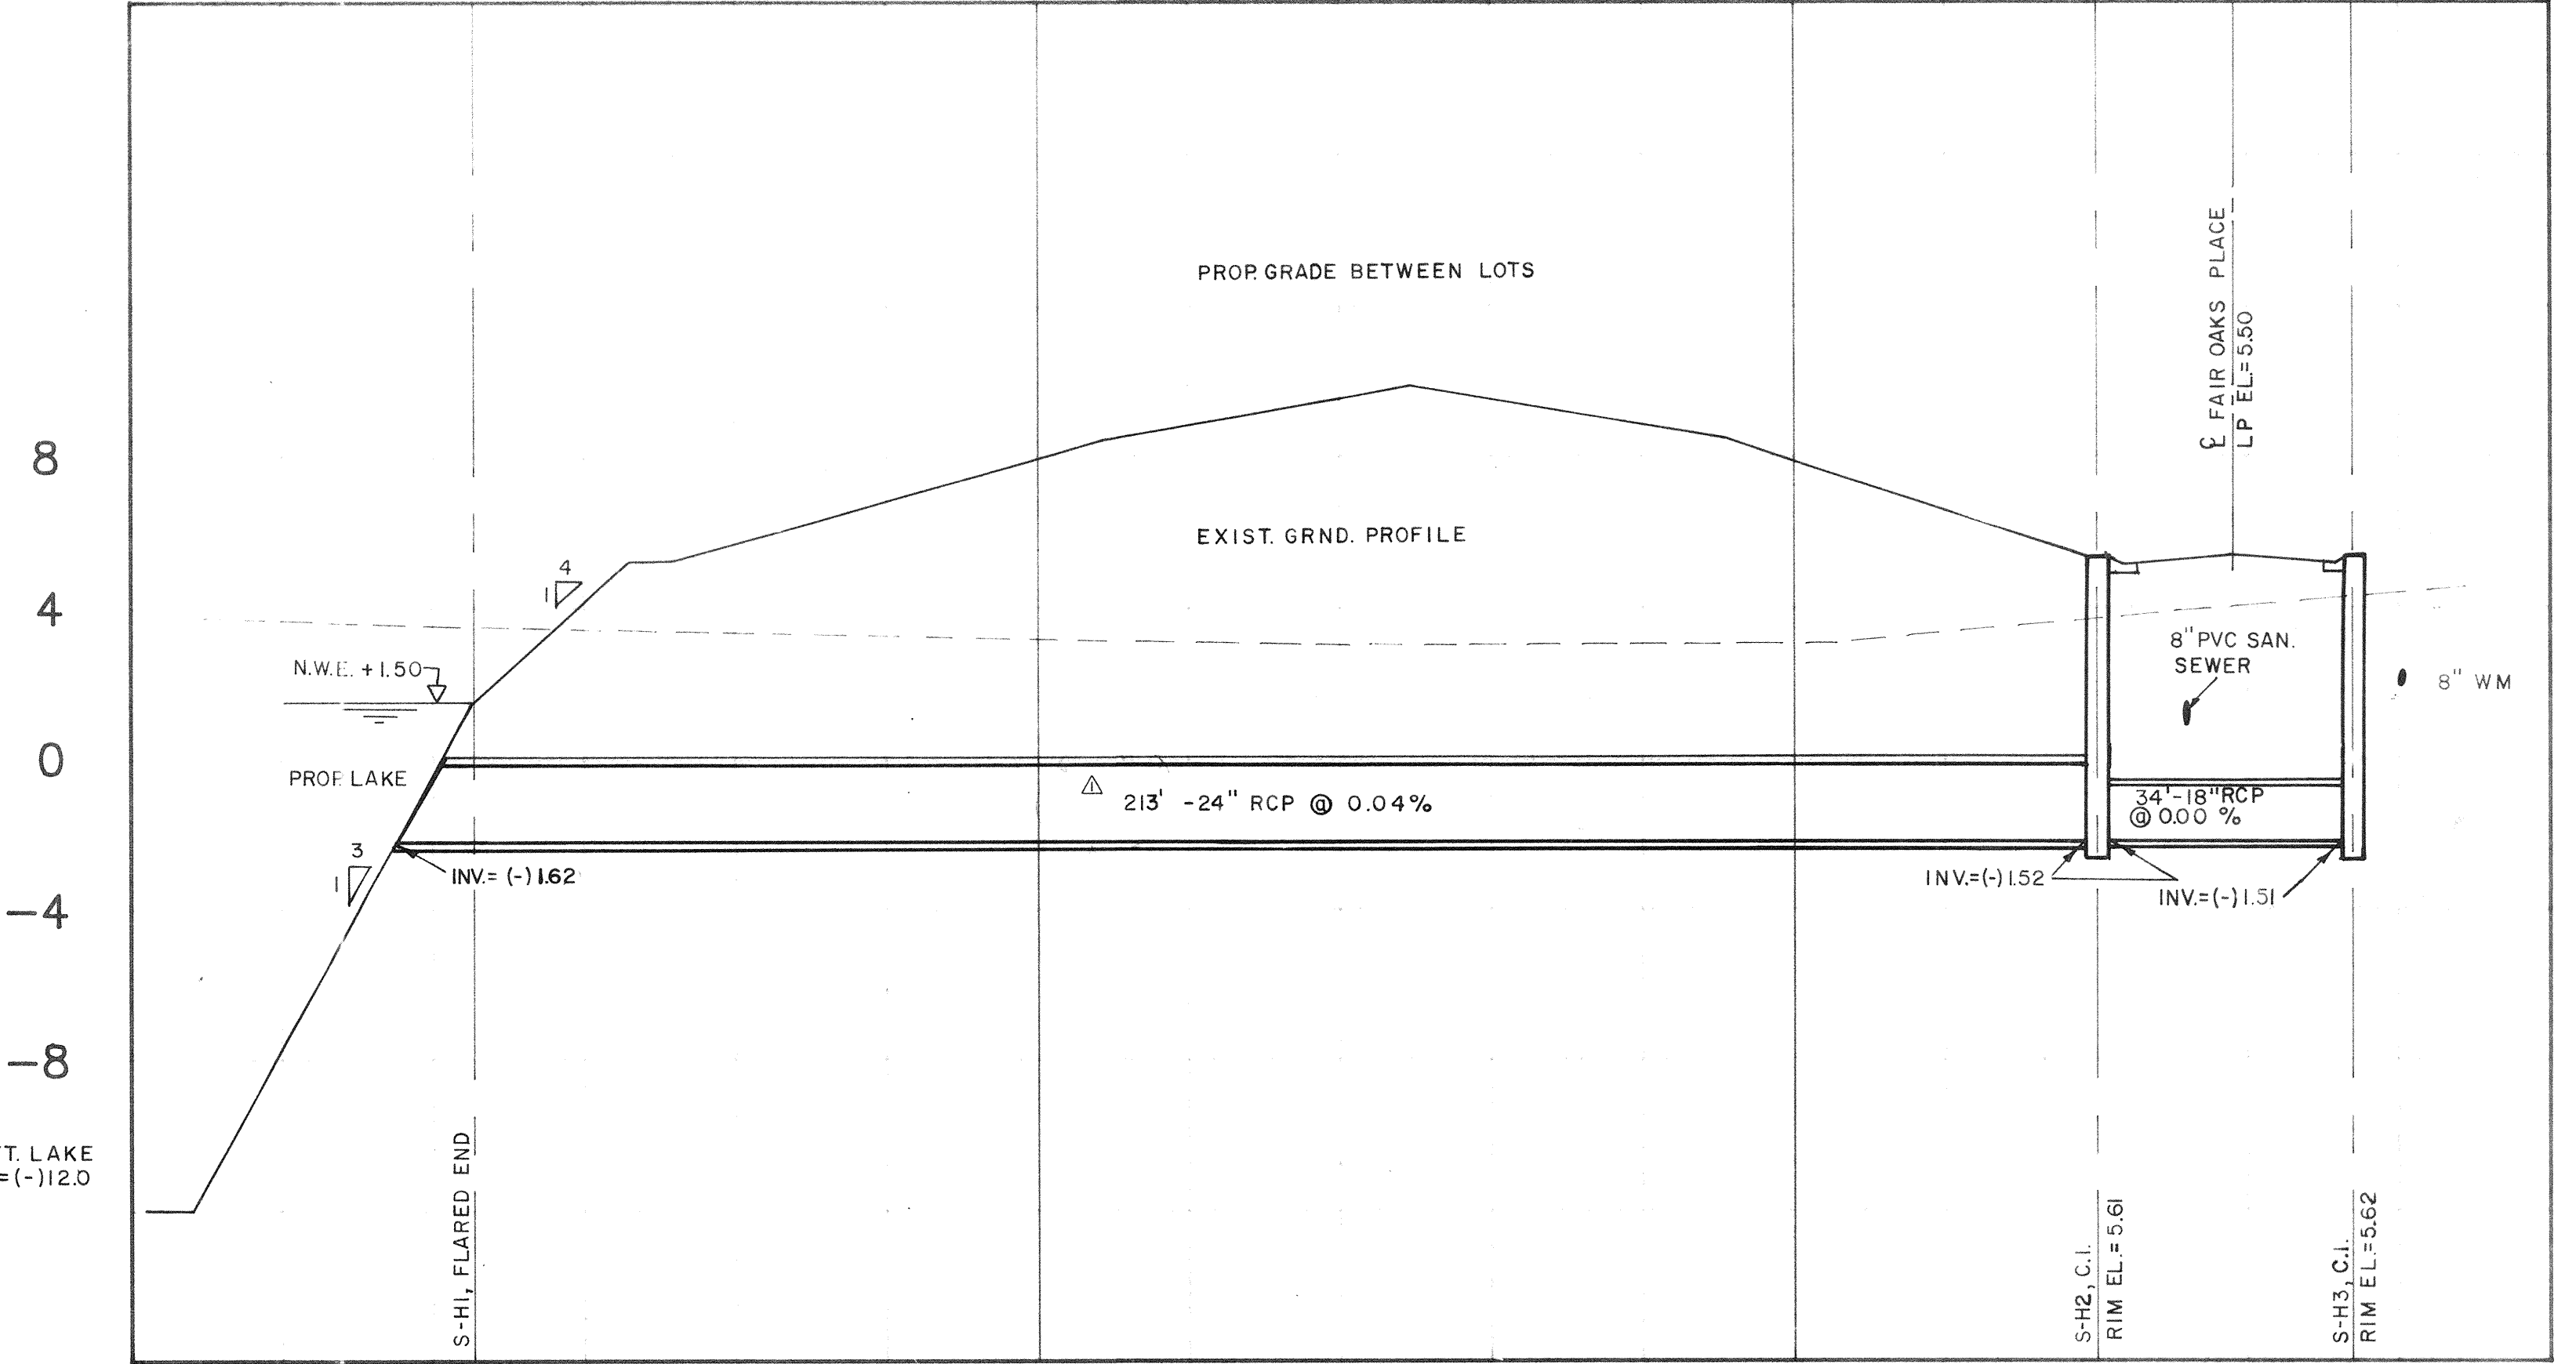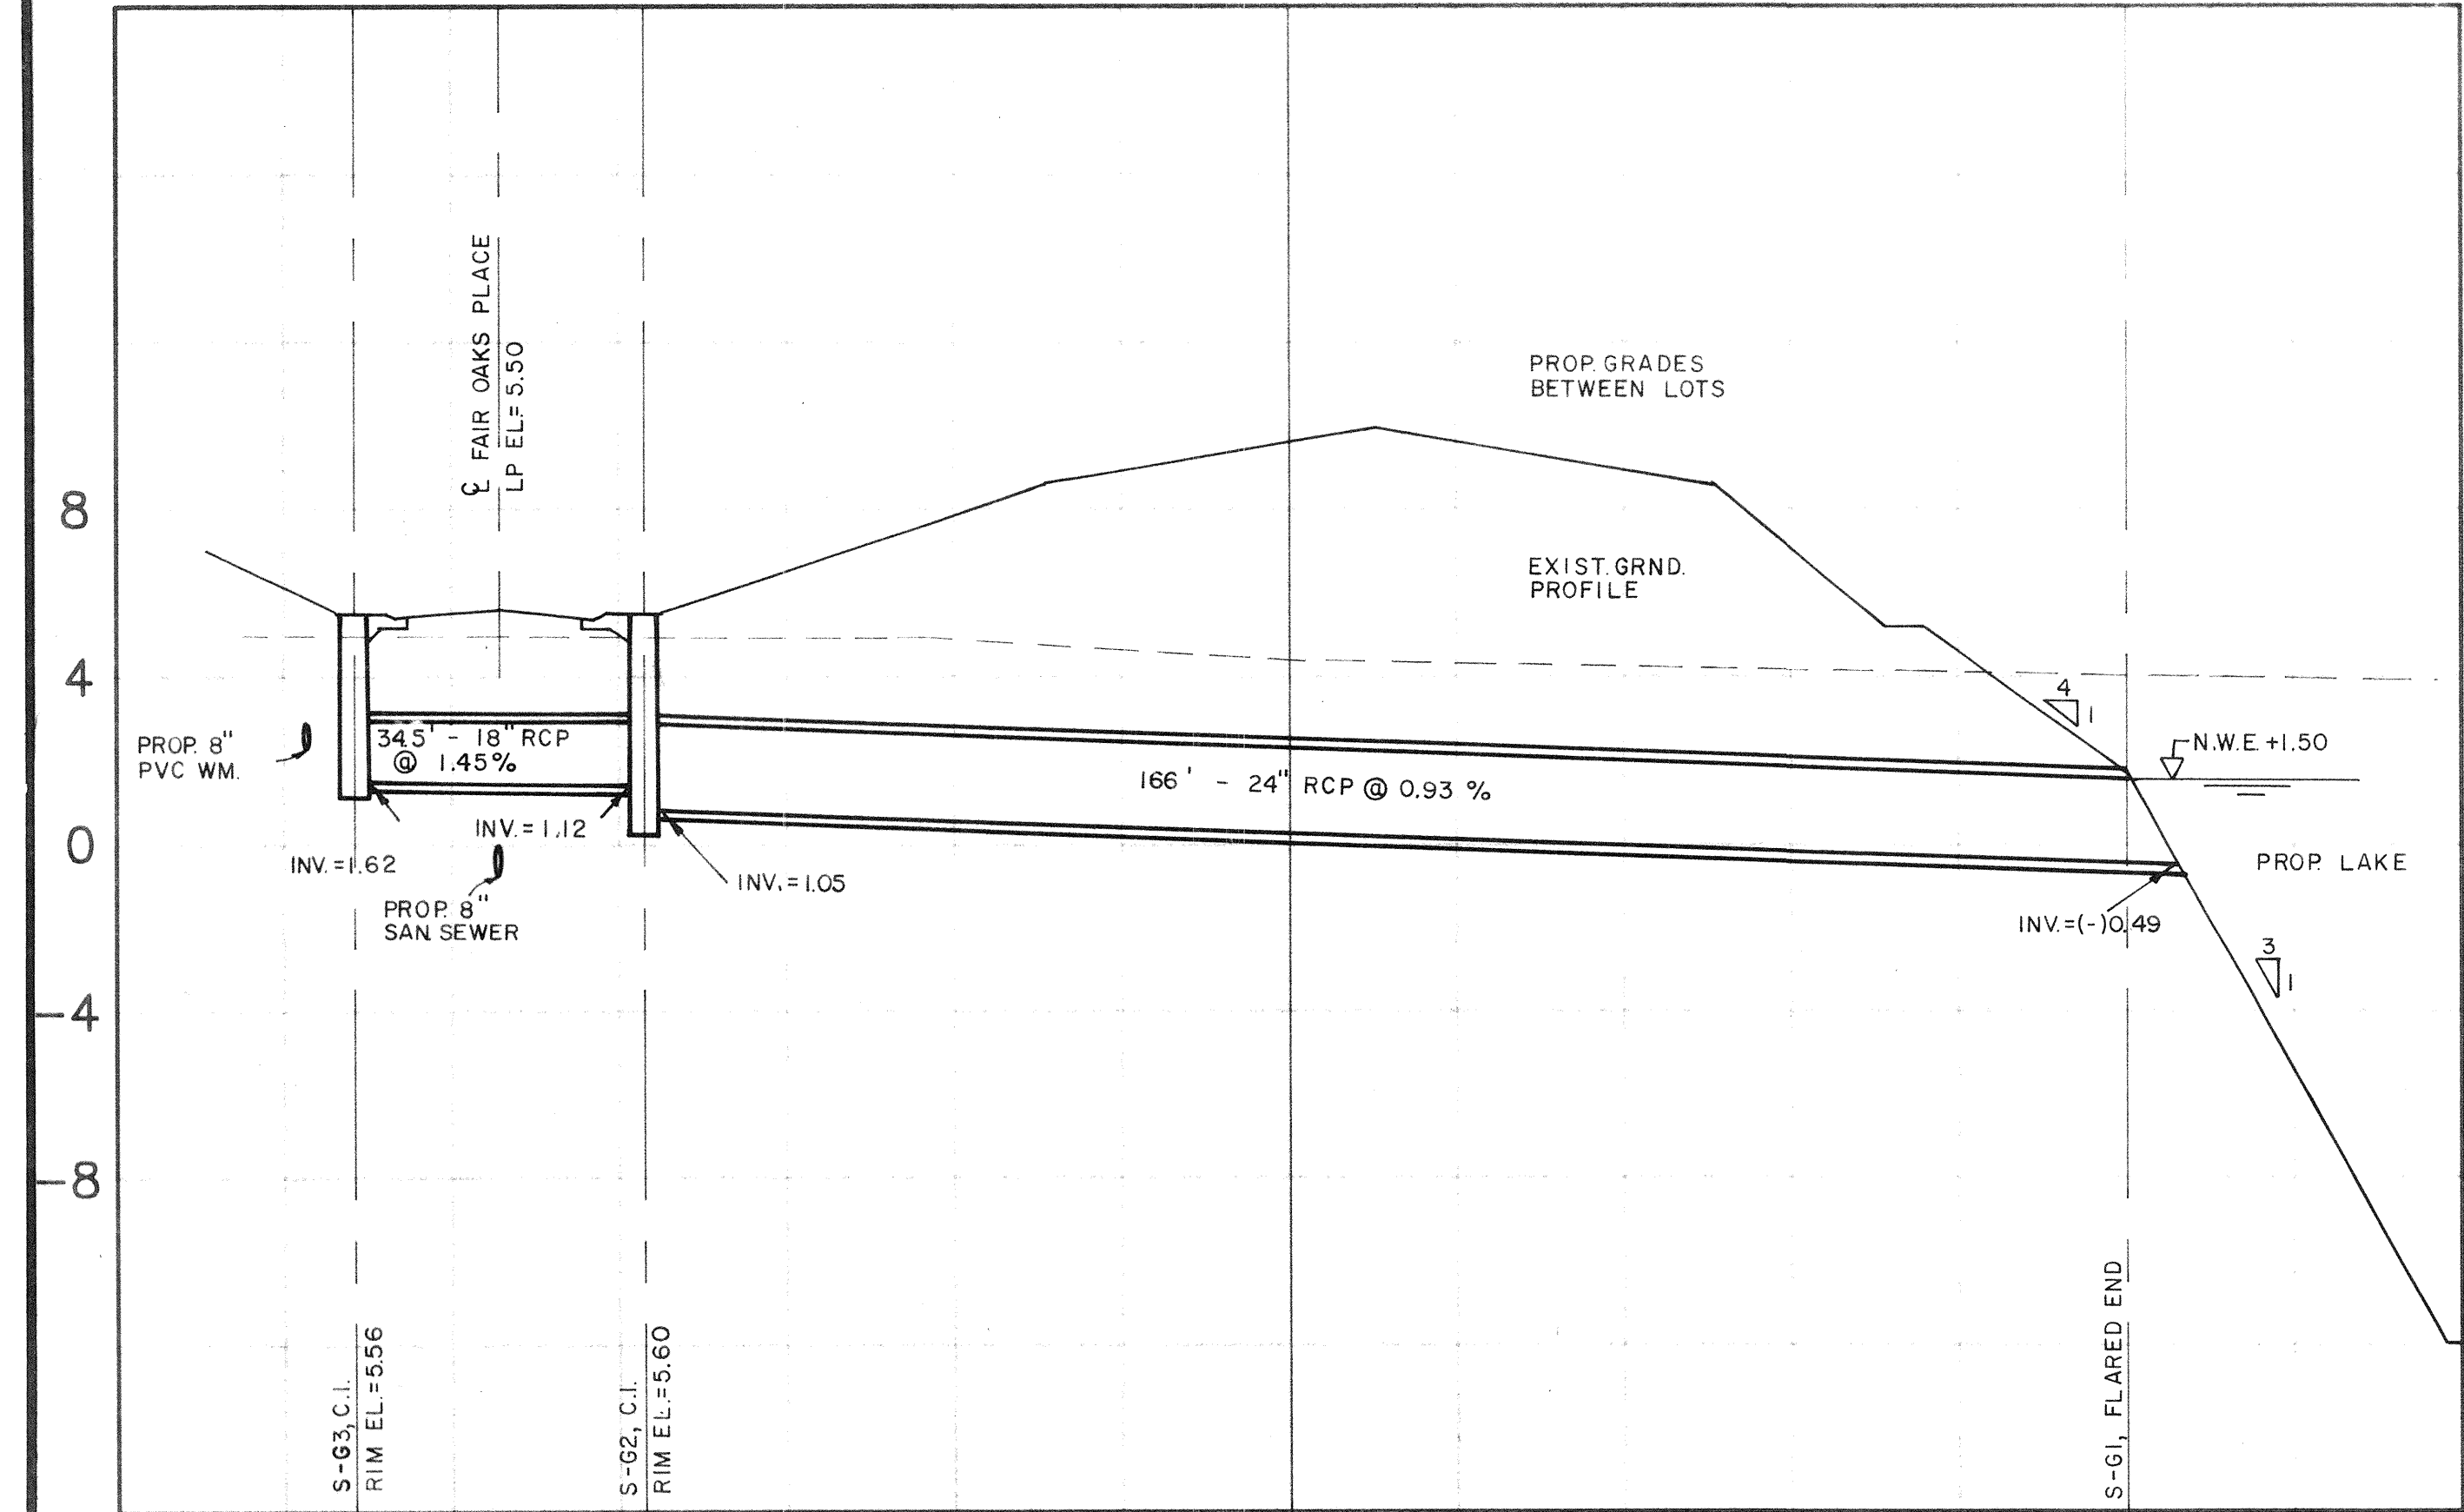

DESIGNED BY	DATE	SCALE	BY	REVISION	L.T.R.	DATE	PROJECT ENGINEER
S.R.	9-8-89	1" = 20'					
CHECKED BY	PP/CJ/SR	DRAWN BY	R.W.C.				
PROJECT NO.	DBDS-0018						
Ph	(813) 371-6362						
78 Sarasota Center Blvd.	Sarasota, Florida 34240						
TOWN OF LONGBOAT KEY, FLORIDA							
MANCHESTER BAY							
DIAMOND — CARVER, INC.							
AS-BUILT/RECORD DRAWING OF STORM SEWER							
BISHOP & ASSOCIATES, INC. CONSULTING ENGINEERS • SURVEYORS							
SHEET NUMBER							
15 RD							
REVISION							
K. FILE NO.							