
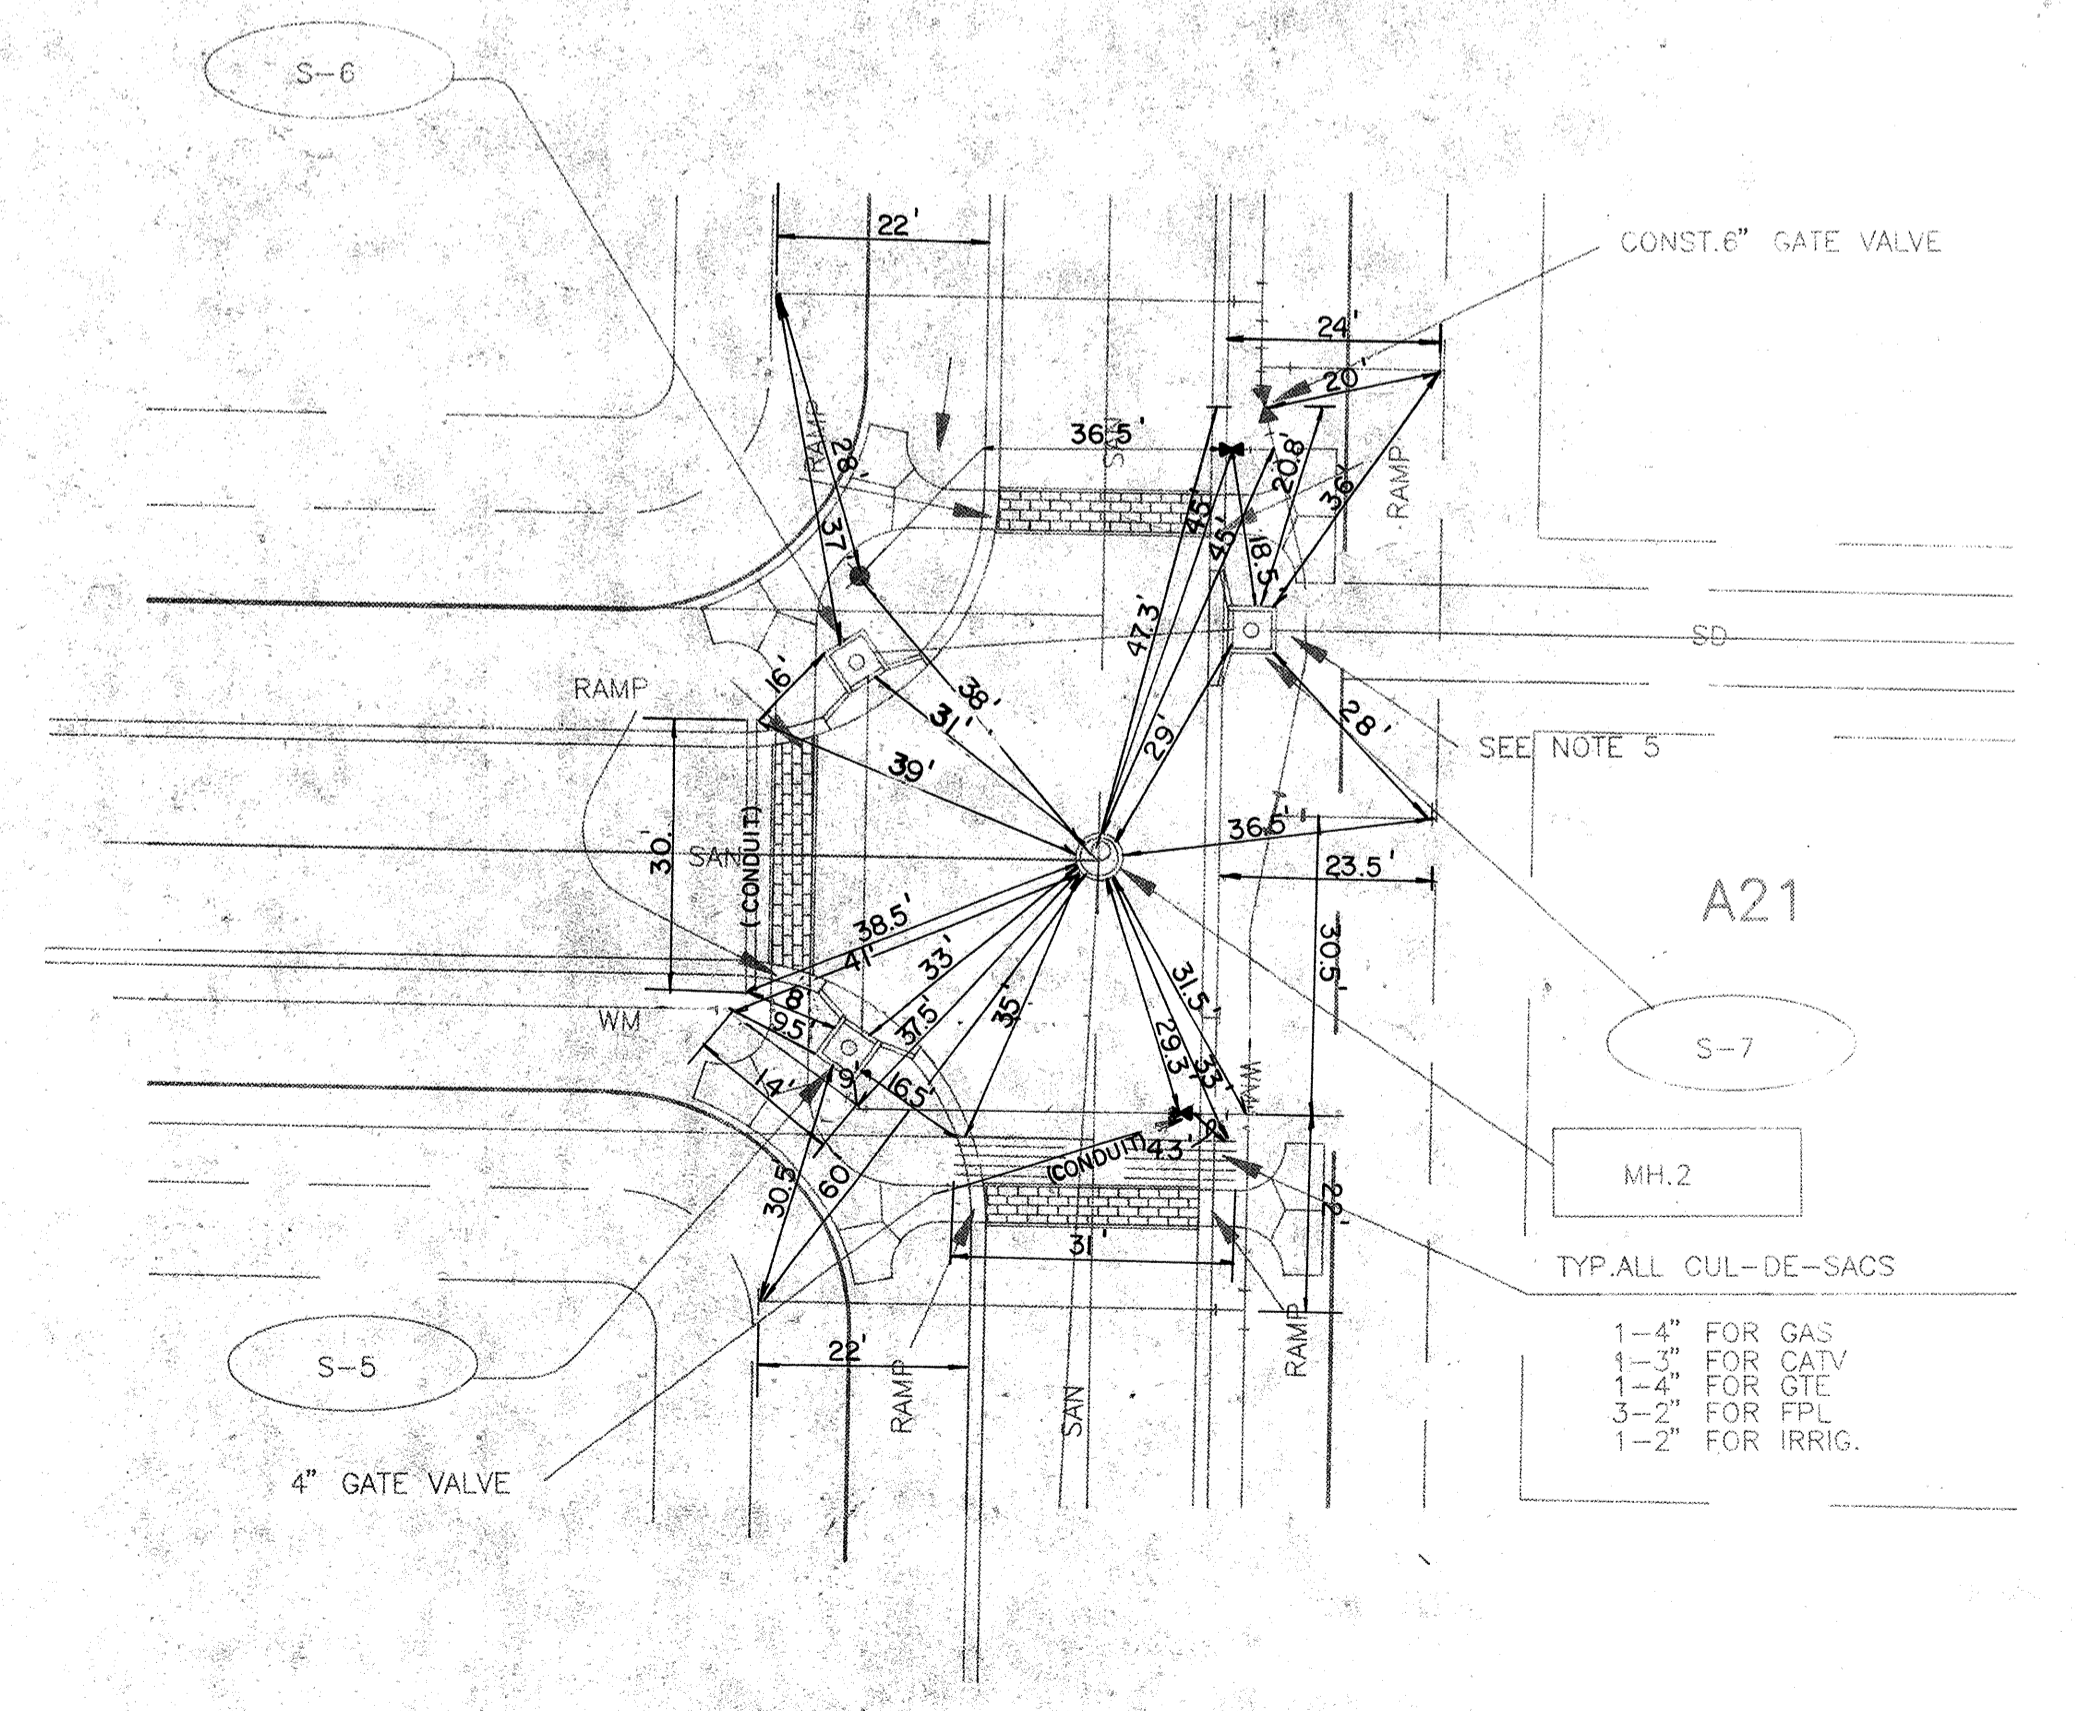
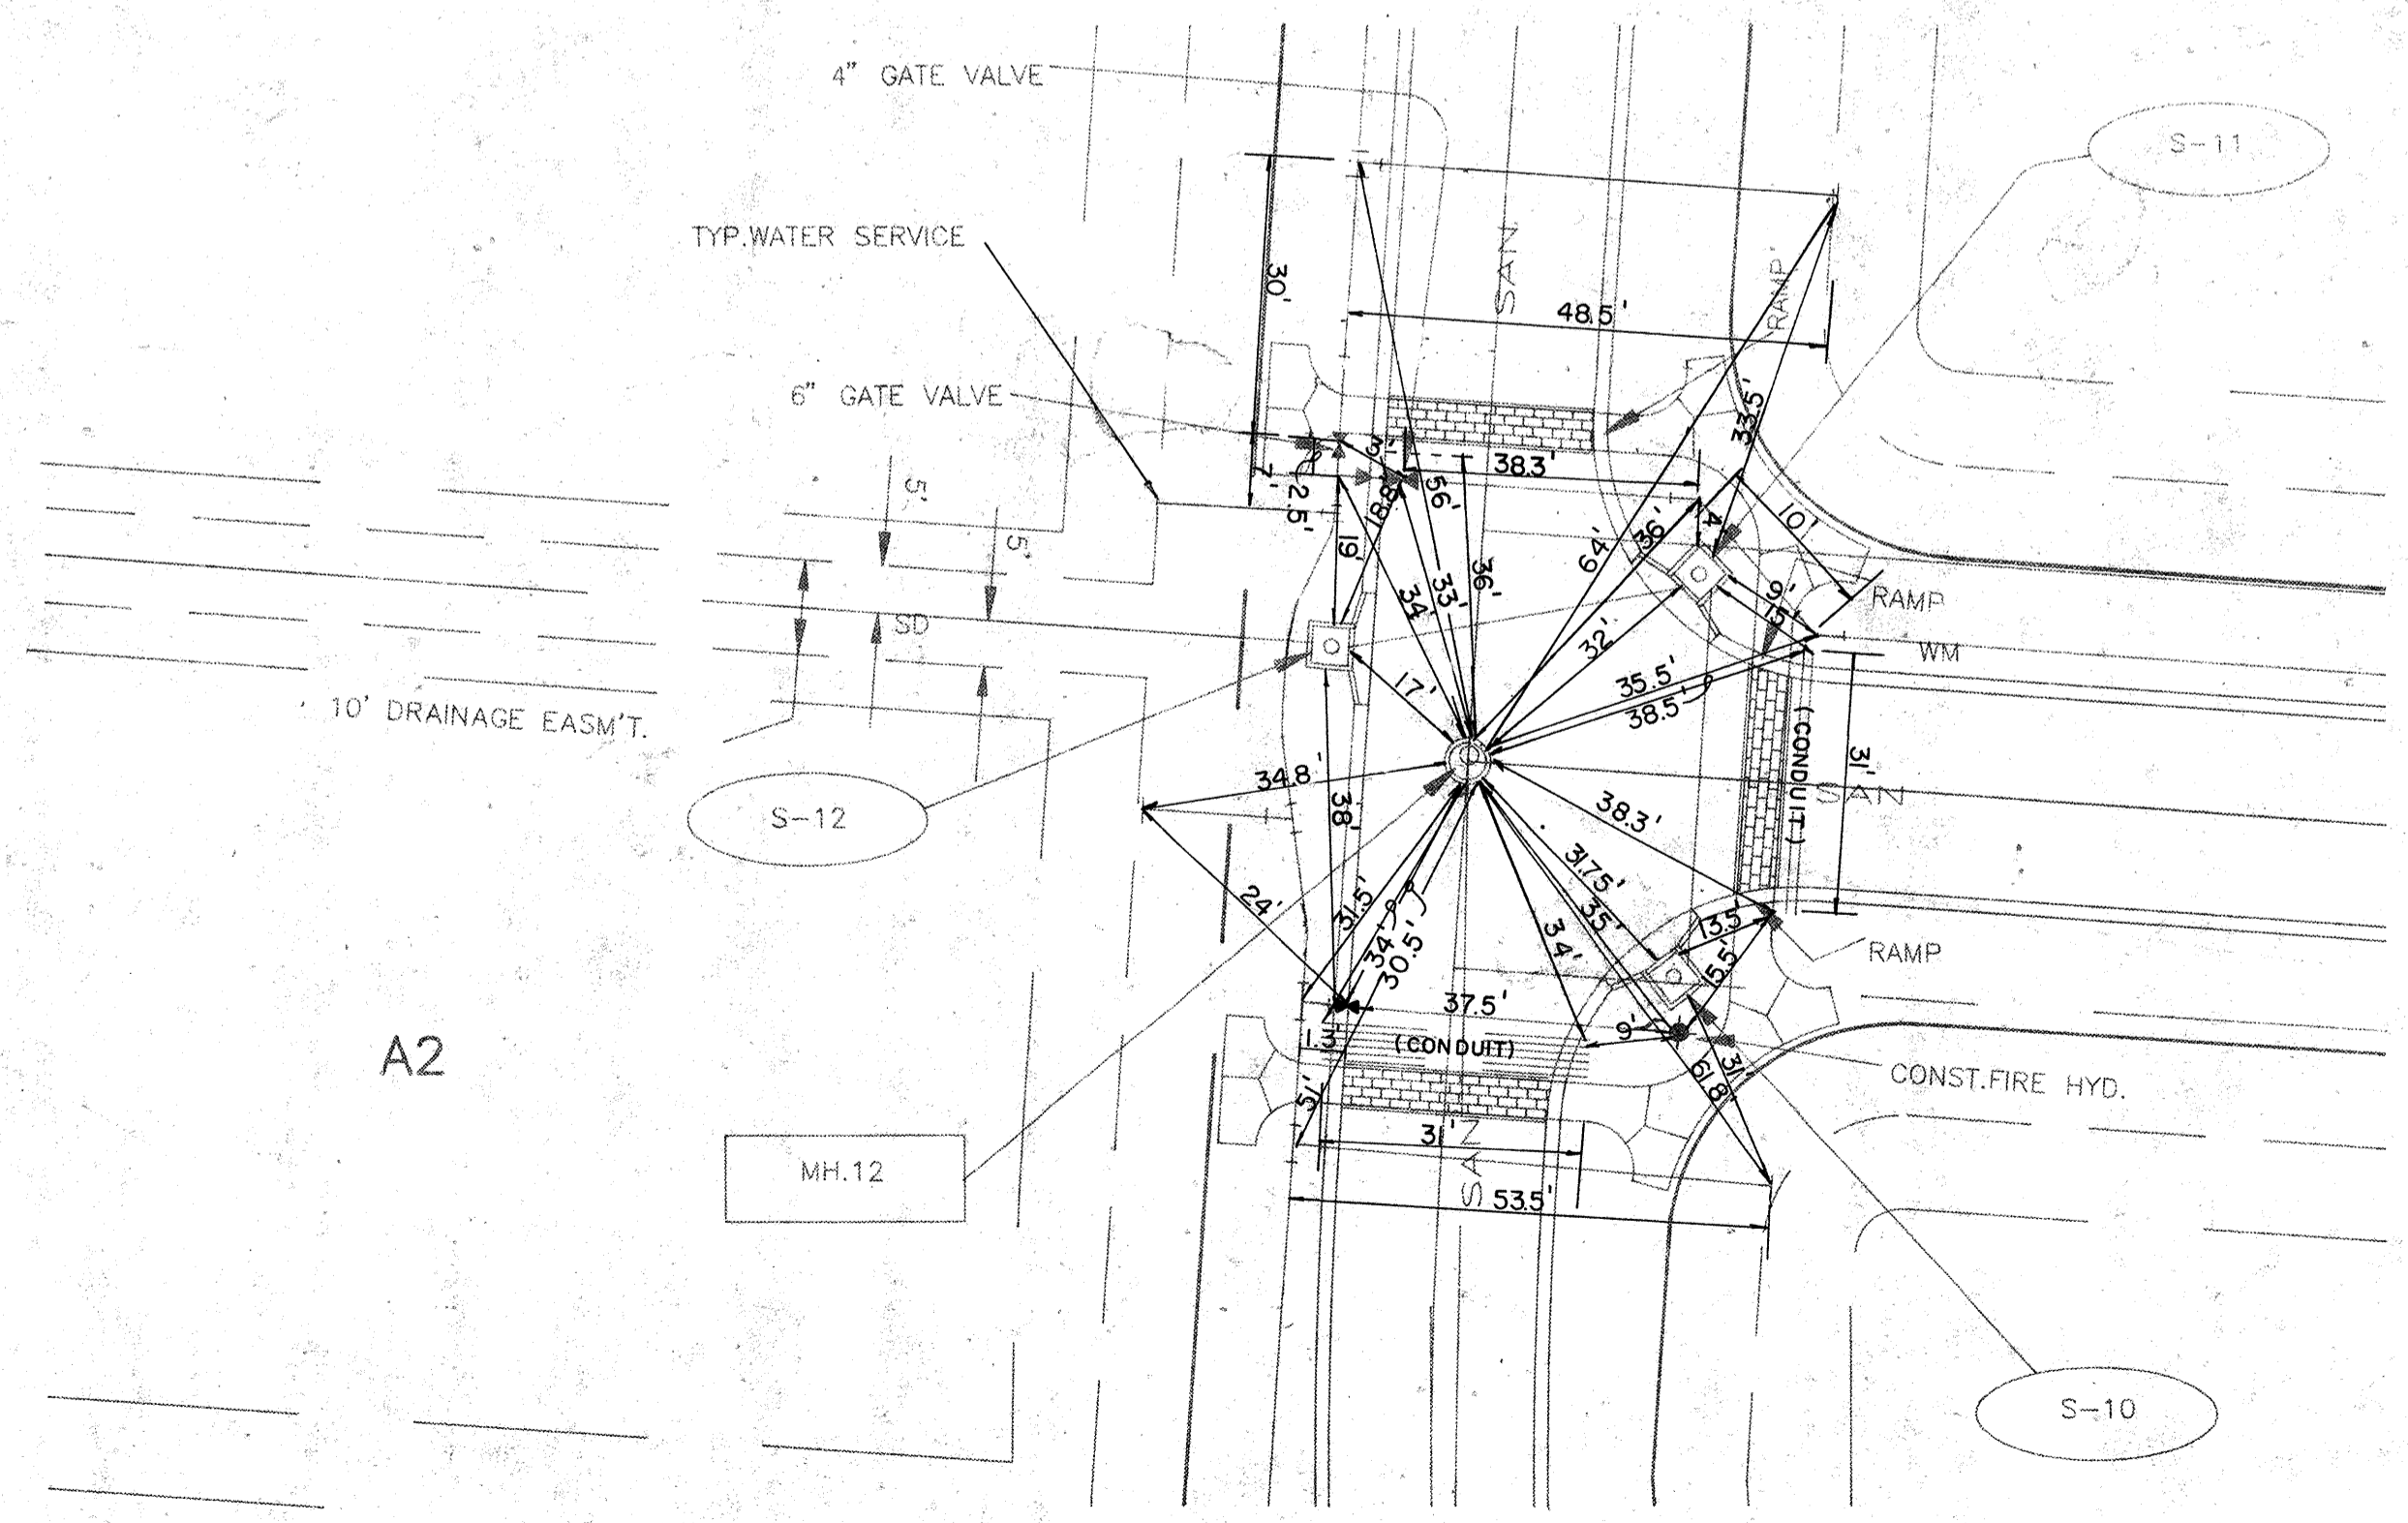
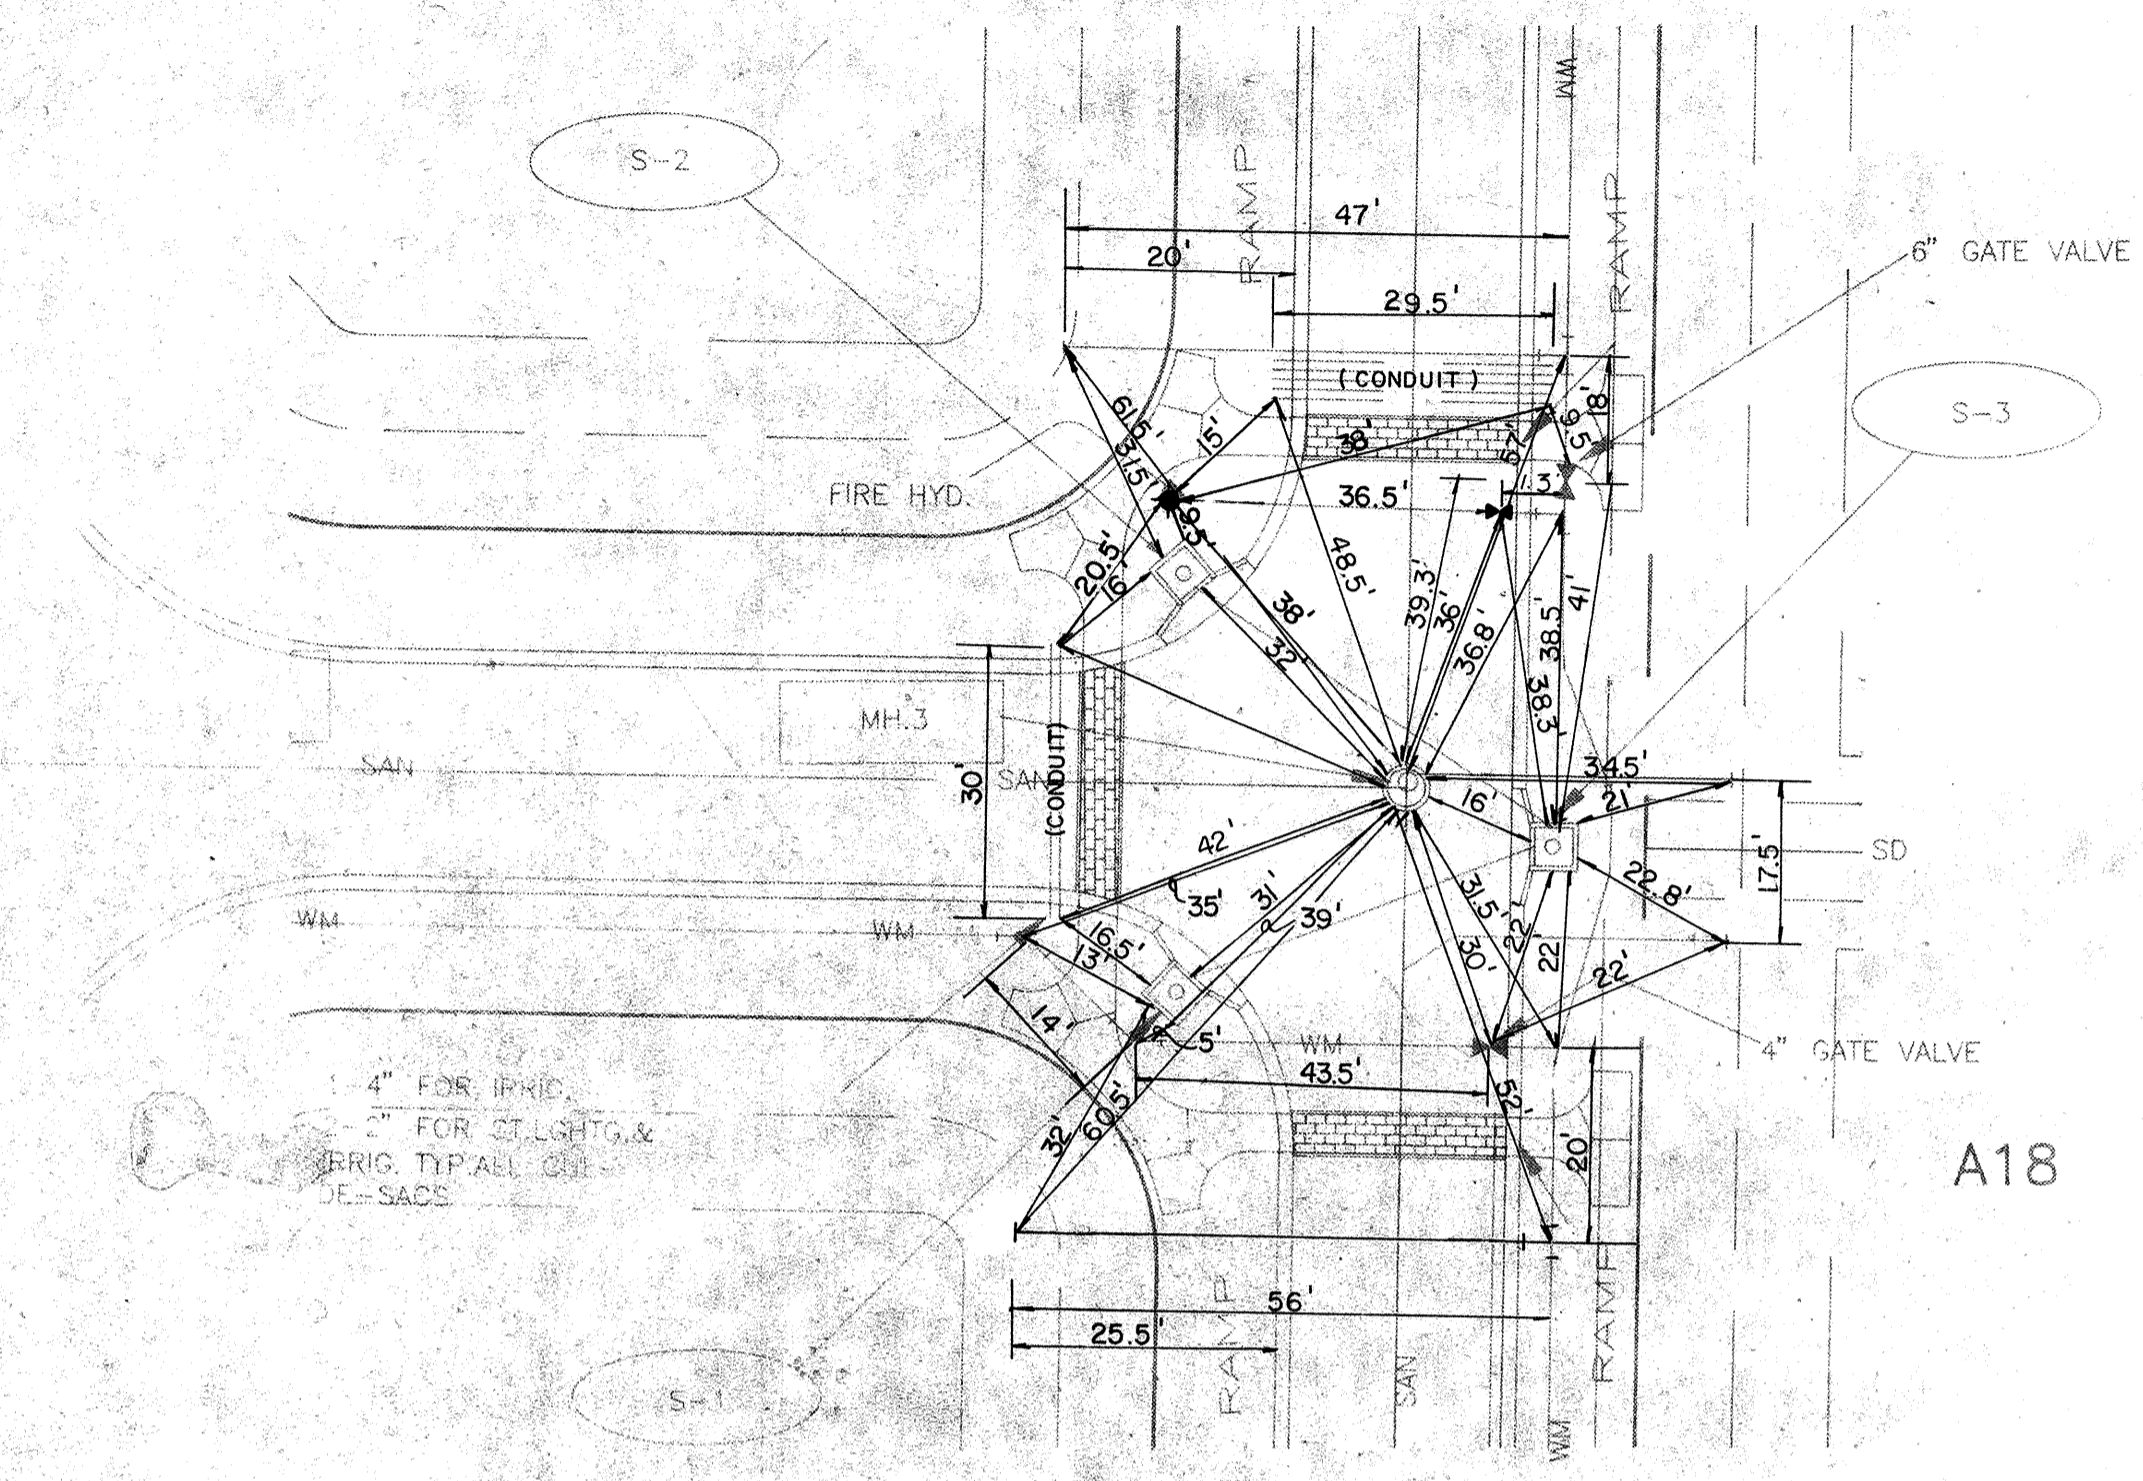


LEGEND	
EXIST. SANITARY MH.	
EXIST. SANITARY SEWER	
EXIST. FORCE MAIN	
EXIST. STORM DRAIN	
EXIST. CURB INLET	
EXIST. WATER MAIN w/ HYD.	
EXIST. FIRE MAIN w/ SIAMEEZ CONNECTION	
EXIST. BURIED ELECTRIC	
EXIST. GAS MAIN	
EXIST. BURIED TV CABLE	

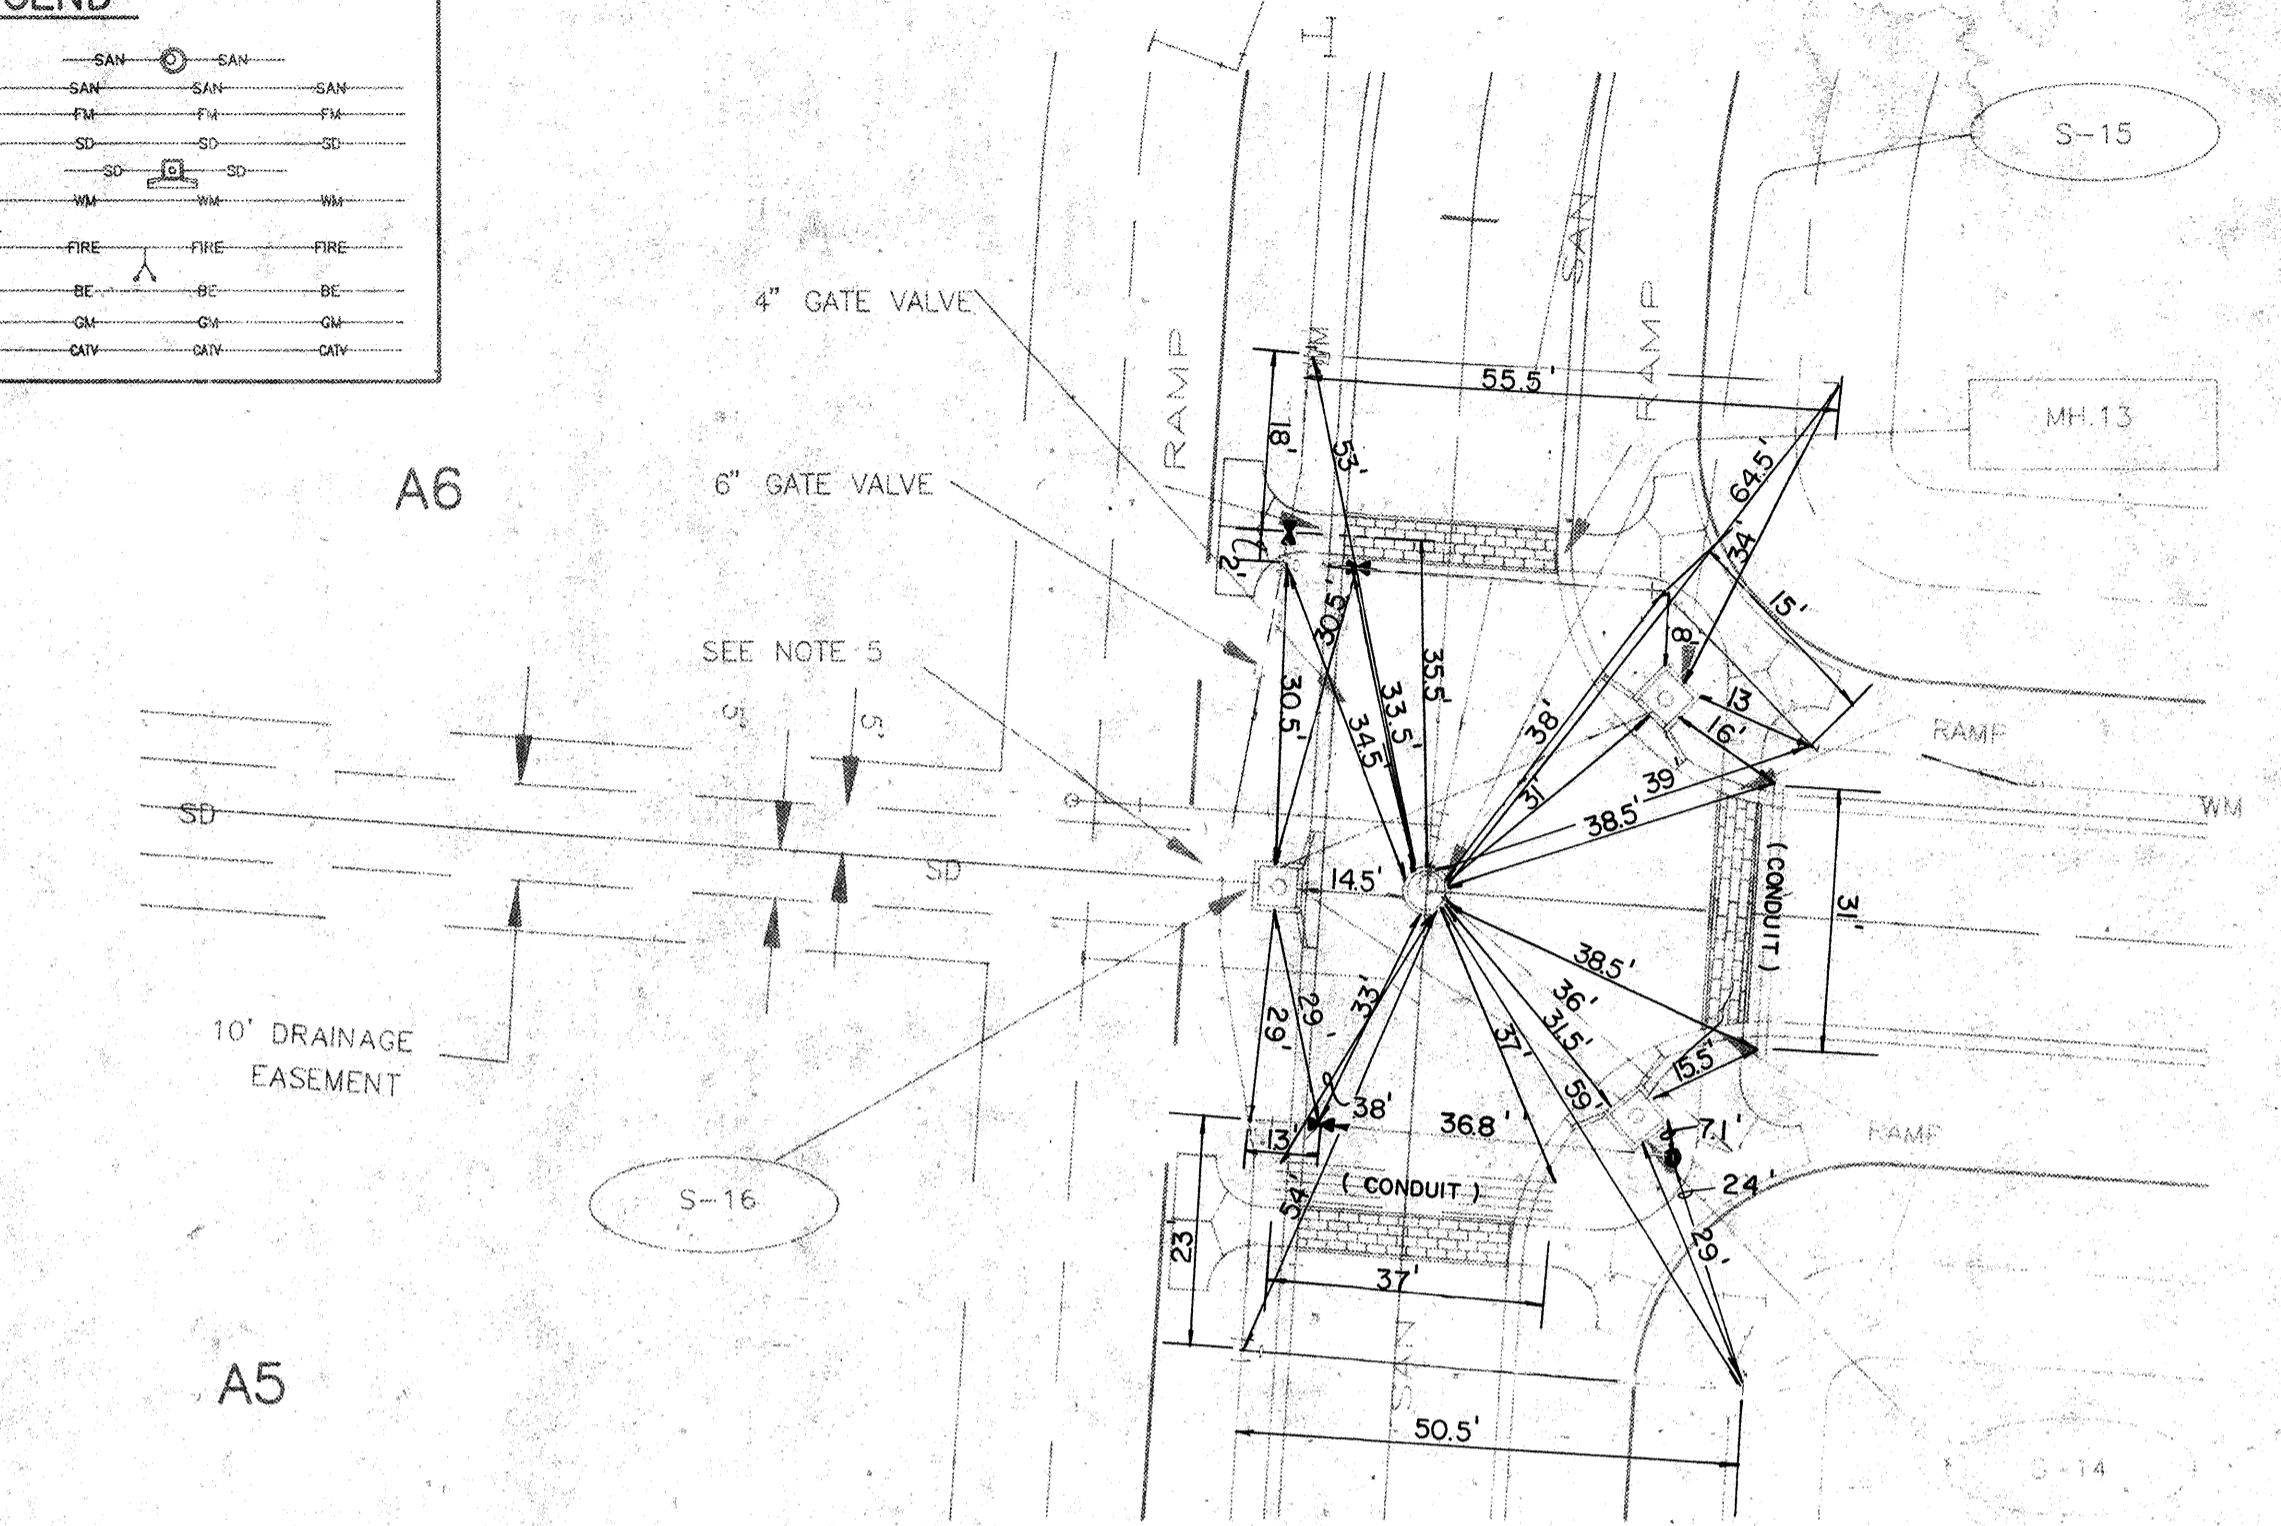

NOTE: SEE SHEET 1 of 3 FOR ADDITIONAL TIES AT INTERSECTIONS.

TOWN OF LONGBOAT KEY, FLORIDA		SABAL COVE		ARVIDA / JMB PARTNERS, INC.		RECORD DRAWING	
PROJECT ENGINEER	DESIGNED BY	DATE:	2/06/89	BY	REVISION	LTR.	DATE
WILLIAM F. BISHOP	S.E./E.L.C.	SCALE:	1"=20'	BY			
PE No. 8189	PROJECT NO.	DRAWN BY	R.W.C./T.D.	BY			
	ARVD-0478	CHECKED BY		BY			
		DATE:		BY			
		SCALE:		BY			
		DRAWN BY		BY			
		CHECKED BY		BY			
		DATE:		BY			
		SCALE:		BY			
		DRAWN BY		BY			
		CHECKED BY		BY			
		DATE:		BY			