


PLAN
SCALE: 1"=20'

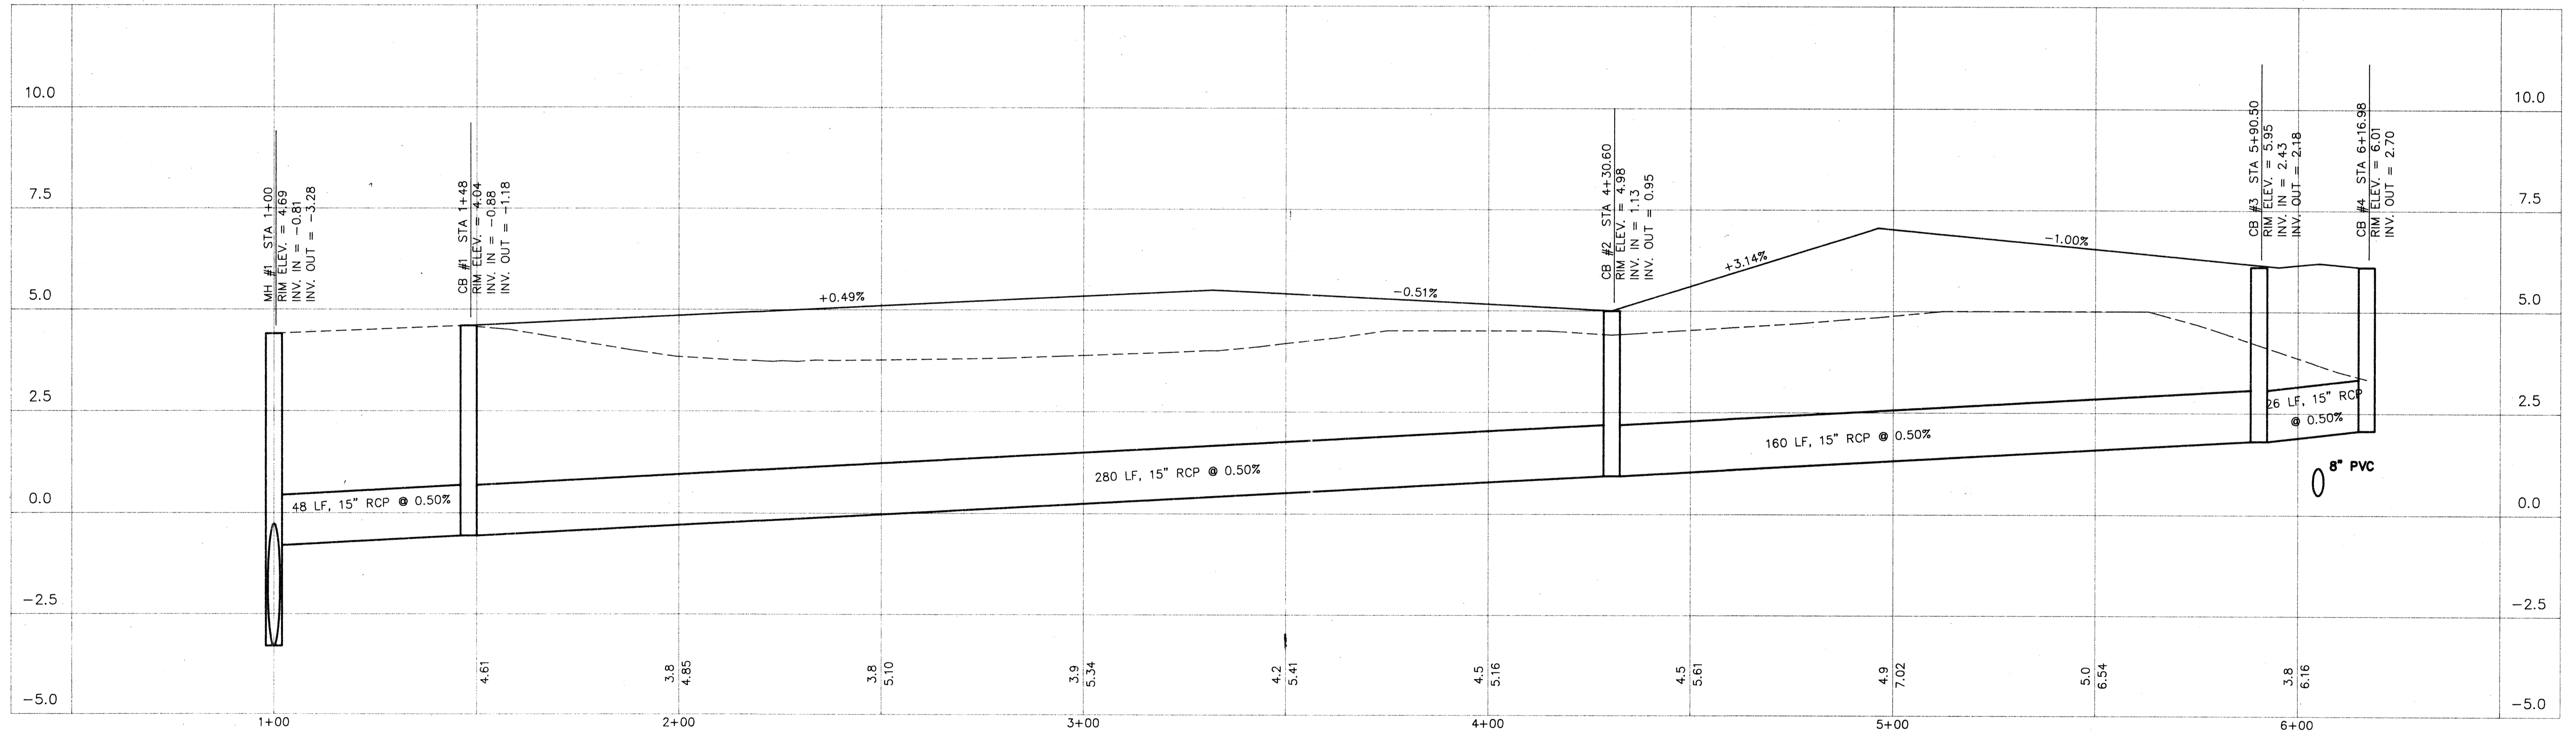

PROFILE
SCALE: HORIZ.: 1"=20'
VERT.: 1"=2'

OWNER GEORGIAN PROPERTIES, LTD. WESTHILL FARM JURBY ROAD RAMSY, ISLE OF MAN	PROJECT NAME WESTON POINTE LONGBOAT KEY, FLORIDA STORM DRAIN PLAN/PROFILE-RECORD DRAWING	NORTH 	SHEET 7	REVISIONS	MINDER & RHODES ENGINEERING CORPORATION Engineers - Planners - Surveyors 3900 CLARK ROAD SARASOTA, FL. 34233 (813) 922-7848 Approved: P.E. No. 33150 Date: 8/20/92 Designed M&R Drawn AJR Checked Scale 1"=20' Approved Date 8/20/92
--	--	-----------	-------------------	-----------	--