



PLAN
SCALE: 1"=20'

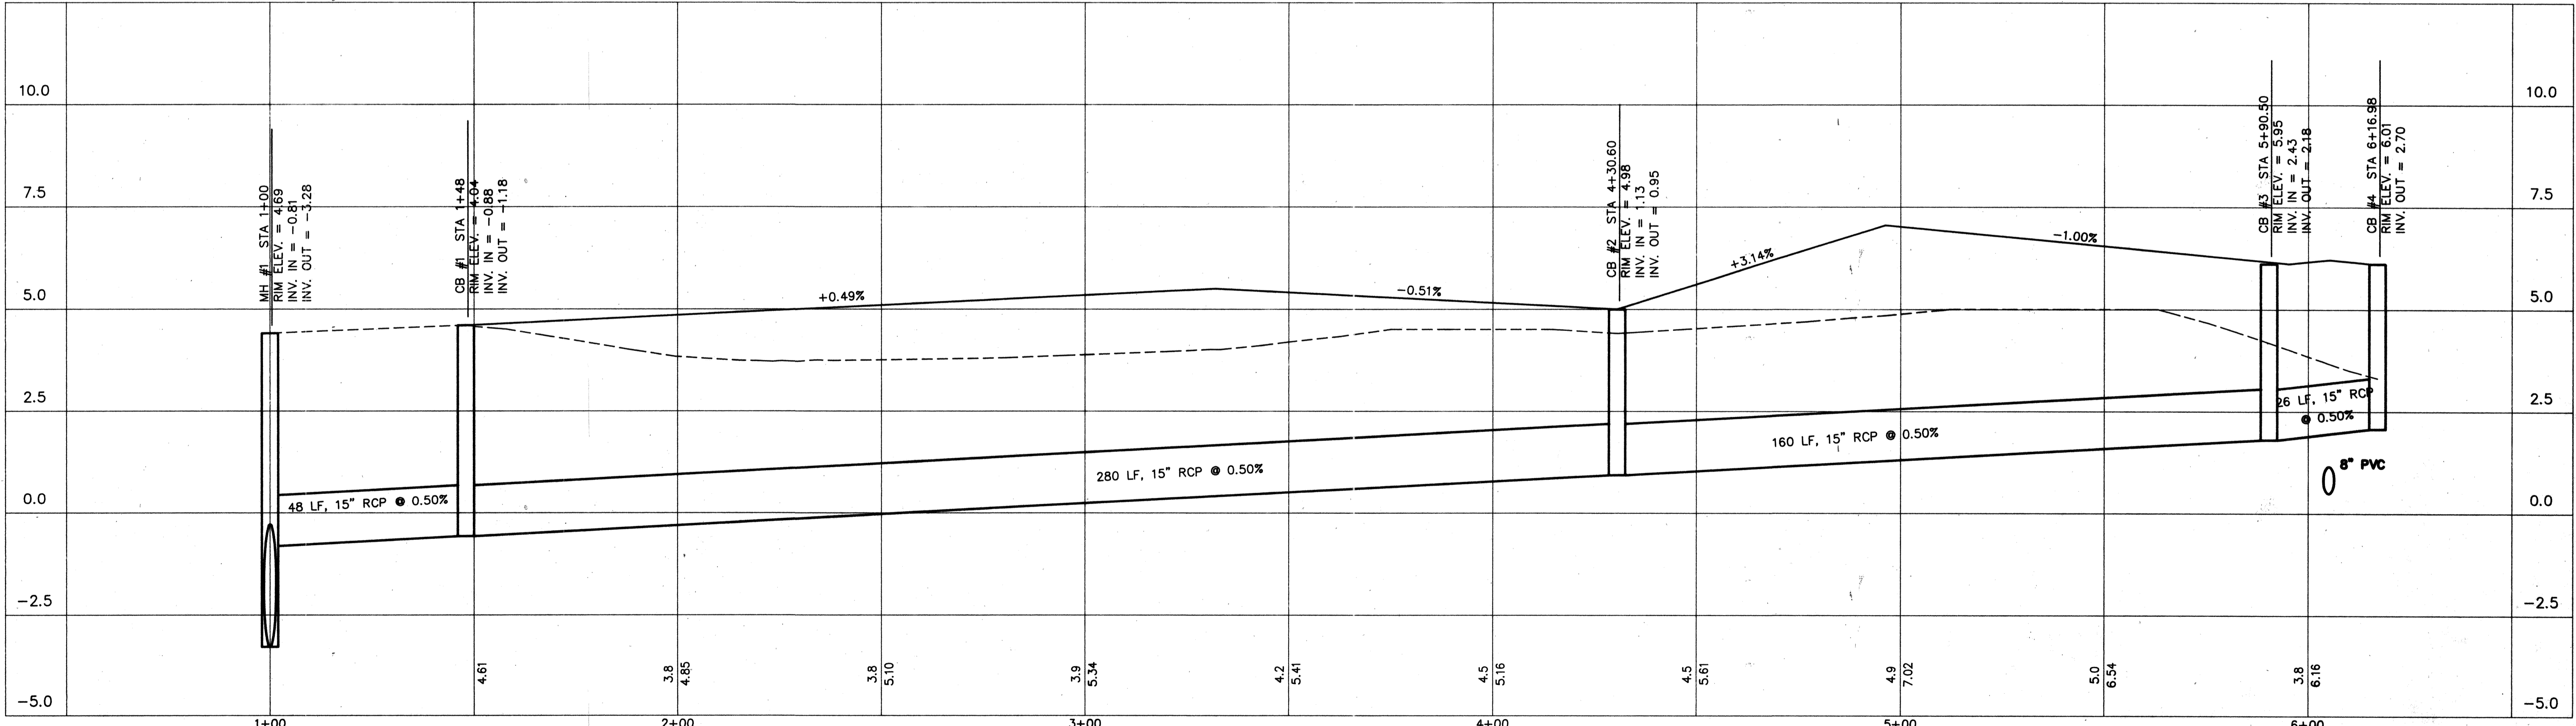

PROFILE
SCALE: HORIZ.: 1"=20'
VERT.: 1"=2'

OWNER GEORGIAN PROPERTIES, LTD. WESTHILL FARM JURBY ROAD RAMSY, ISLE OF MAN	PROJECT NAME WESTON POINTE LONGBOAT KEY, FLORIDA STORM DRAIN PLAN/PROFILE-RECORD DRAWING
--	--

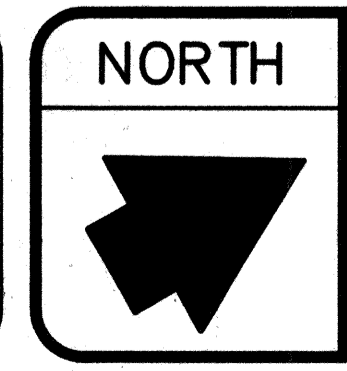

SHEET
7

REVISIONS			
NO.	DATE	DESCRIPTION	BY
1	4/3/93	ADDED RECORD DRAWING INFORMATION	DBH

MINDER & RHODES ENGINEERING CORPORATION
Engineers - Planners - Surveyors
3900 CLARK ROAD
SARASOTA, FL, 34233
(813) 922-7744

APPROVED
[Signature]
P.E. No. 33158
Date 12/18/93
Prj. No. S1088
CAD DWG. S1088PR3

Designed M&R
Checked Scale 1"=20'
Approved Date 8/20/92