
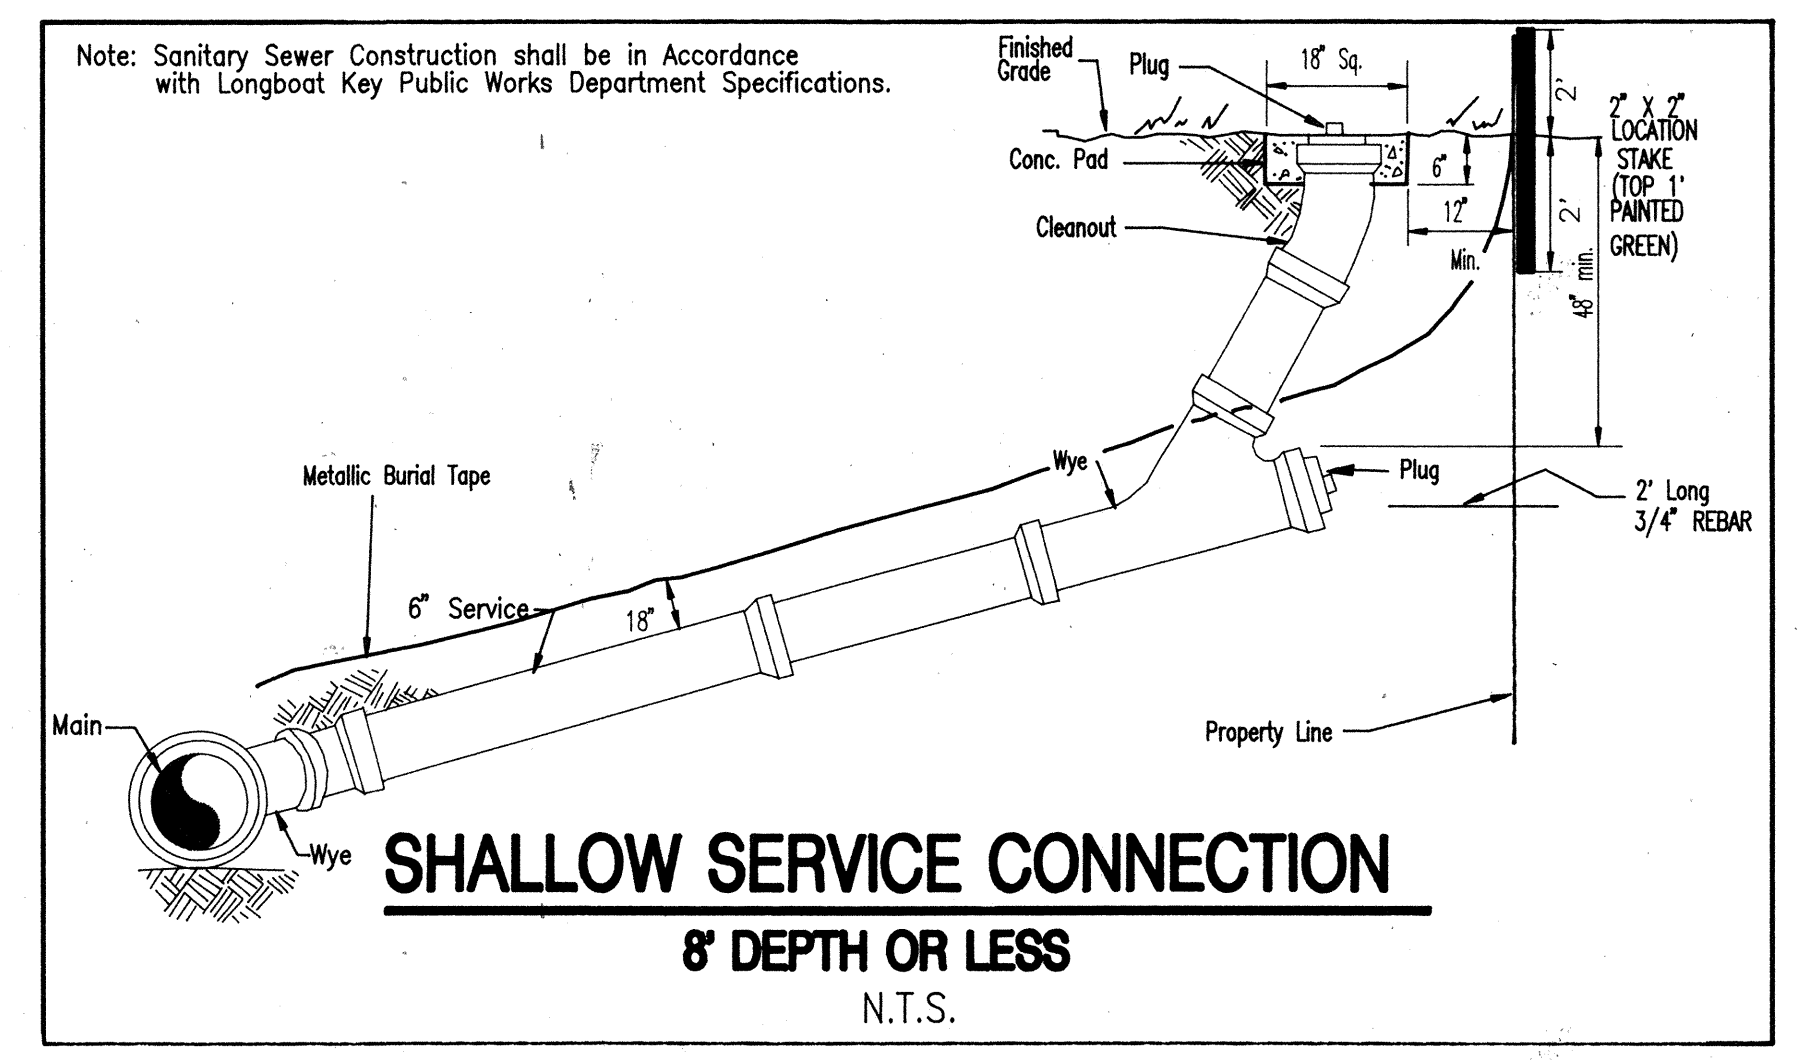
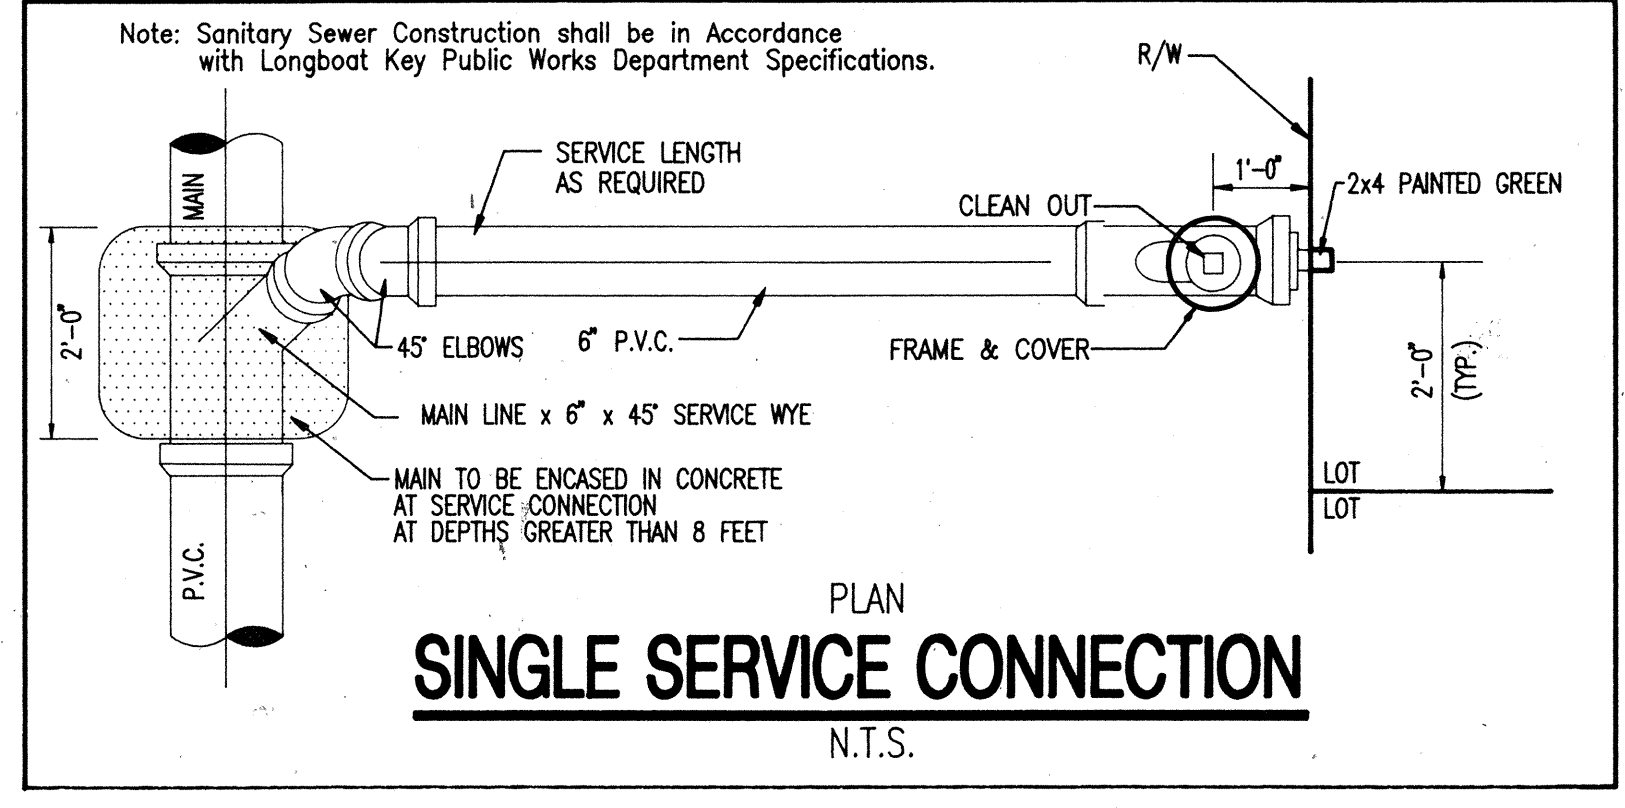


NOTE: ALL APPLICABLE DETAILS SHALL BE IN ACCORDANCE WITH LONGBOAT KEY STANDARDS AND SPECIFICATIONS OR AS NOTED.

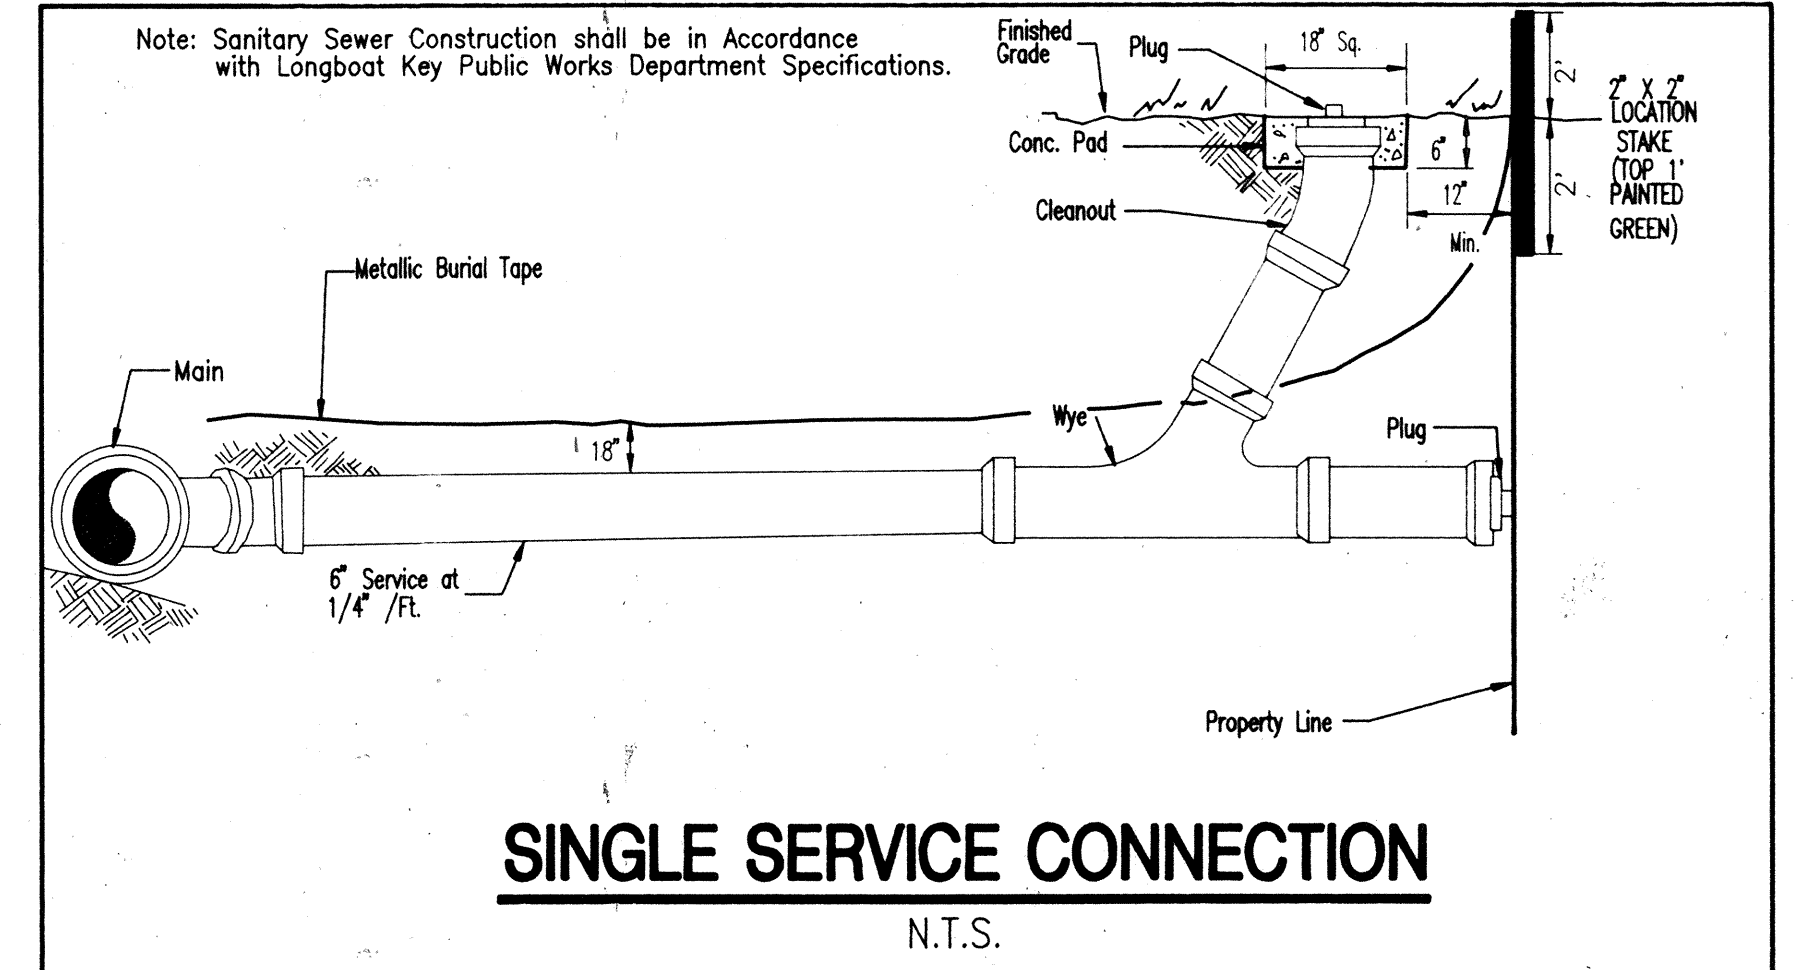

APPROVED

MINDER & RHODES ENGINEERING CORPORATION

Engineers - Planners - Surveyors

3900 CLARK ROAD
SARASOTA, FL 34233

Desig. MBH Checked N/A Scale N/A Date 07/30/92

Drawn DBH Scale N/A Date 07/30/92

P.E. No. 33150
Date 1/2/92
P.I. No. ST088
CAD DWG. S1088UD

MAR

REVISIONS

No.	Date	Descriptions	By
1	10/1/92	REVISE PER CON. OF LONGBOAT KEY REVIEW	MBH

WESTON POINTE
LONGBOAT KEY

SARASOTA COUNTY, FLORIDA

SANITARY SEWER COLLECTION SYSTEM DETAILS