


BAY ISLES RD.
SEE DWGS. 191-593AB
191-594AB

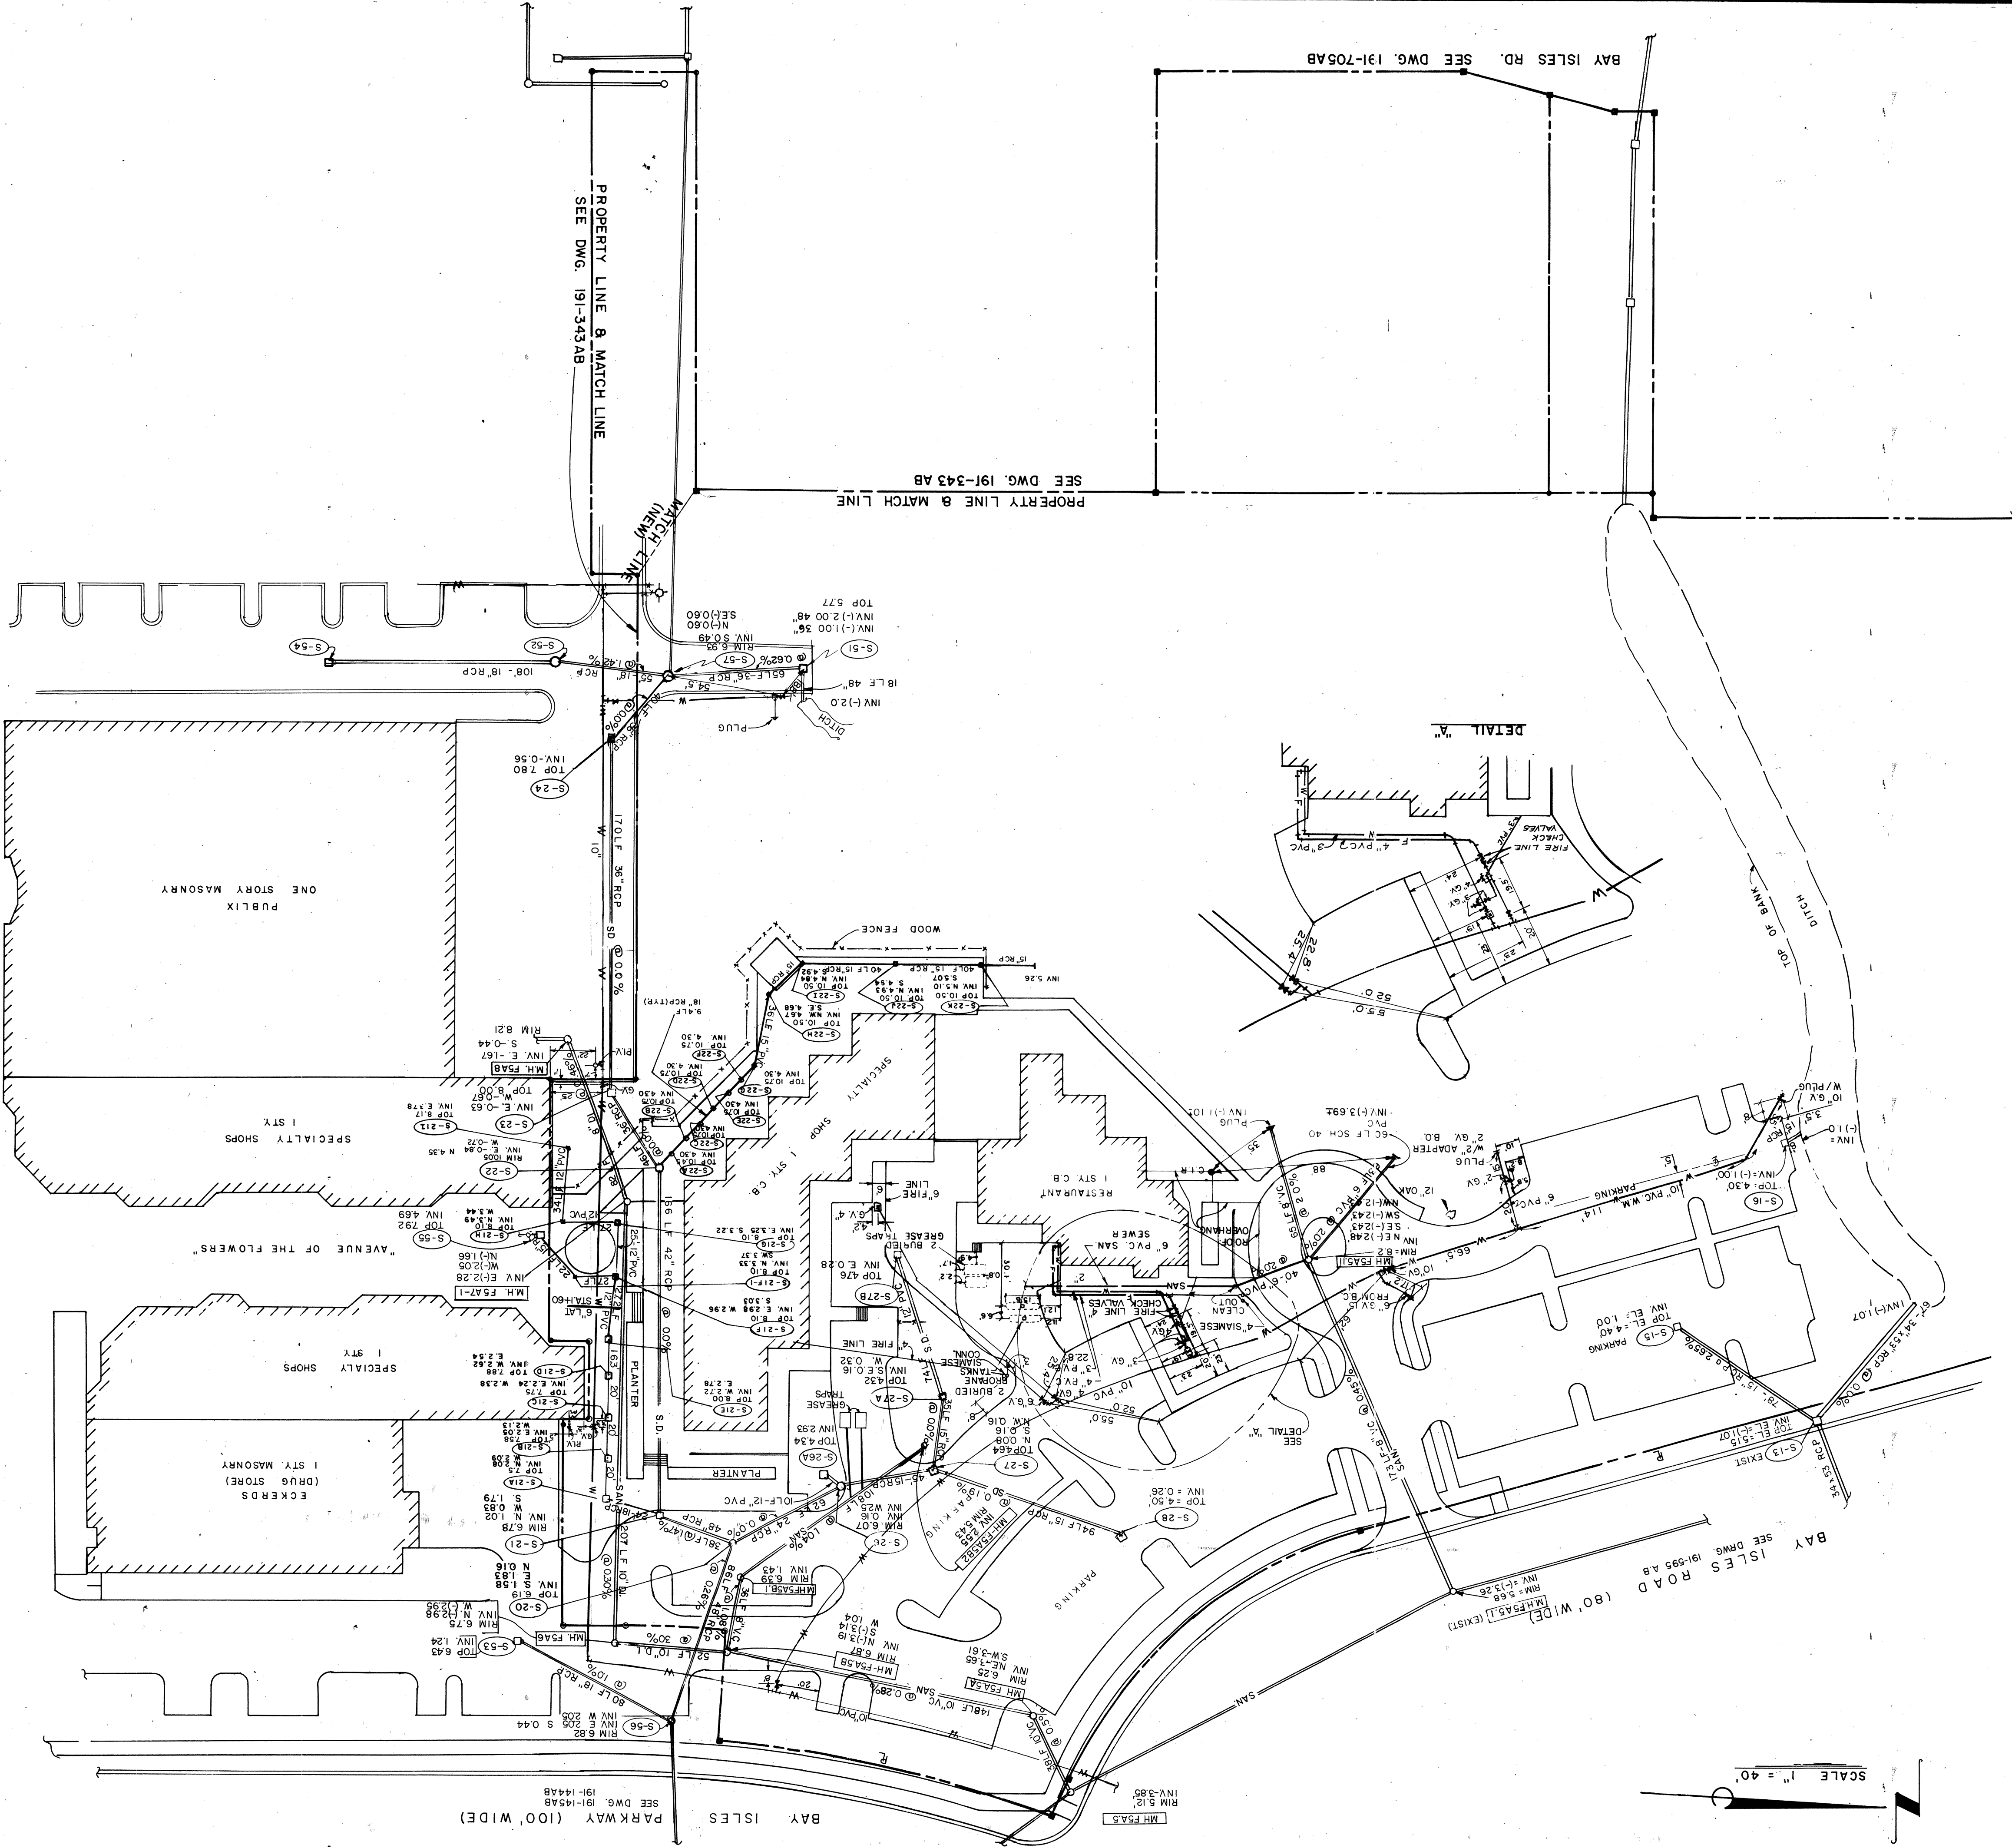

SCALE 1" = 40'

BAY ISLES PARKWAY (100' WIDE) SEE DWG. 191-145AB

PROPERTY LINE & MATCH LINE SEE DWG. 191-343 AB

BAY ISLES RD. SEE DWG. 191-705AB

PROPERTY LINE & MATCH LINE SEE DWG. 191-343AB

REVISION	DATE	BY	SCALE:	DESIGNED BY	PROJECT ENGINEER
1 of 2	4-8-88	W.P.	1" = 40'	WILLIAM F. BISHOP & ASSOCIATES, INC.	William F. Bishop
<p>TOWN OF LONGBOAT KEY, FLORIDA</p> <p>ARVIDA CORPORATION TOWN PLAZA - PHASE II WATER DISTRIBUTION & SEWAGE COLLECTION RECORD DRAWING</p> <p>ENGINEER'S LOCATION: WILLIAM F. BISHOP & ASSOCIATES, INC. CONSULTING ENGINEERS - SURVEYORS 78 SARASOTA CENTER BLVD., SARASOTA, FLORIDA 34240</p>					
<p>SHEET NUMBER: ARVD-0037</p> <p>TLK.K. FILE NO.</p>					