
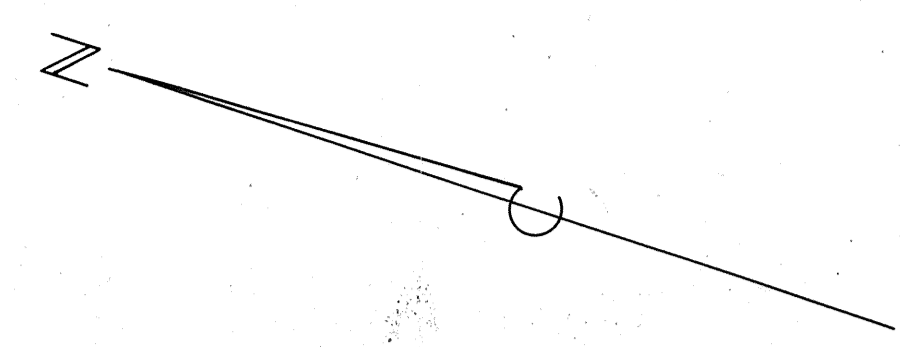


FOR BAY ISLES PARKWAY AS-BUILT
SEE SHEET 191-145AB

MATCH LINE
STA 30+00

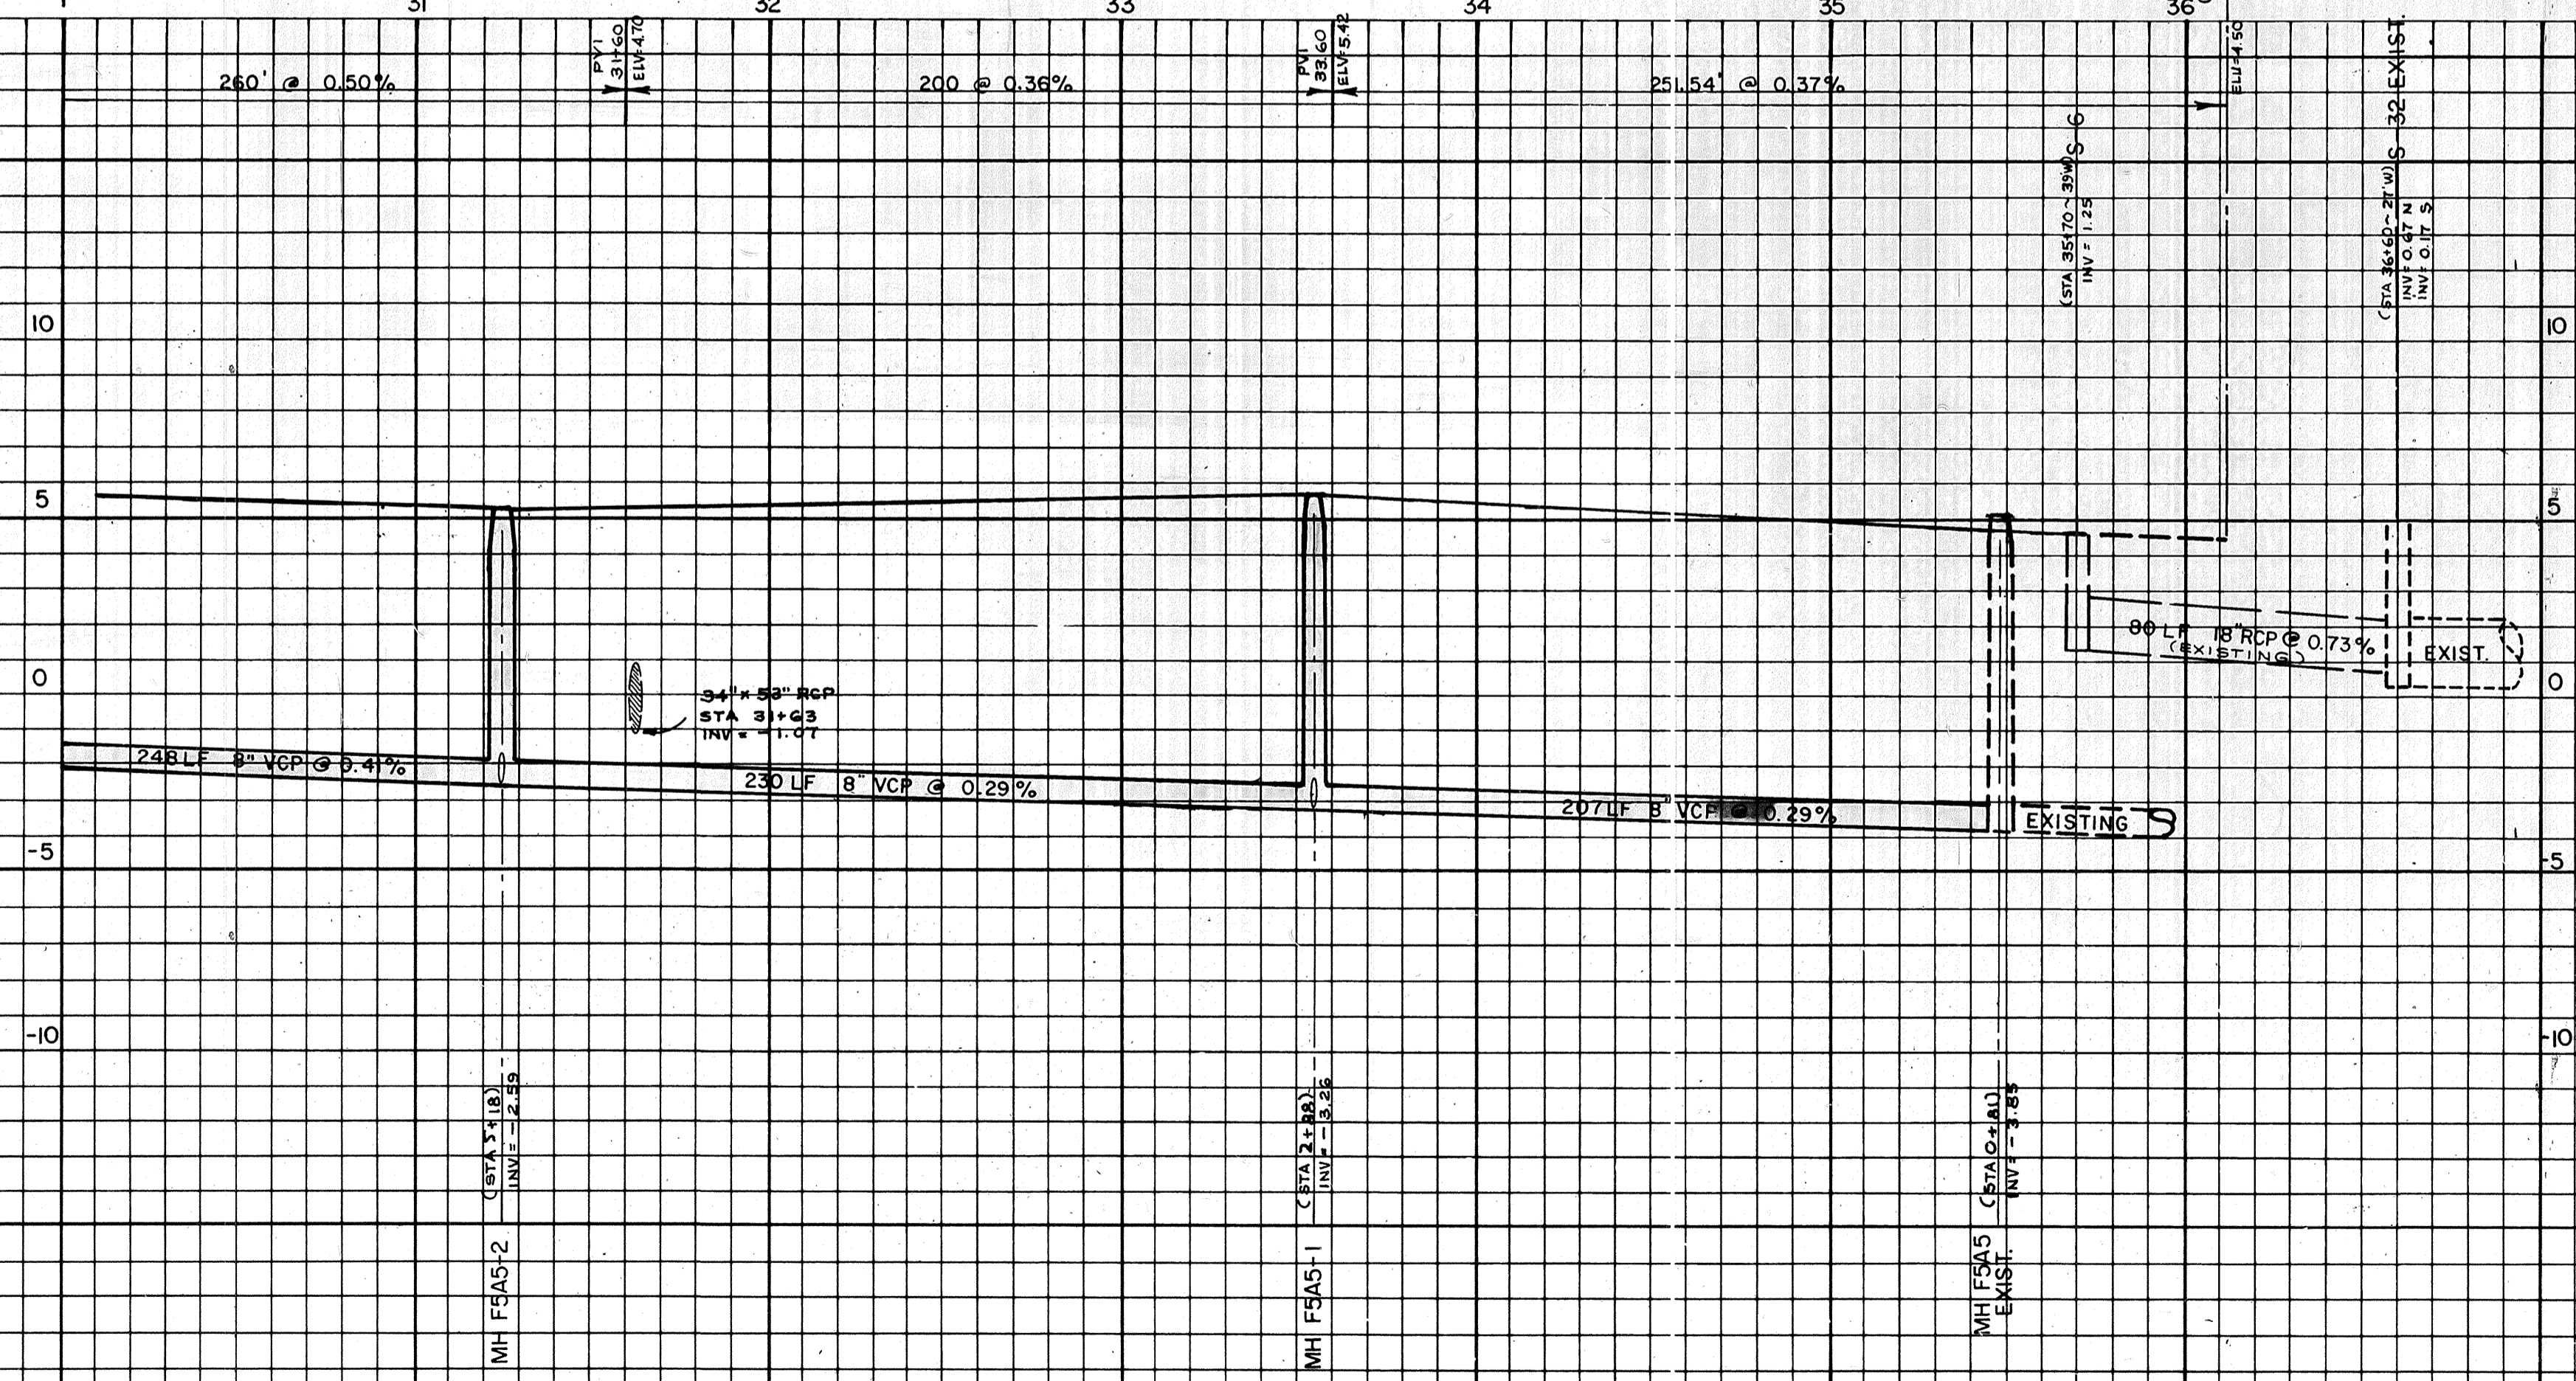

SHEET NUMBER 191-595AB	REVISION	L.T.R.	DATE	REVISION	BY	DESIGNED BY	PROJECT ENGINEER
						ARVIDA CORPORATION BAY ISLES ROAD	
ENGINEER & SURVEYORS		4509 BEE RIDGE ROAD		SARASOTA, FLORIDA		SCALE:	DATE:
BENNETT & BISHOP INC.		ENGINEERS & SURVEYORS		DRAWN BY		1" = 40' HORIZ. 1" = 4' VERT.	JAN. 1, 1983
T.L.K. FILE NO.				CHECKED BY		D. DALLAS	
				PROJECT NO.			