

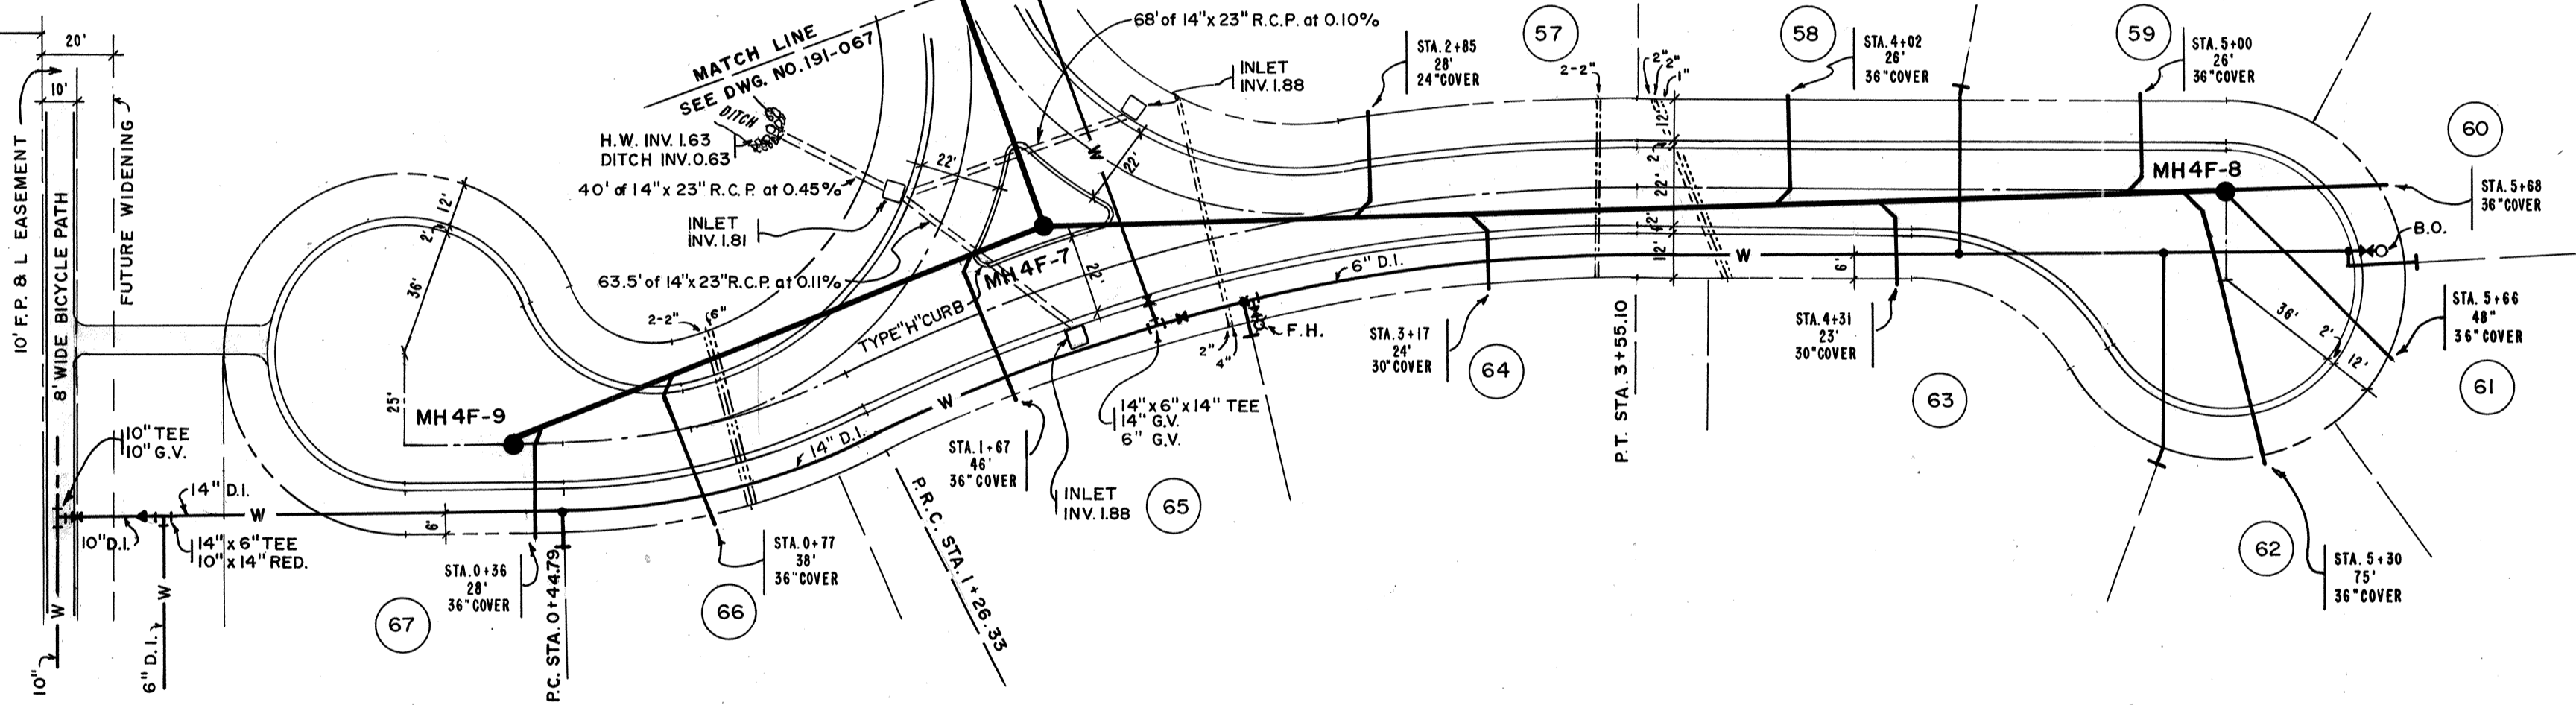


HARBOR POINT ROAD

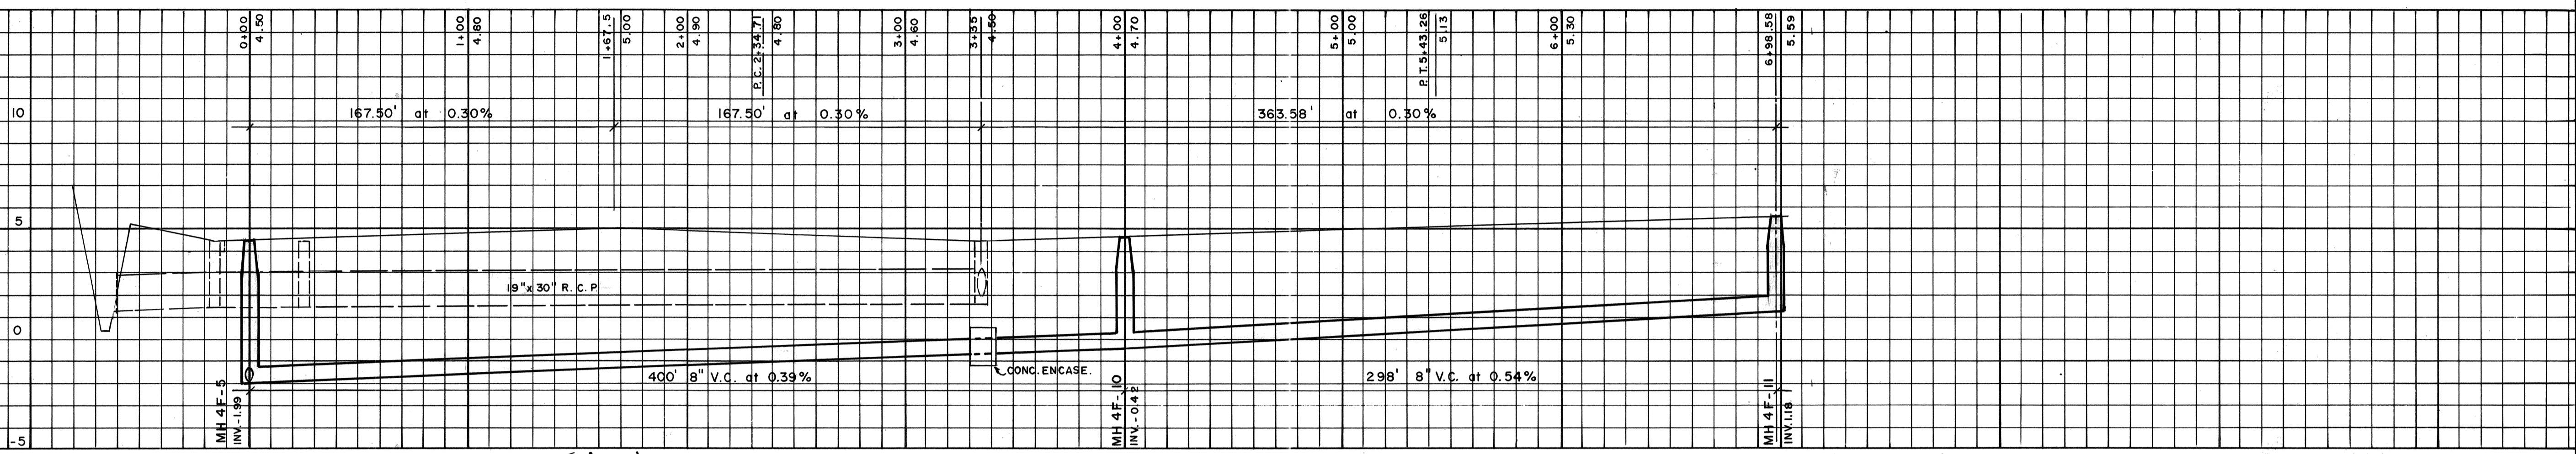

HARBOR COVE CIRCLE

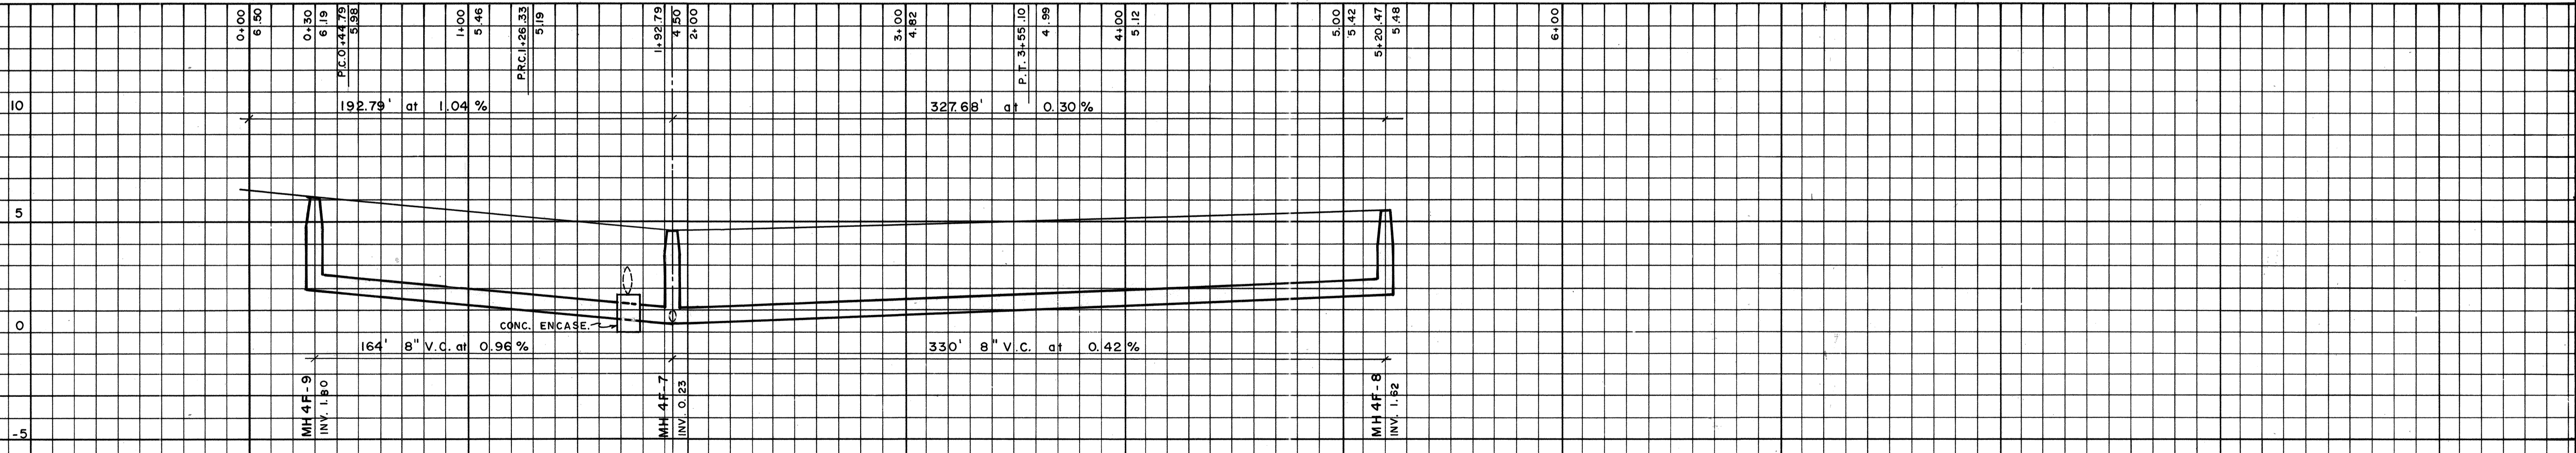

LEGEND
 - - - - - General Telephone
 - - - - - Storer Television
 - - - - - Fla. Power & Light Co.
 - - - - - Irrigation

PROJECT ENGINEER	DESIGNED BY	DATE:
	10-4-76	10-4-76
CHECKED BY	PROJECT NO.	
SCALE:		
HORIZ. 1" = 40'		
VERT. 1" = 4'		
DRAWN BY		
H. B.		
REVISION		
L.T.R.	DATE	
TOWN OF LONGBOAT KEY, FLORIDA		
ARVIDA CORPORATION		
BAY ISLES UNIT NO. 1		
SEWAGE COLLECTION		
ENGINEER	BENNETT & BISHOP, INC. - CONSULTING ENGINEERS & SURVEYORS - 4509 BEE RIDGE RD. SARASOTA, FLORIDA	
& LOCATION		
T.L.K. FILE NO.		
SHEET NUMBER	191-064 A B	
REVISION		

HARBOR POINT ROAD
 HARBOR COVE CIRCLE