


NOTE: Sanitary Lateral Stations are from nearest down stream manhole (0+00)

- LEGEND
- General Telephone
 - Storm Television
 - Fla. Power & Light Co.
 - Arvida Corporation

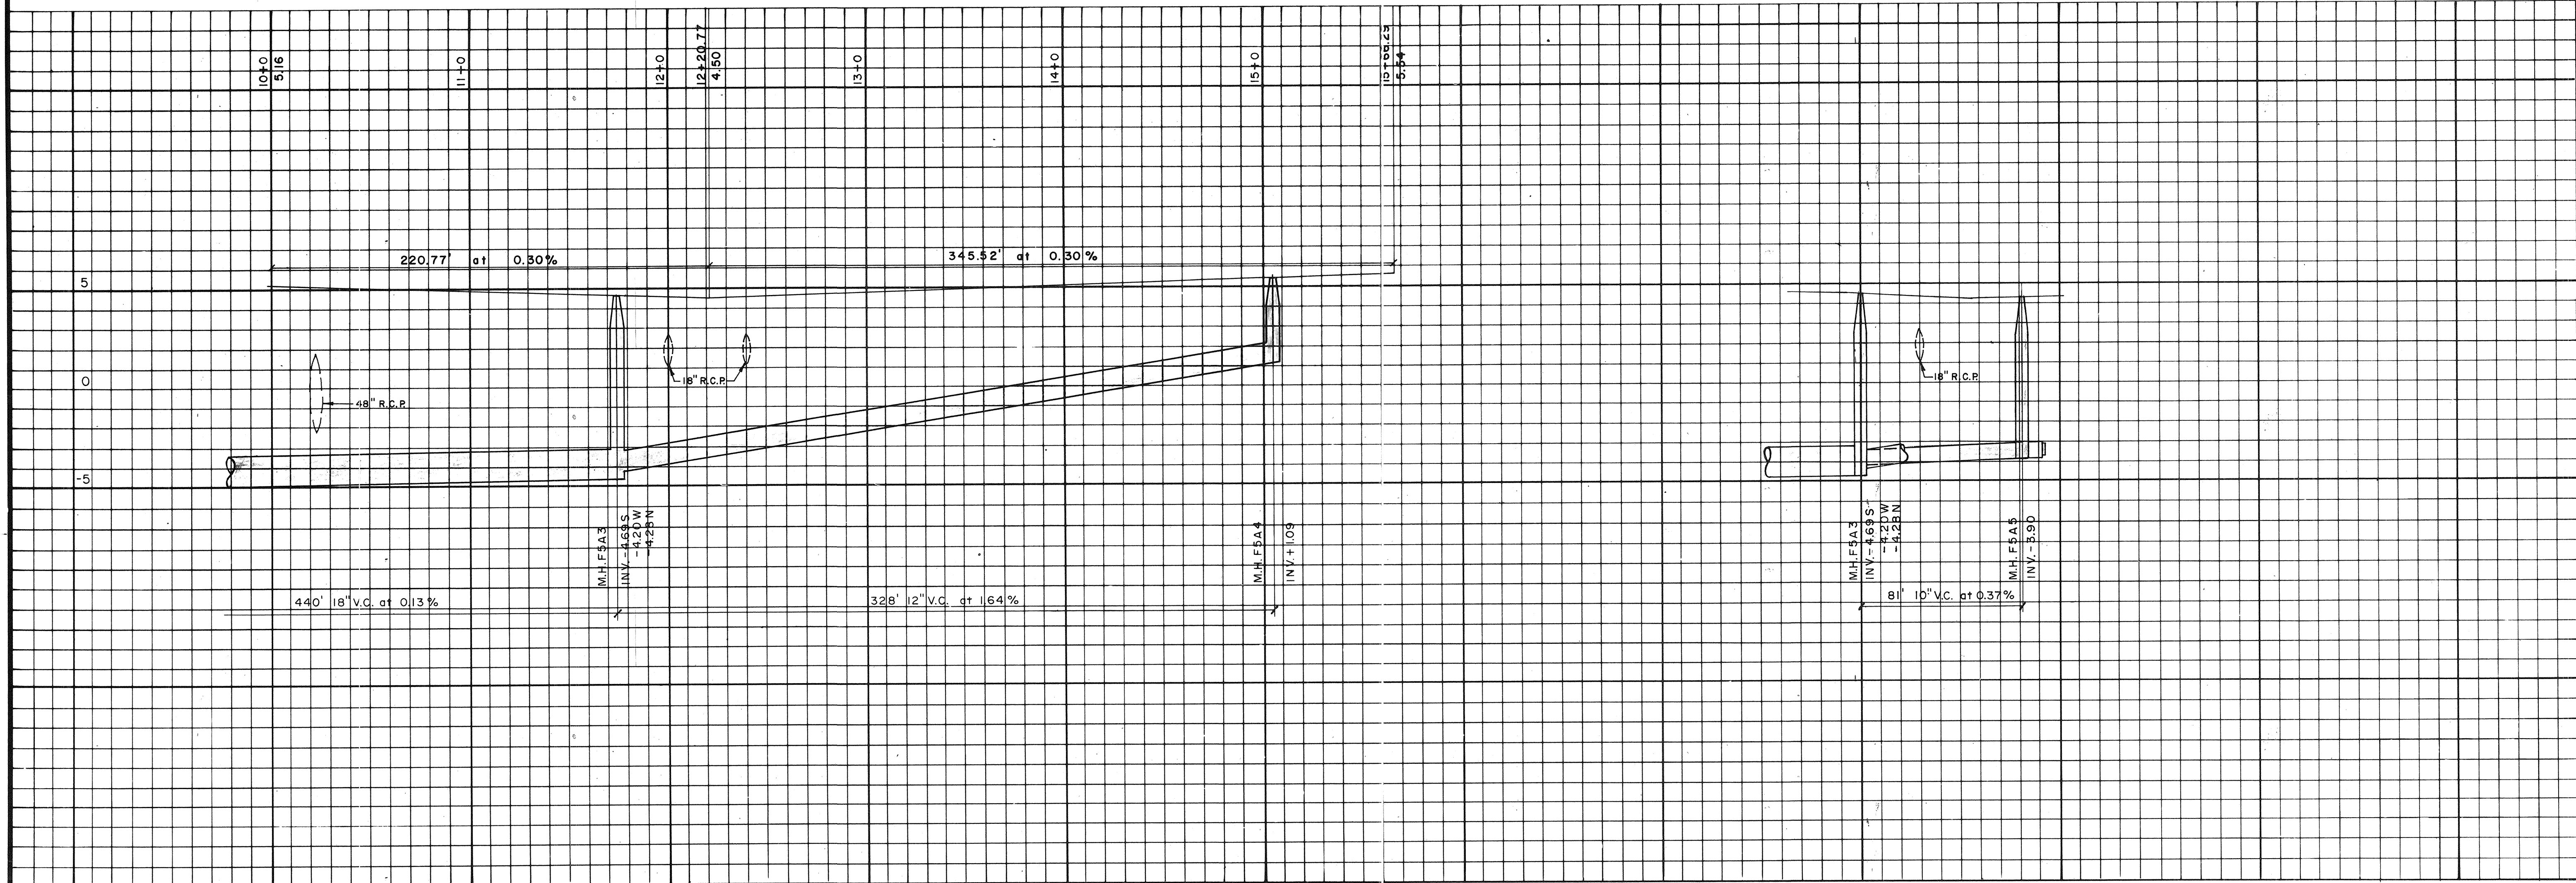

DESIGNED BY	PROJECT ENGINEER
DATE	10-21-77
CHECKED BY	
SCALE	HORIZ. 1"=40' VERT. 1"=4'
DRAWN BY	
REVISION	
BY	
L.T.R.	DATE
TOWN OF LONGBOAT KEY, FLORIDA ARVIDA CORPORATION BAY ISLES UNIT NO. 2 WATER DISTRIBUTION & SEWAGE COLLECTION BENNETT & BISHOP, INC. - CONSULTING ENGINEERS & SURVEYORS - 4509 BEE RIDGE RD., SARASOTA, FLORIDA	
SHEET NUMBER	191-145 AB
REVISION	
T.L.K. FILE NO.	