


NOTE: Sanitary Lateral Stations are from nearest down stream manhole (0+00)

- LEGEND
- General Telephone
 - Storer Television
 - Fla. Power & Light Co.
 - Arvida Corporation

BAYOU SOUND

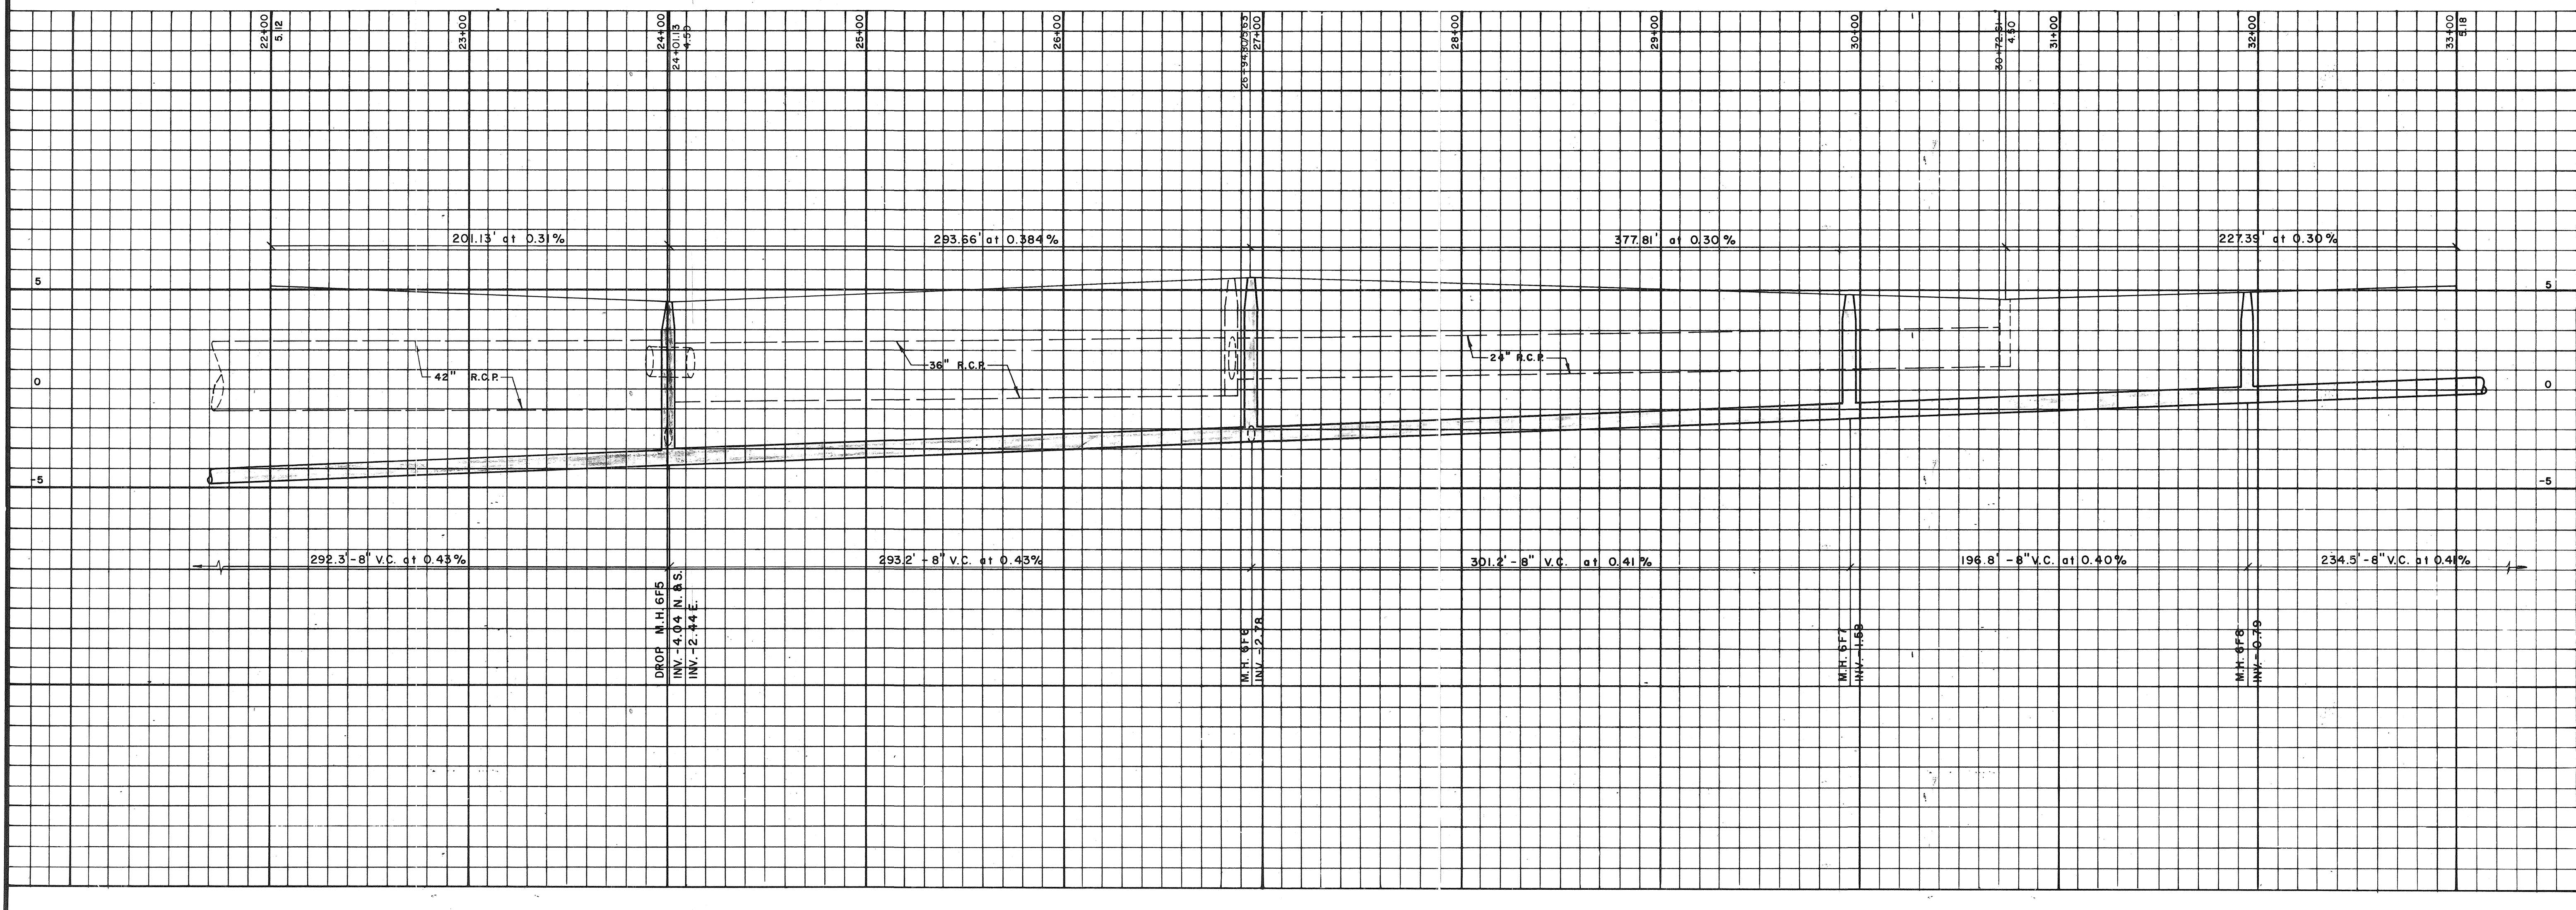

REVISION	BY	DATE	DESIGNED BY	PROJECT ENGINEER
REVISION	BY	DATE	CHECKED BY	PROJECT NO.
TOWN OF LONGBOAT KEY, FLORIDA ARVIDA CORPORATION BAY ISLES UNIT NO. 2 WATER DISTRIBUTION & SEWAGE COLLECTION ENGINEER & LOCATION BENNETT & BISHOP, INC. - CONSULTING ENGINEERS & SURVEYORS - 4509 BEE RIDGE RD., SARASOTA, FLORIDA				
SHEET NUMBER 191-139 AB				
REVISION				

T.L.K. FILE NO.