


NOTE: Sanitary Lateral Stations
are from nearest down stream
manhole (0+00)

LEGEND
 --- General Telephone
 --- Storm Television
 --- Fla. Power & Light Co.
 --- Arvida Corporation

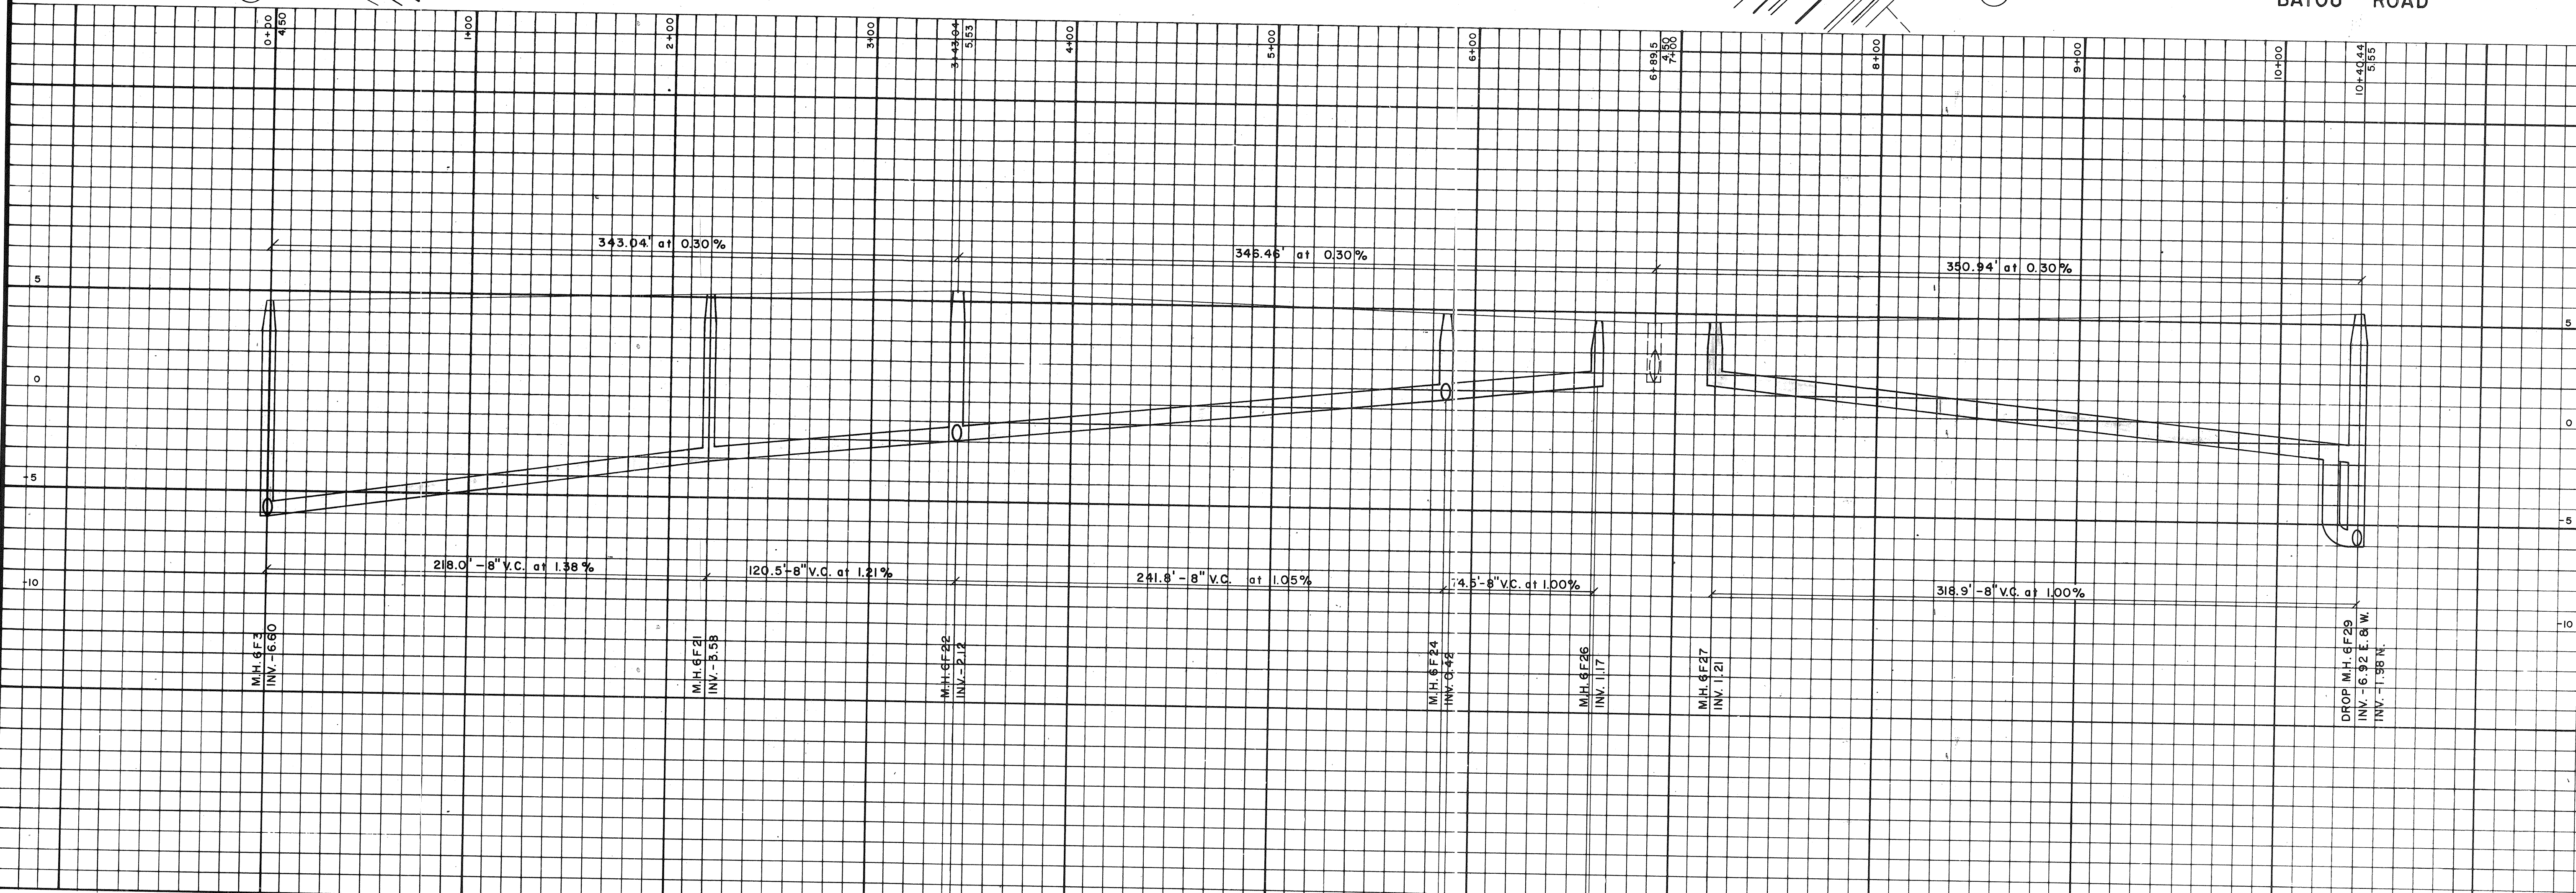

PROJECT ENGINEER	DESIGNED BY	DATE:
CHECKED BY PROJECT NO.	BY	SCALE: HOR. 1"=40'
	DRAWN BY	VER. 1"=4'
REVISION	LTR.	DATE
TOWN OF LONGBOAT KEY, FLORIDA ARVIDA CORPORATION BAY ISLES UNIT NO. 2 WATER DISTRIBUTION & SEWAGE COLLECTION BENNETT & BISHOP, INC. — CONSULTING ENGINEERS & SURVEYORS — 4509 BEE RIDGE RD., SARASOTA, FLORIDA		
SHEET NUMBER	191-142 AB	
REVISION		

T.L.K. FILE NO.