


PROPOSED VICTORIA POINT
PARCEL MF "I"

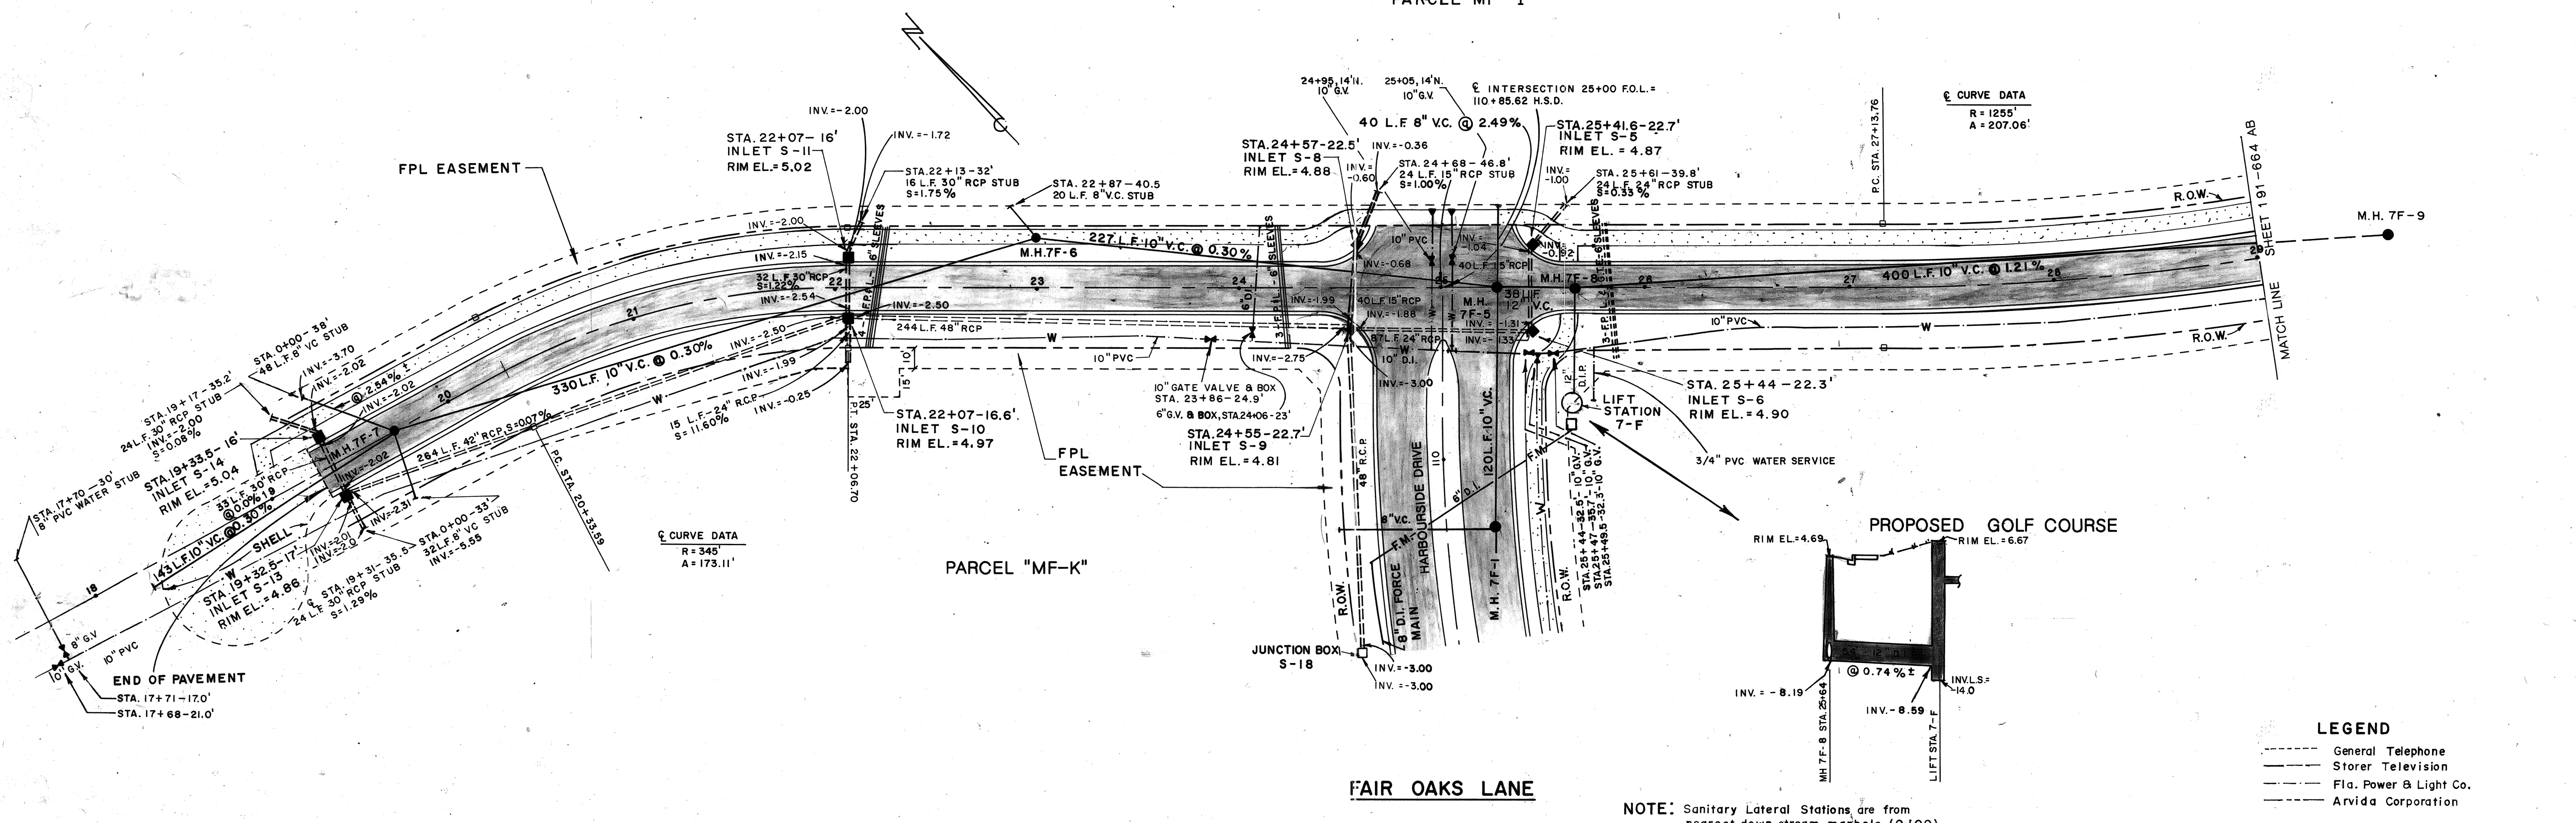


PROPOSED GOLF COURSE

FAIR OAKS LANE

NOTE: Sanitary Lateral Stations are from nearest down stream manhole (0+00)

- LEGEND**
- General Telephone
 - Storer Television
 - Fla. Power & Light Co.
 - Arvida Corporation

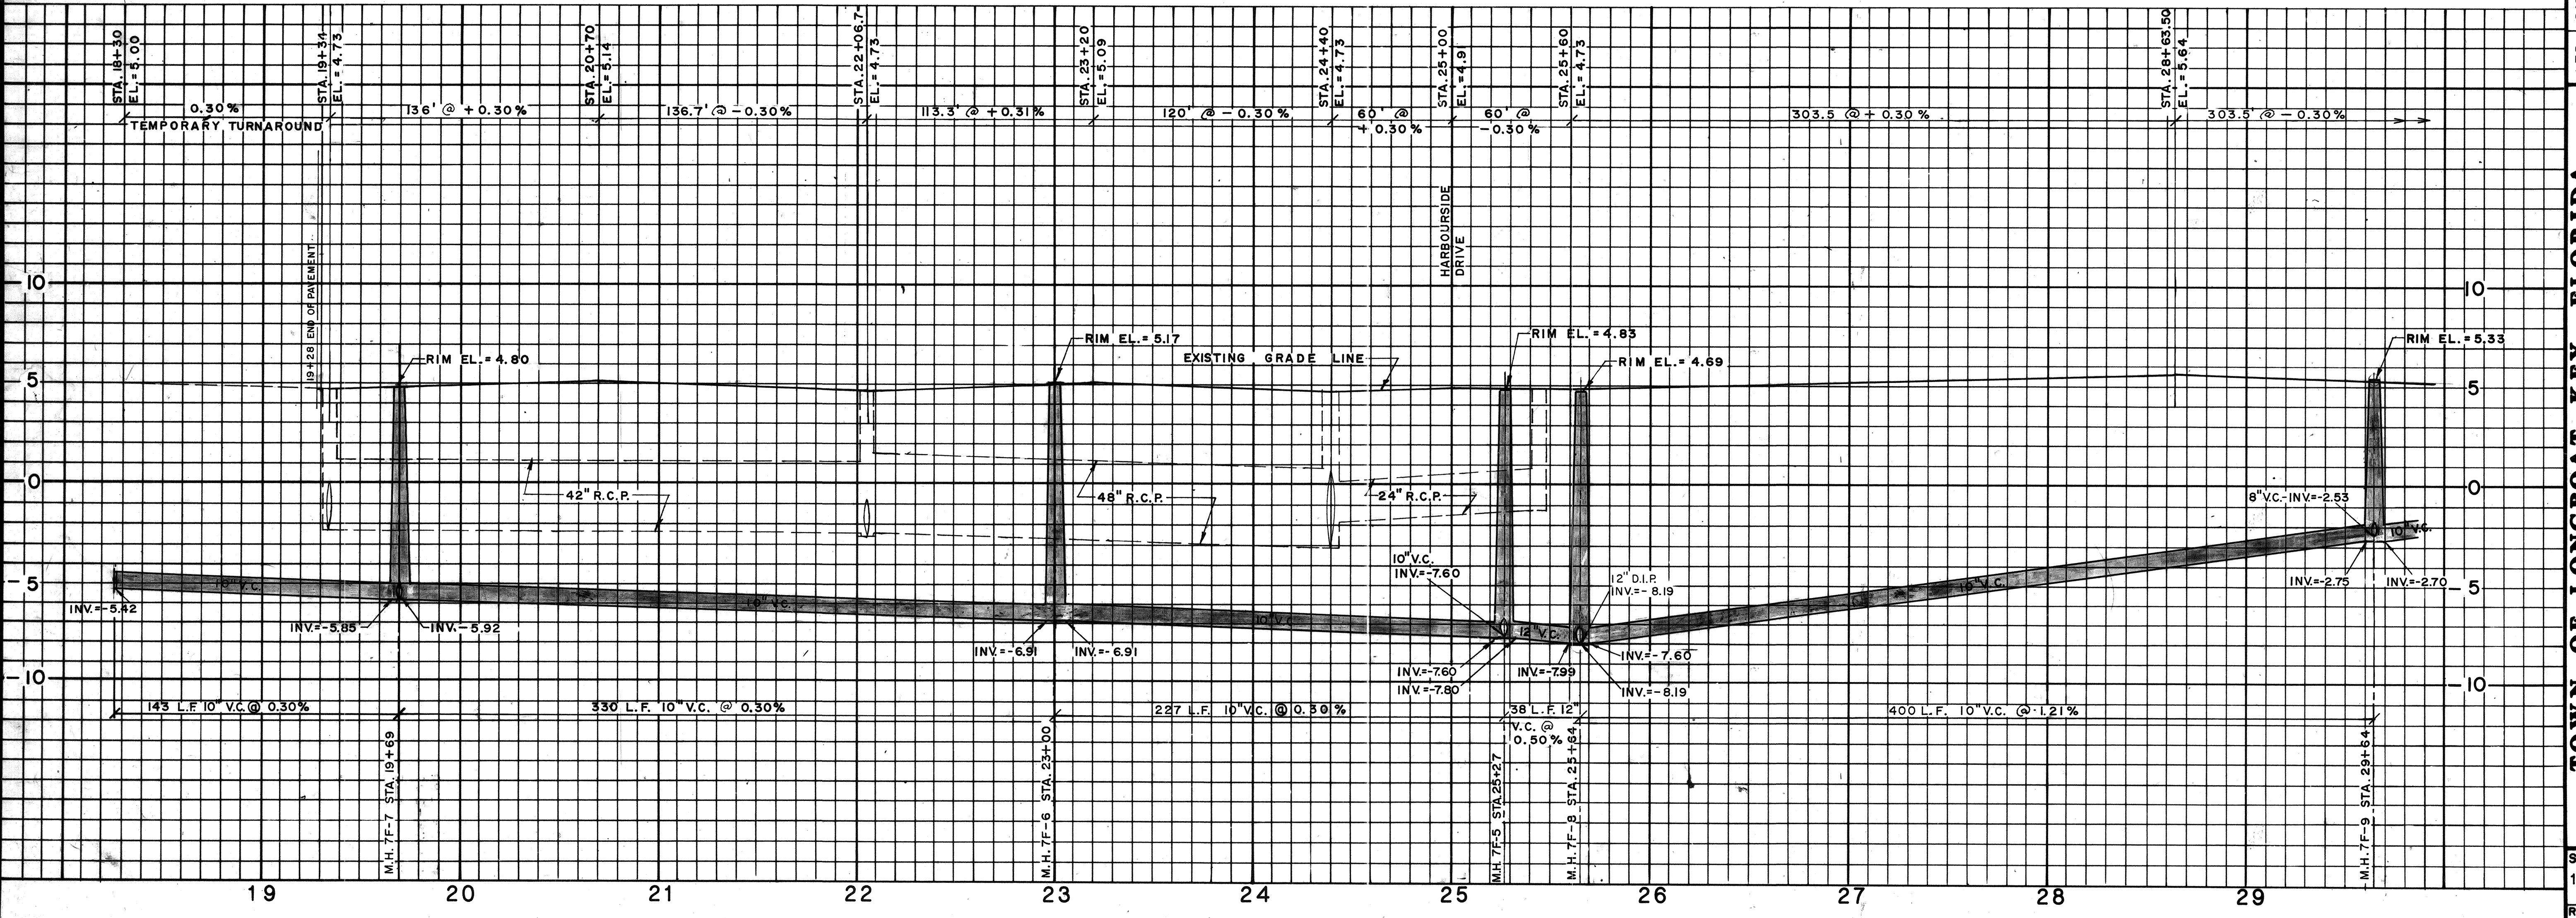

PROJECT ENGINEER	DESIGNED BY	DATE
	CHECKED BY	PROJECT NO.
REVISION	BY	SCALE:
	RWC	HORIZ: 1"=40'
L.T.R.	DATE	2-20-86
	DATE	2-20-86
TOWN OF LONGBOAT KEY, FLORIDA		
ARVIDA CORPORATION		
RECORD DRAWING OF: FAIR OAKS LANE		
BENNETT & BISHOP INC. ENGINEERS & SURVEYORS 4509 BEE RIDGE ROAD SARASOTA, FLORIDA		
SHEET NUMBER 191-665 AB		
REVISION		