
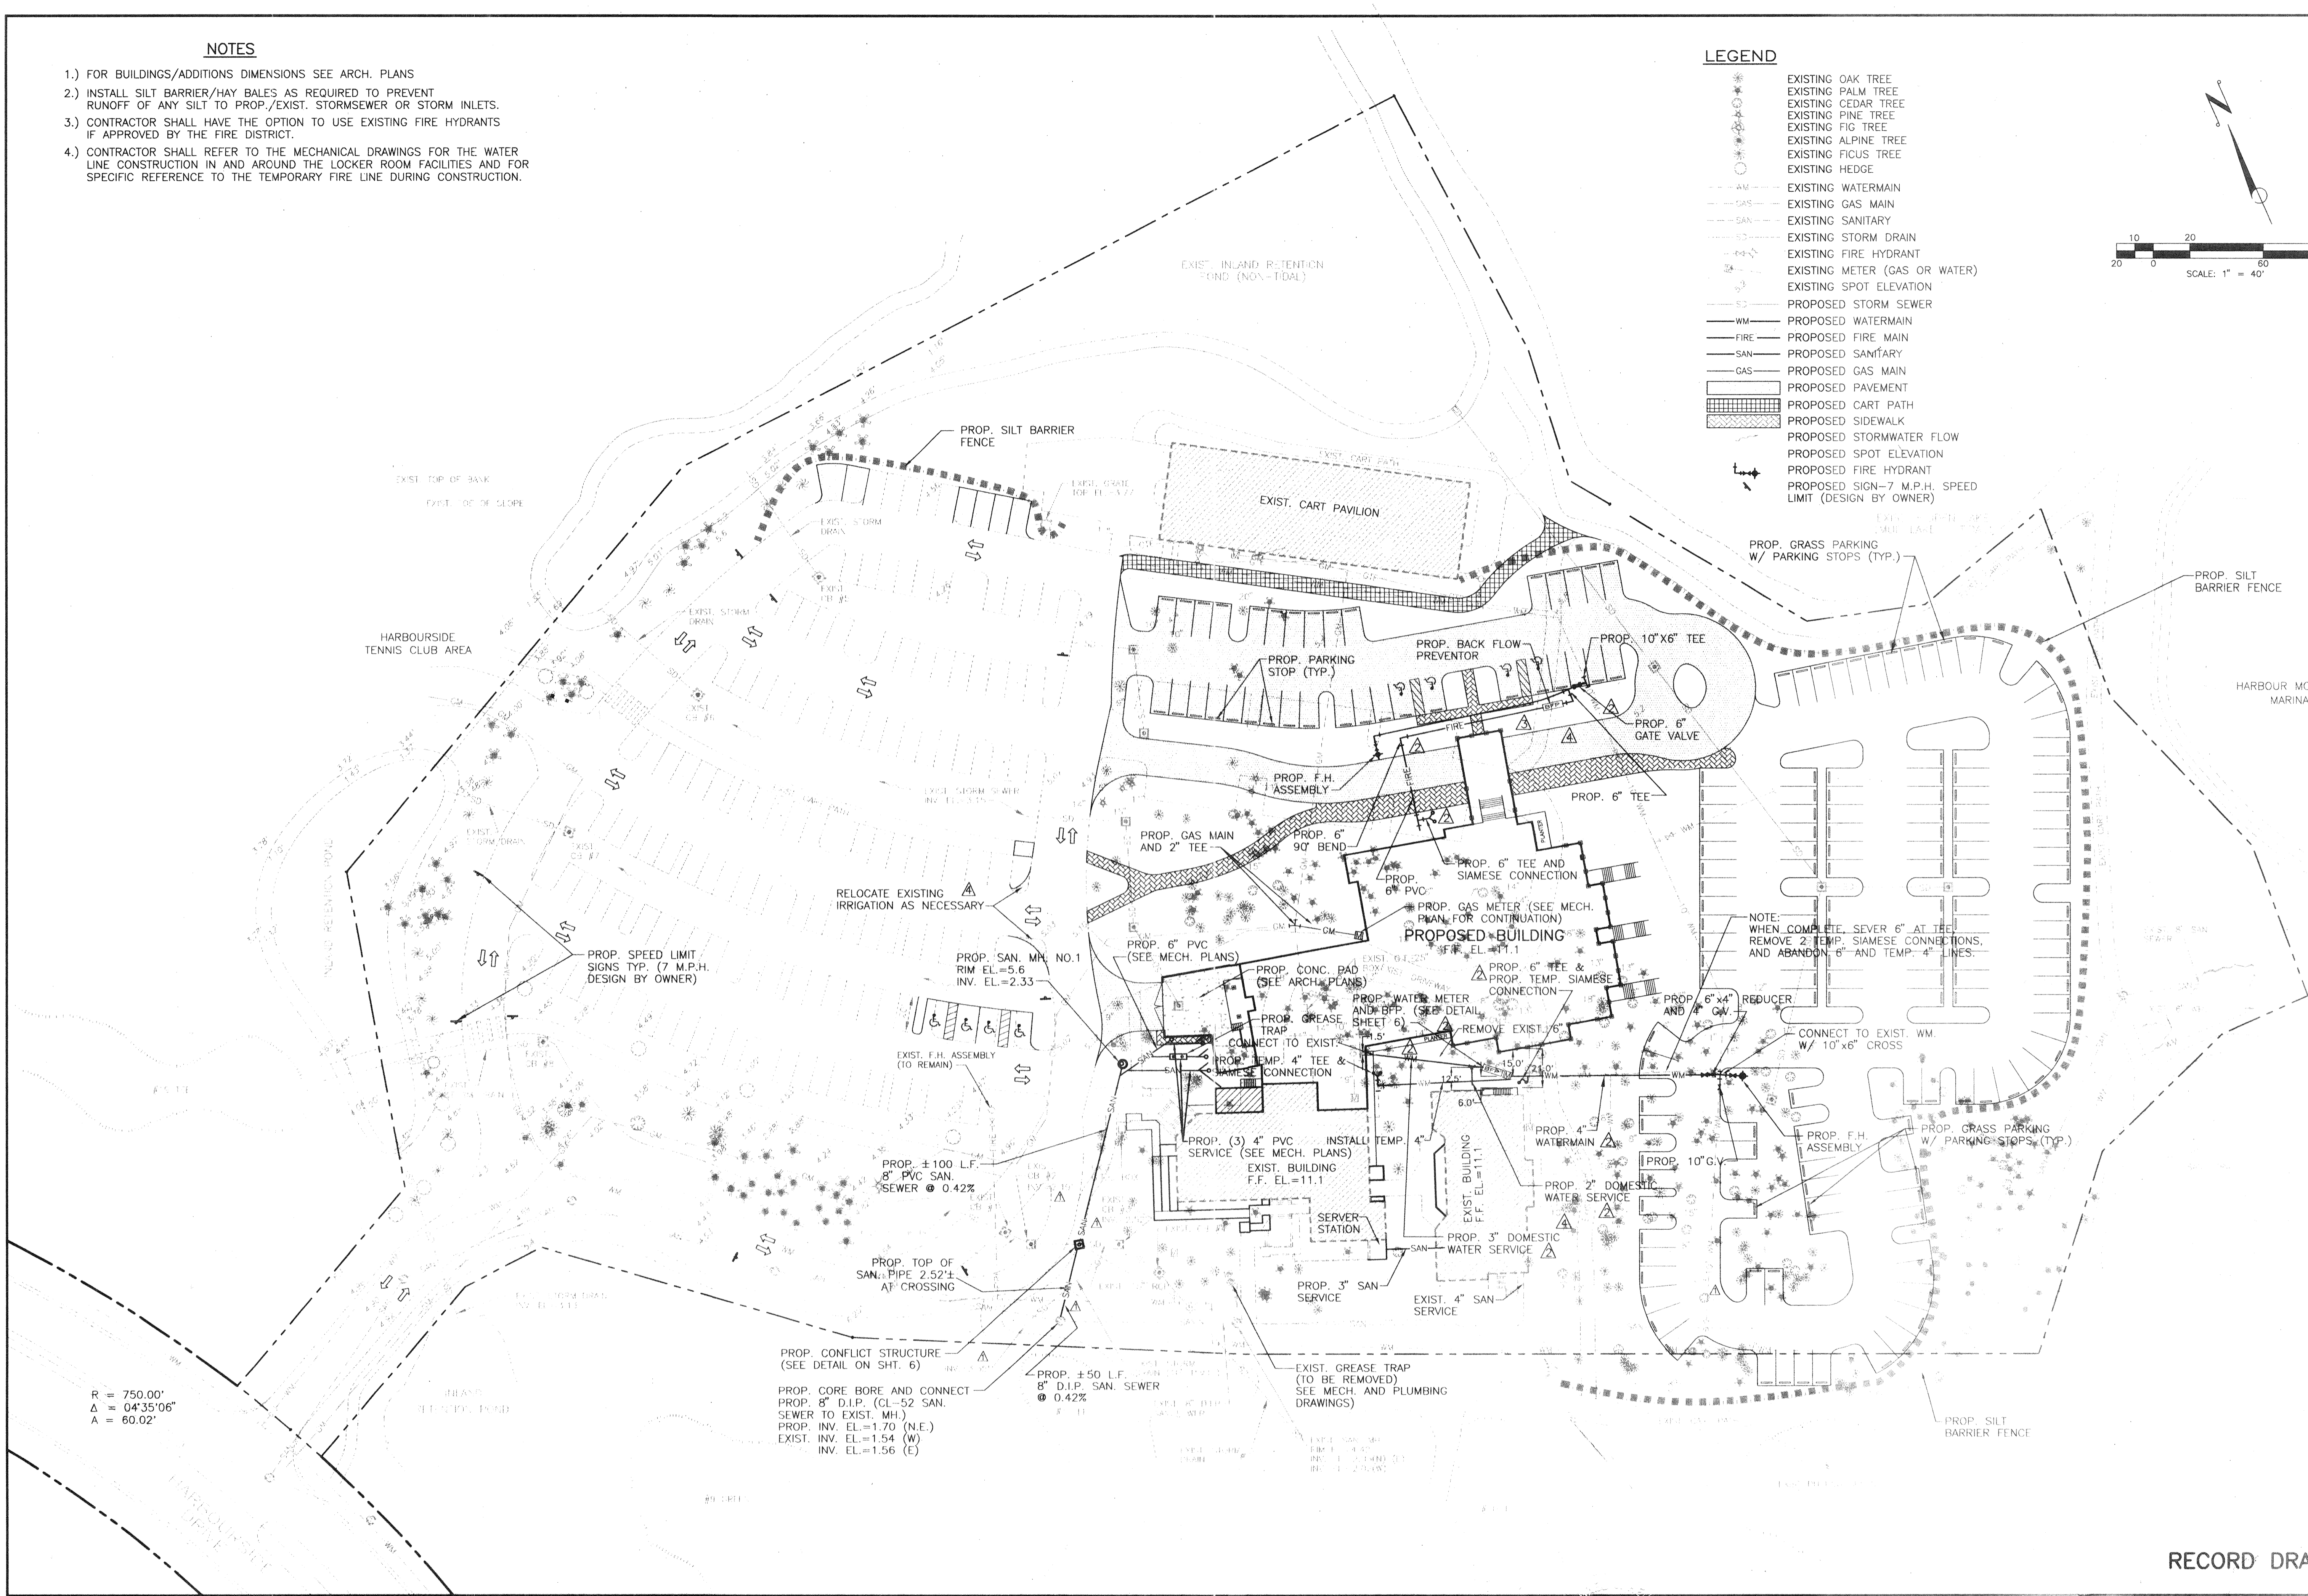


**NOTES**

- 1.) FOR BUILDINGS/ADDITIONS DIMENSIONS SEE ARCH. PLANS
- 2.) INSTALL SILT BARRIER/HAY BALES AS REQUIRED TO PREVENT RUNOFF OF ANY SILT TO PROP./EXIST. STORMSEWER OR STORM INLETS.
- 3.) CONTRACTOR SHALL HAVE THE OPTION TO USE EXISTING FIRE HYDRANTS IF APPROVED BY THE FIRE DISTRICT.
- 4.) CONTRACTOR SHALL REFER TO THE MECHANICAL DRAWINGS FOR THE WATER LINE CONSTRUCTION IN AND AROUND THE LOCKER ROOM FACILITIES AND FOR SPECIFIC REFERENCE TO THE TEMPORARY FIRE LINE DURING CONSTRUCTION.

**LEGEND**

- EXISTING OAK TREE
- EXISTING PALM TREE
- EXISTING CEDAR TREE
- EXISTING PINE TREE
- EXISTING FIG TREE
- EXISTING ALPINE TREE
- EXISTING FICUS TREE
- EXISTING HEDGE
- EXISTING WATERMAIN
- EXISTING GAS MAIN
- EXISTING SANITARY
- EXISTING STORM DRAIN
- EXISTING FIRE HYDRANT
- EXISTING METER (GAS OR WATER)
- EXISTING SPOT ELEVATION
- PROPOSED STORM SEWER
- PROPOSED WATERMAIN
- PROPOSED FIRE MAIN
- PROPOSED SANITARY
- PROPOSED GAS MAIN
- PROPOSED PAVEMENT
- PROPOSED CART PATH
- PROPOSED SIDEWALK
- PROPOSED STORMWATER FLOW
- PROPOSED SPOT ELEVATION
- PROPOSED FIRE HYDRANT
- PROPOSED SIGN-7 M.P.H. SPEED LIMIT (DESIGN BY OWNER)

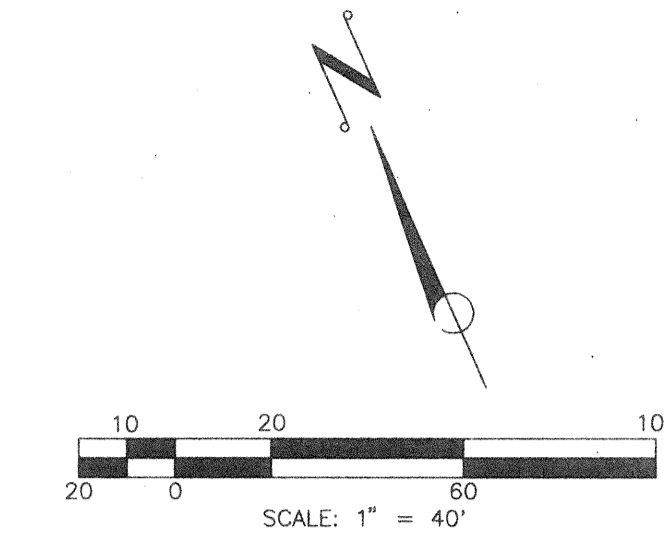

R = 750.00'  
 Δ = 04°35'06"  
 A = 60.02'

**RECORD DRAWING**

**BISHOP & ASSOCIATES**  
 Consulting Engineers - Surveyors  
 AN EMPLOYEE OWNED COMPANY  
 78 SARASOTA CENTER BOULEVARD, SARASOTA, FLORIDA 34240  
 PHONE (813)371-6362 • FAX (813)-378-3215

BY	DATE	Q.C.	DATE	DESCRIPTION	BY	DATE	Q.C.	DATE	DESCRIPTION
JMM	9/18/95	JMM	9/18/95	REMOVED PROP. FIRE LINE, ADD SIM INLET, CHG WATER TO 4"	DNS	2/14/96	M.J.H.	2/14/96	REV. FIRE LINE
JMM	10/2/95	JMM	10/2/95	CHANGED WATER LINE FOR NEW BLDG.	PKR	8/9/96	M.J.H.	8/9/96	RECORD DRAWING - SOUTHERLY MOST WATER MAIN
D.B.	12/18/95	D.W.	12/18/95	REV. WATER & SEWER, ADD INV.	SMP	9/12/96	M.J.H.	9/12/96	RELOCATE FIRE LINE BACKFLOW PREVENTOR & IRRIGATION
D.B.	12/20/95			REMOVE BFP	SMP	9/24/96	M.J.H.	9/24/96	RECORD DRAWING - BALANCE OF WATER PLUS WASTE WATER
DNS	2/1/96	M.J.H.	2/1/96	REV. DOMESTIC AND FIRE LOCATIONS, ADD AND REMOVE BFP					

TASK	INITIALS	DATE
DESIGN	D.M.W.	5/17/95
DRAWN	D.M.S.	5/17/95
CHECKED	D.M.W.	5/17/95
QUANTITY	CHK	
RECORD	SCALE	1" = 40'

HARBORSIDE CLUBHOUSE  
 ADDITIONS AND RENOVATIONS  
 SITE AND UTILITY PLAN

PROJECT NO. SHC-02
SHEET NO. 3