


- LEGEND**
- SANITARY SEWER LINE
  - WATER MAIN
  - STORM SEWER LINE
  - - - SLEEVE CROSSING
  - ⊕ FH FIRE HYDRANT
  - ⊕ GV GATE VALVE
  - ⊕ CB CATCH BASIN
  - ⊕ MH MANHOLE (SANITARY)
  - ⊕ LS LIGHT STANDARD
  - ⊕ WM WATER METER
  - ⊕ CO CLEAN OUT (SANITARY)
  - FORCE MAIN

**HARBOURSIDE DRIVE**  
(formerly BAY ISLES BOULEVARD)

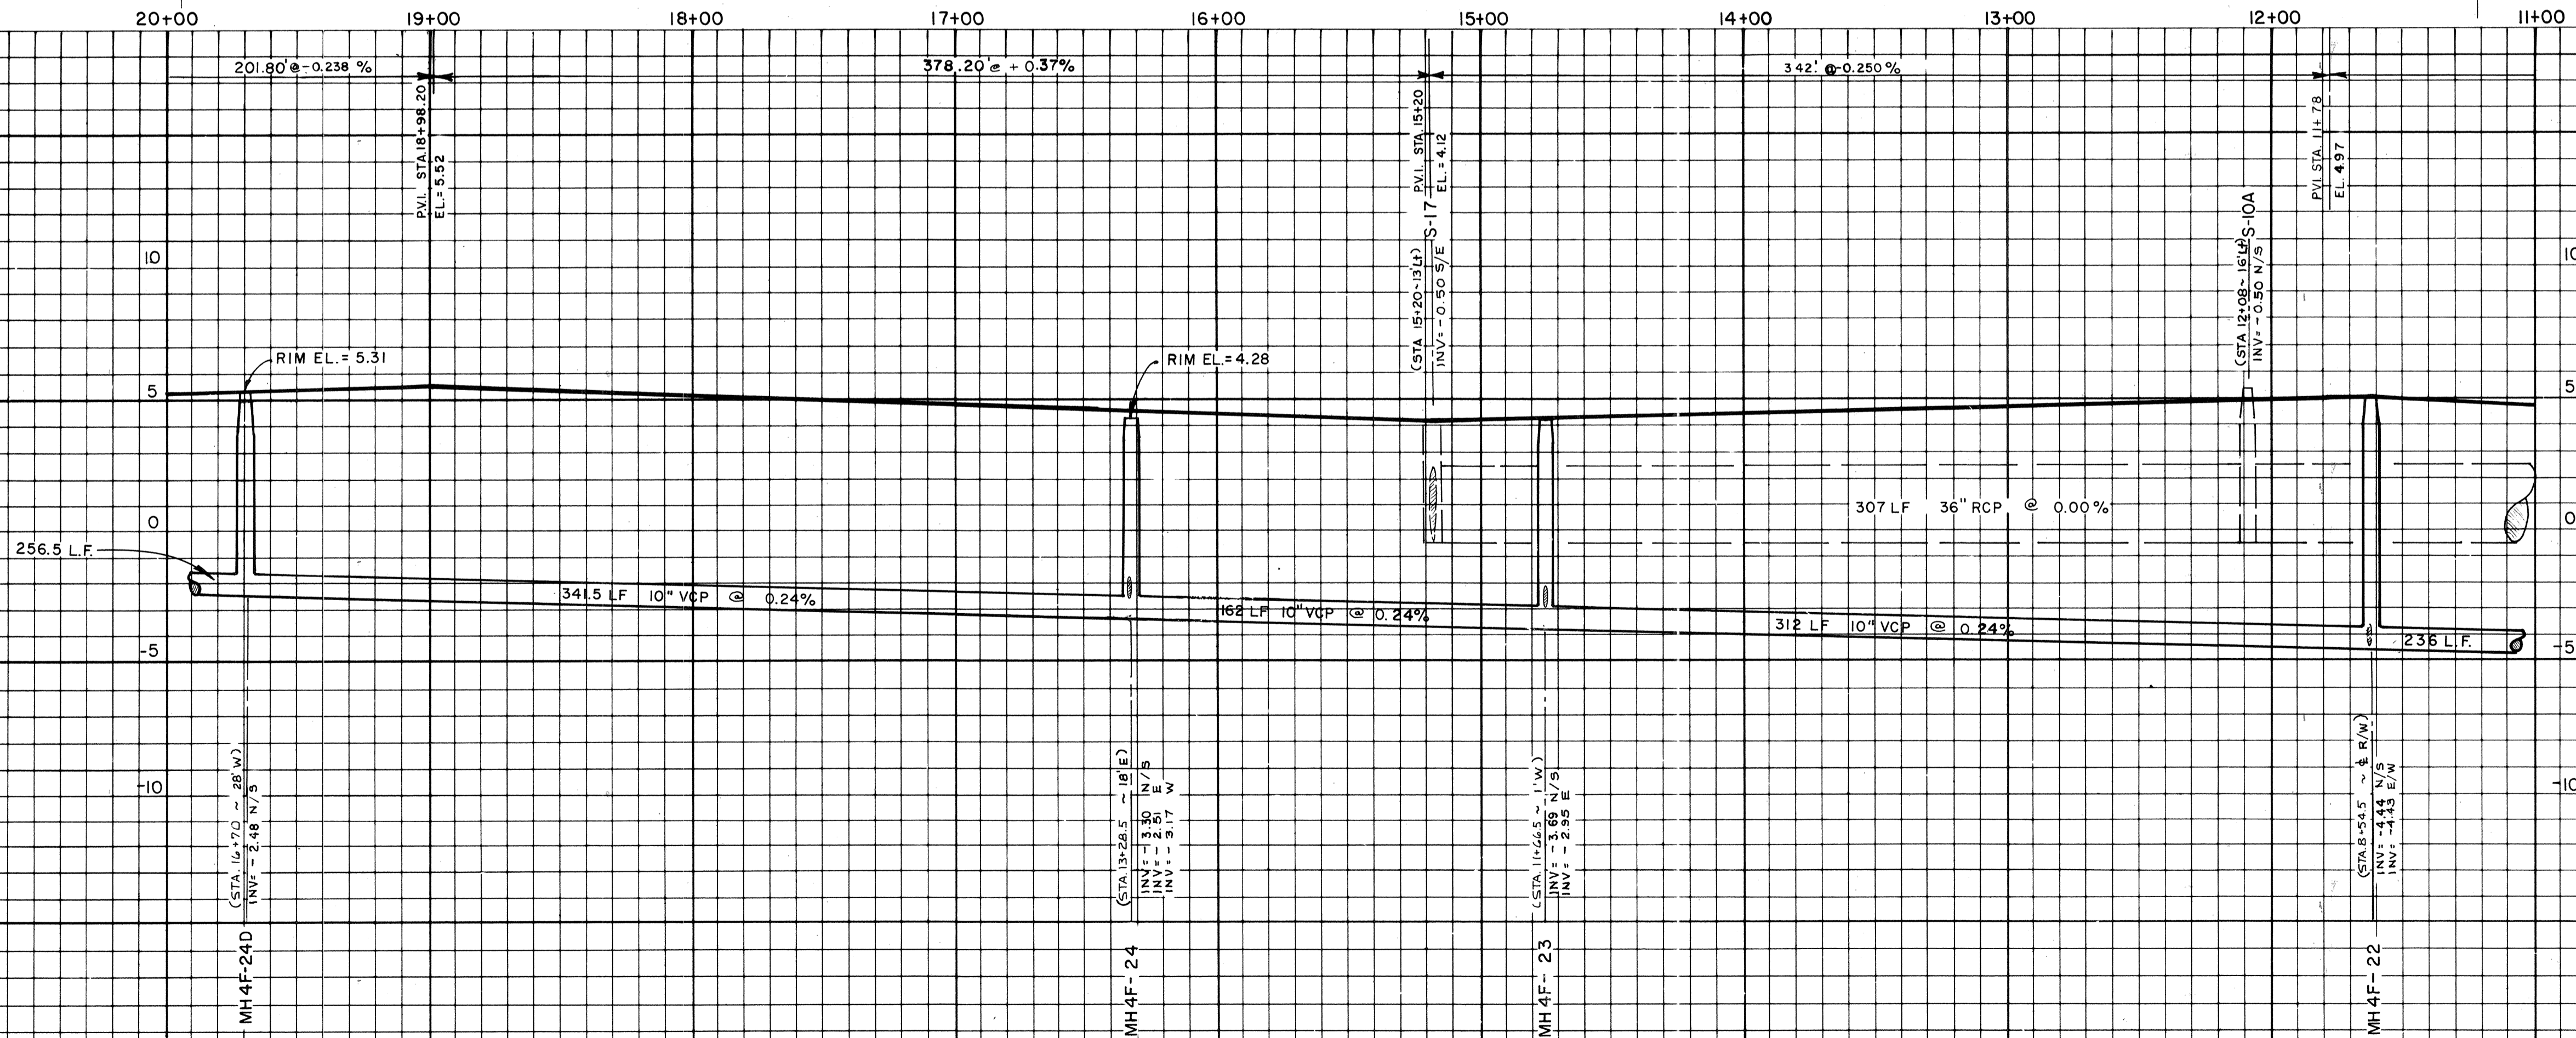

MATCH LINE  
Sta. 19+93.80  
SEE SHEET NO. 191-697AB

Sta. 11+22.02  
MATCH LINE  
SEE SHEET NO. 191-697AB

<b>TOWN OF LONGBOAT KEY, FLORIDA</b>	DATE: 5-7-85	REVISION	BY: K-2-P	DESIGNED BY: PROJECT ENGINEER
	L.T.R.			
<b>AS-BUILT</b>	ARVIDA CORPORATION HARBOURSIDE DRIVE (formerly BAY ISLES BOULEVARD)			
<b>ENGINEER &amp; LOCATION</b>	BENNETT & BISHOP INC. ENGINEERS & SURVEYORS 4509 BEE RIDGE ROAD SARASOTA, FLORIDA			
<b>SHEET NUMBER</b>	191-698 AB			
<b>REVISION</b>	DRAWN BY: D. DALLAS CHECKED BY: PROJECT NO. SCALE: HORIZ. 1" = 40' VERT. 1" = 4' DATE: JAN., 1983 DESIGNED BY: PROJECT ENGINEER			