


- LEGEND**
- SANITARY SEWER LINE
 - WATER MAIN
 - STORM SEWER LINE
 - SLEEVE CROSSING
 - ⊙ FH FIRE HYDRANT
 - ⊙ GV GATE VALVE
 - ⊙ CB CATCH BASIN
 - ⊙ MH MANHOLE (SANITARY)
 - ⊙ LS LIGHT STANDARD
 - ⊙ WM WATER METER
 - ⊙ CO CLEAN OUT (SANITARY)
 - FM FORCE MAIN

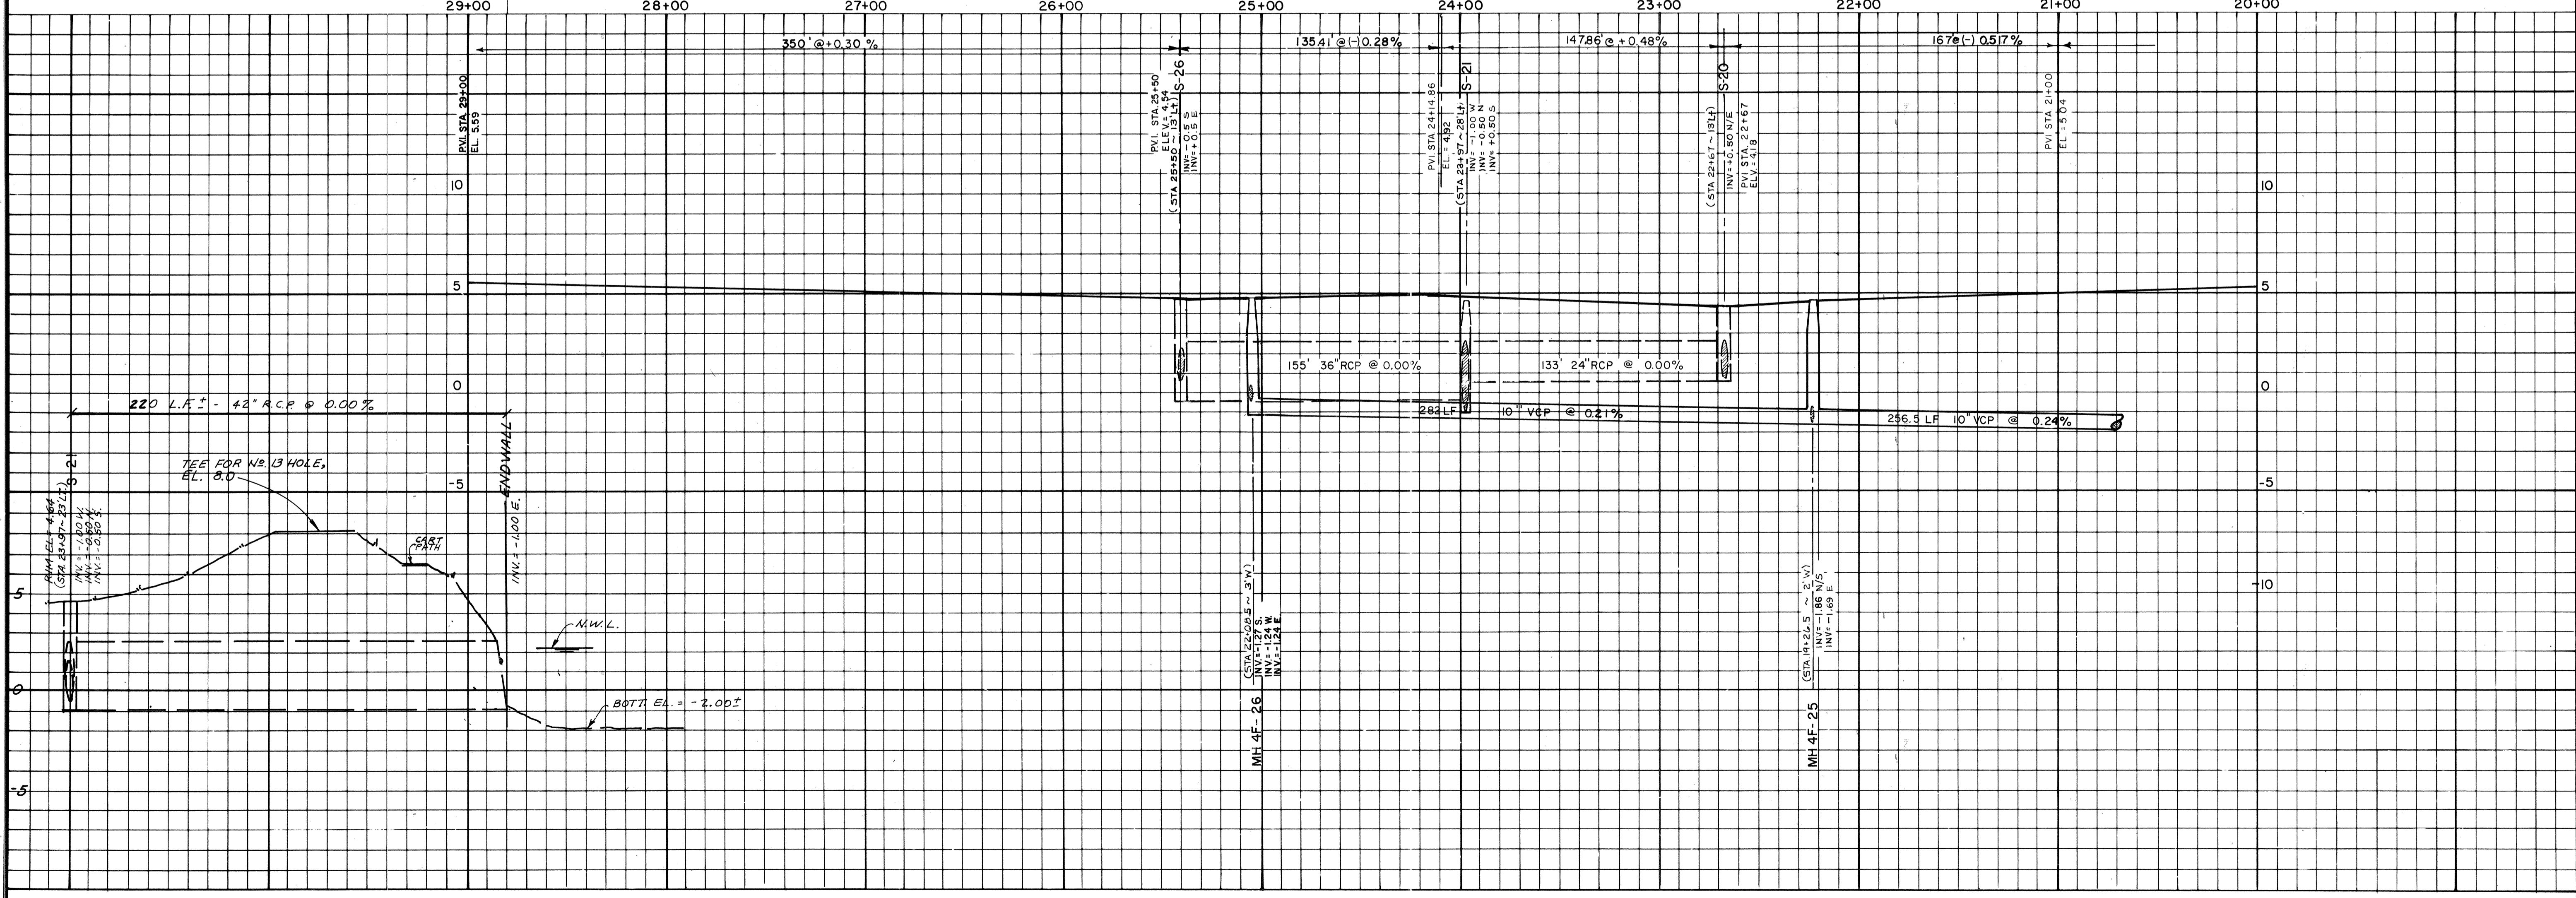

TOWN OF LONGBOAT KEY, FLORIDA	ARVIDA CORPORATION HARBORSIDE DRIVE (formerly BAY ISLES BOULEVARD)	ENGINEERS & SURVEYORS	4509 BEE RIDGE ROAD	SARASOTA, FLORIDA	<i>William Bradley & P.C.</i>
AS-BUILT					
SHEET NUMBER		191-639 AB			
REVISION					
DATE		5-2-88			
L.T.R.					
DATE		5-2-88			
REVISION		ADDITION OF SWEET WALL, WATER SLEEVE CROSSING, E.S.C.			
BY		K.A.B.			
DESIGNED BY		PROJECT ENGINEER			
CHECKED BY		DATE: JAN, 1983			
DRAWN BY		D. DALLAS			
PROJECT NO.					