



FOR CONTINUATION SEE SHEET 191-665AB

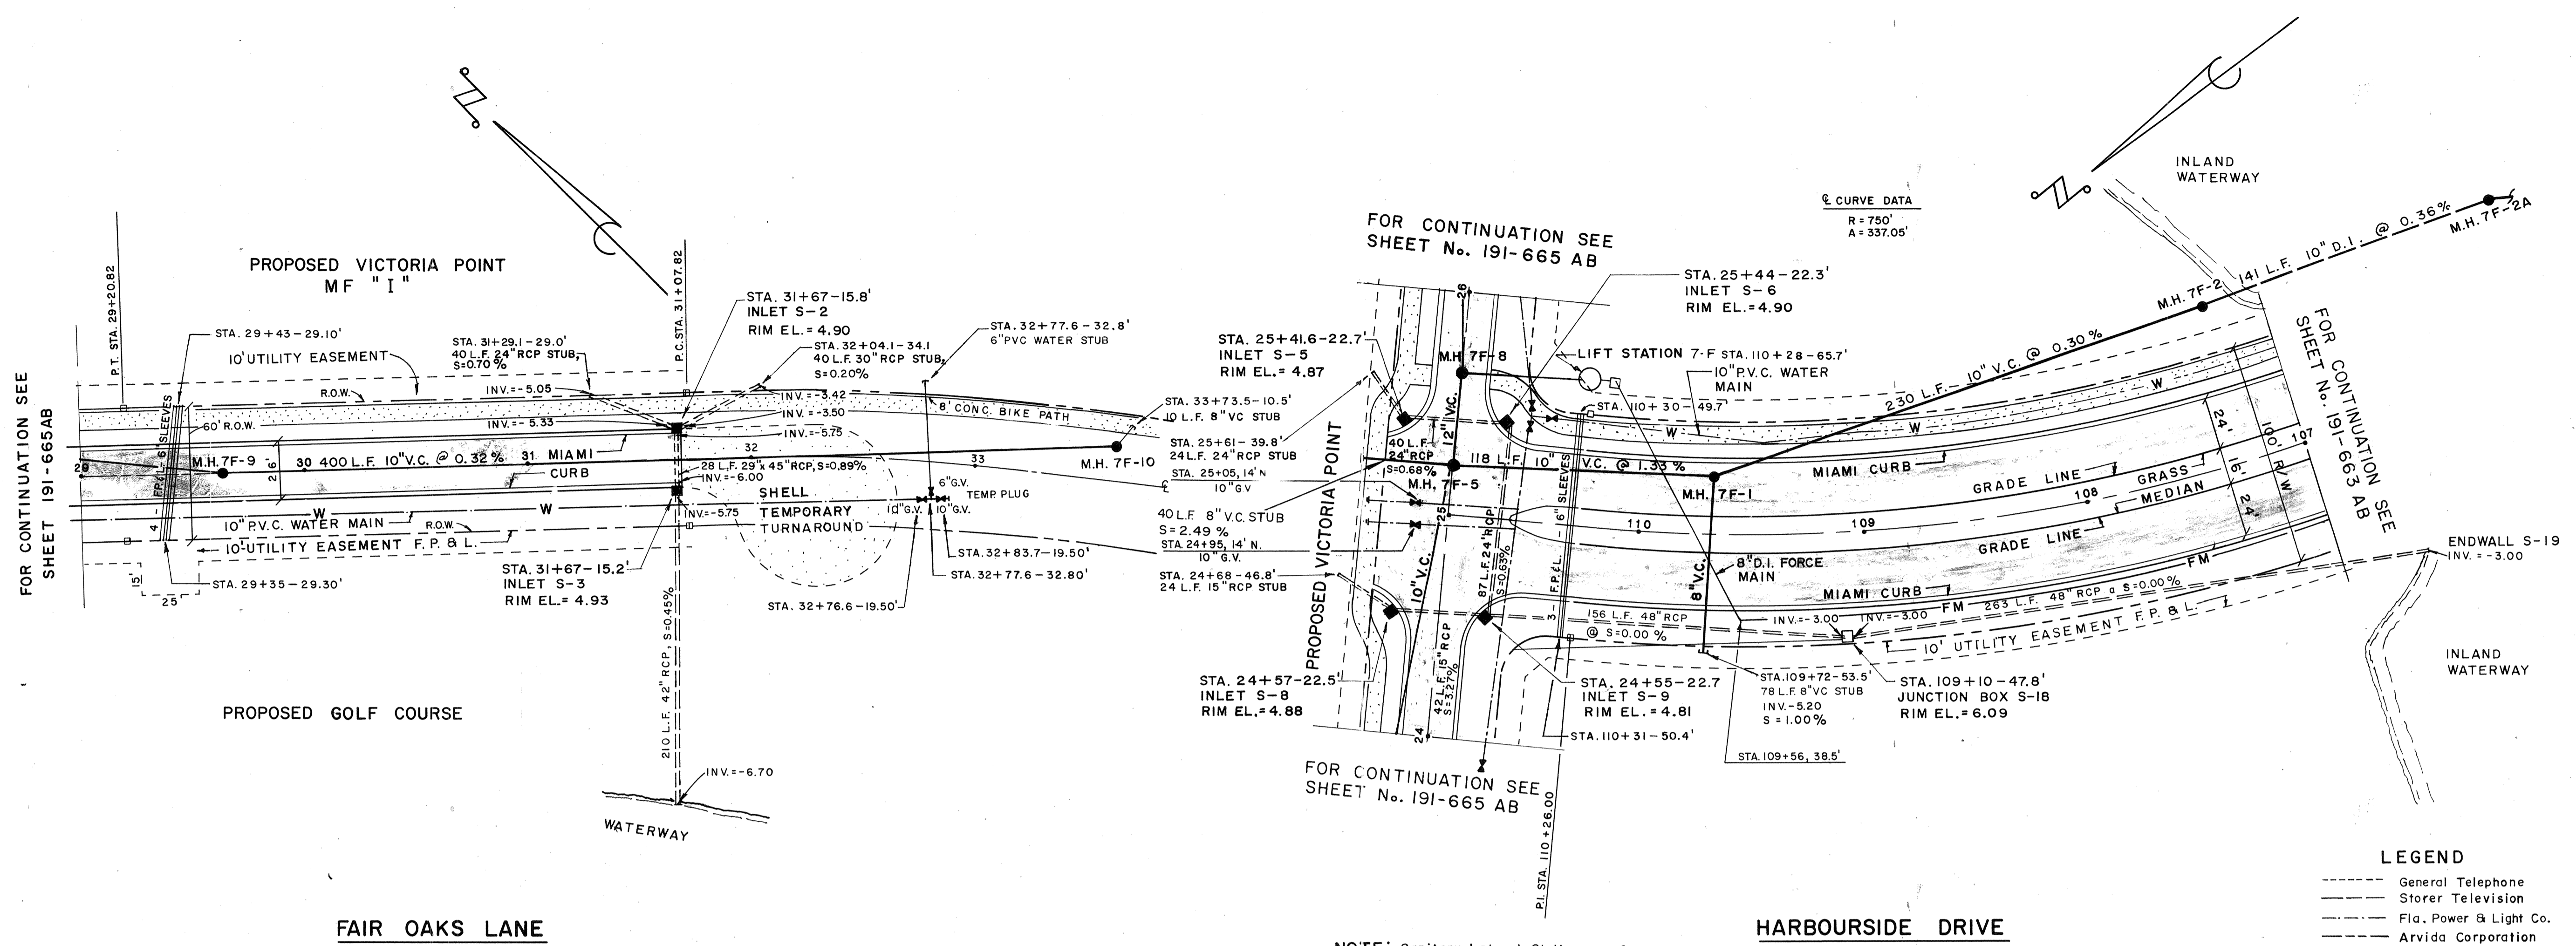

CURVE DATA
R = 750'
A = 337.05'

LEGEND
--- General Telephone
--- Storer Television
--- Fla. Power & Light Co.
--- Arvida Corporation

NOTE: Sanitary Lateral Stations are from nearest down stream manhole (0+00)

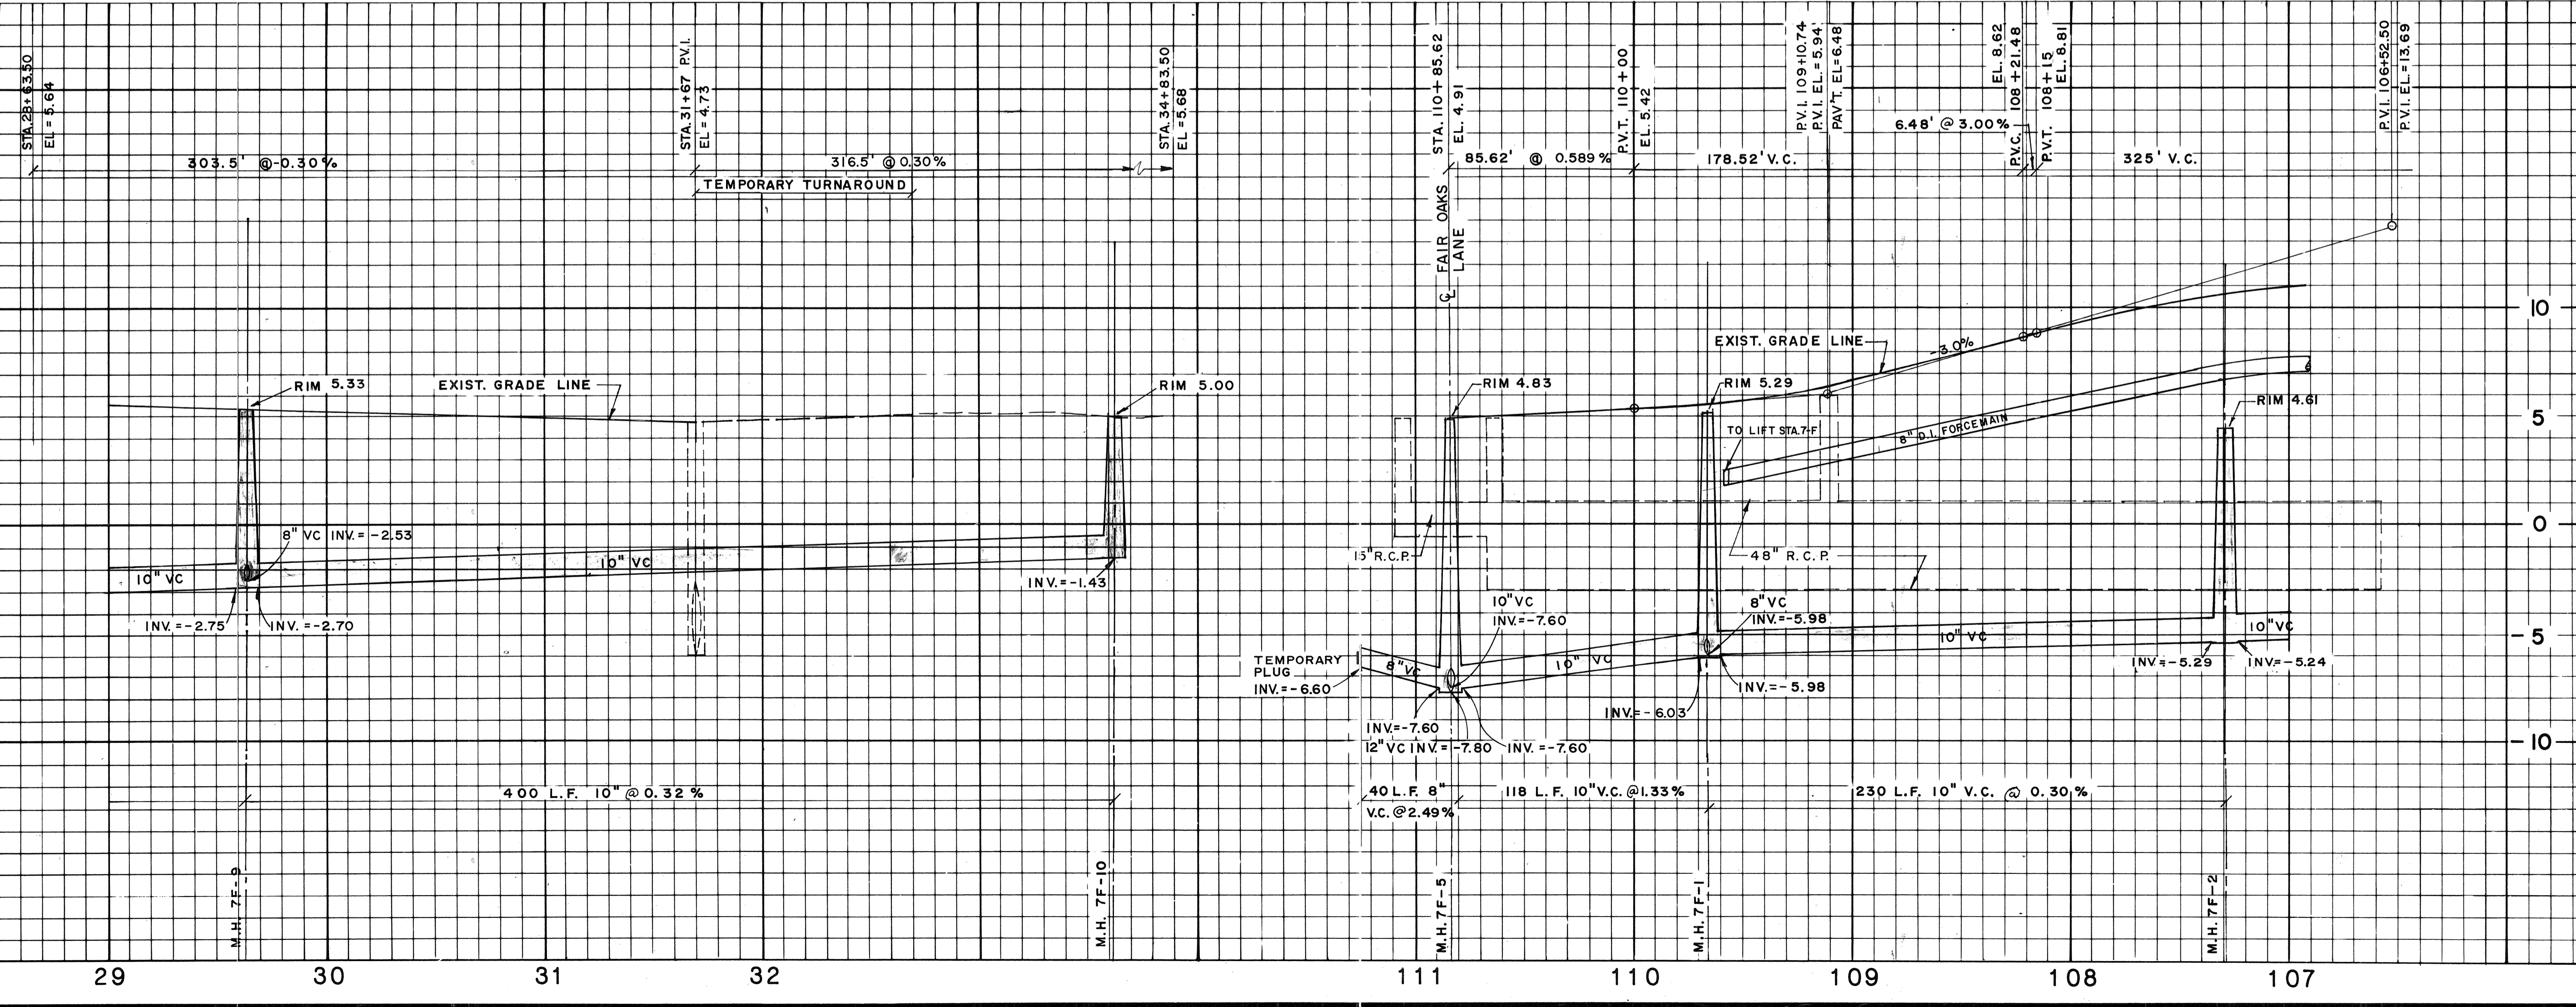

DESIGNED BY	PROJECT ENGINEER
DATE:	CHECKED BY PROJECT NO.
SCALE: 1" = 40'	191-32
BY	DRAWN BY J.R. REESE
REVISION	PHONE 371-76362
L.T.R.	DATE
TOWN OF LONGBOAT KEY, FLORIDA	
ARVIDA CORPORATION	
RECORD DRAWING OF: HARBOURSIDE DRIVE and FAIR OAKS LANE	
ENGINEERS & SURVEYORS	
BENNETT & BISHOP INC. 4509 BEE RIDGE ROAD SARASOTA, FLORIDA	
SHEET NUMBER	191-664 AB
REVISION	T.L.K. FILE NO.