


CURVE DATA  
 R=700'  
 A=813.69'

NOTE: Sanitary Lateral Stations are from  
 nearest down stream manhole (0+00)

- LEGEND**
- General Telephone
  - Storer Television
  - Fla. Power & Light Co.
  - Arvida Corporation

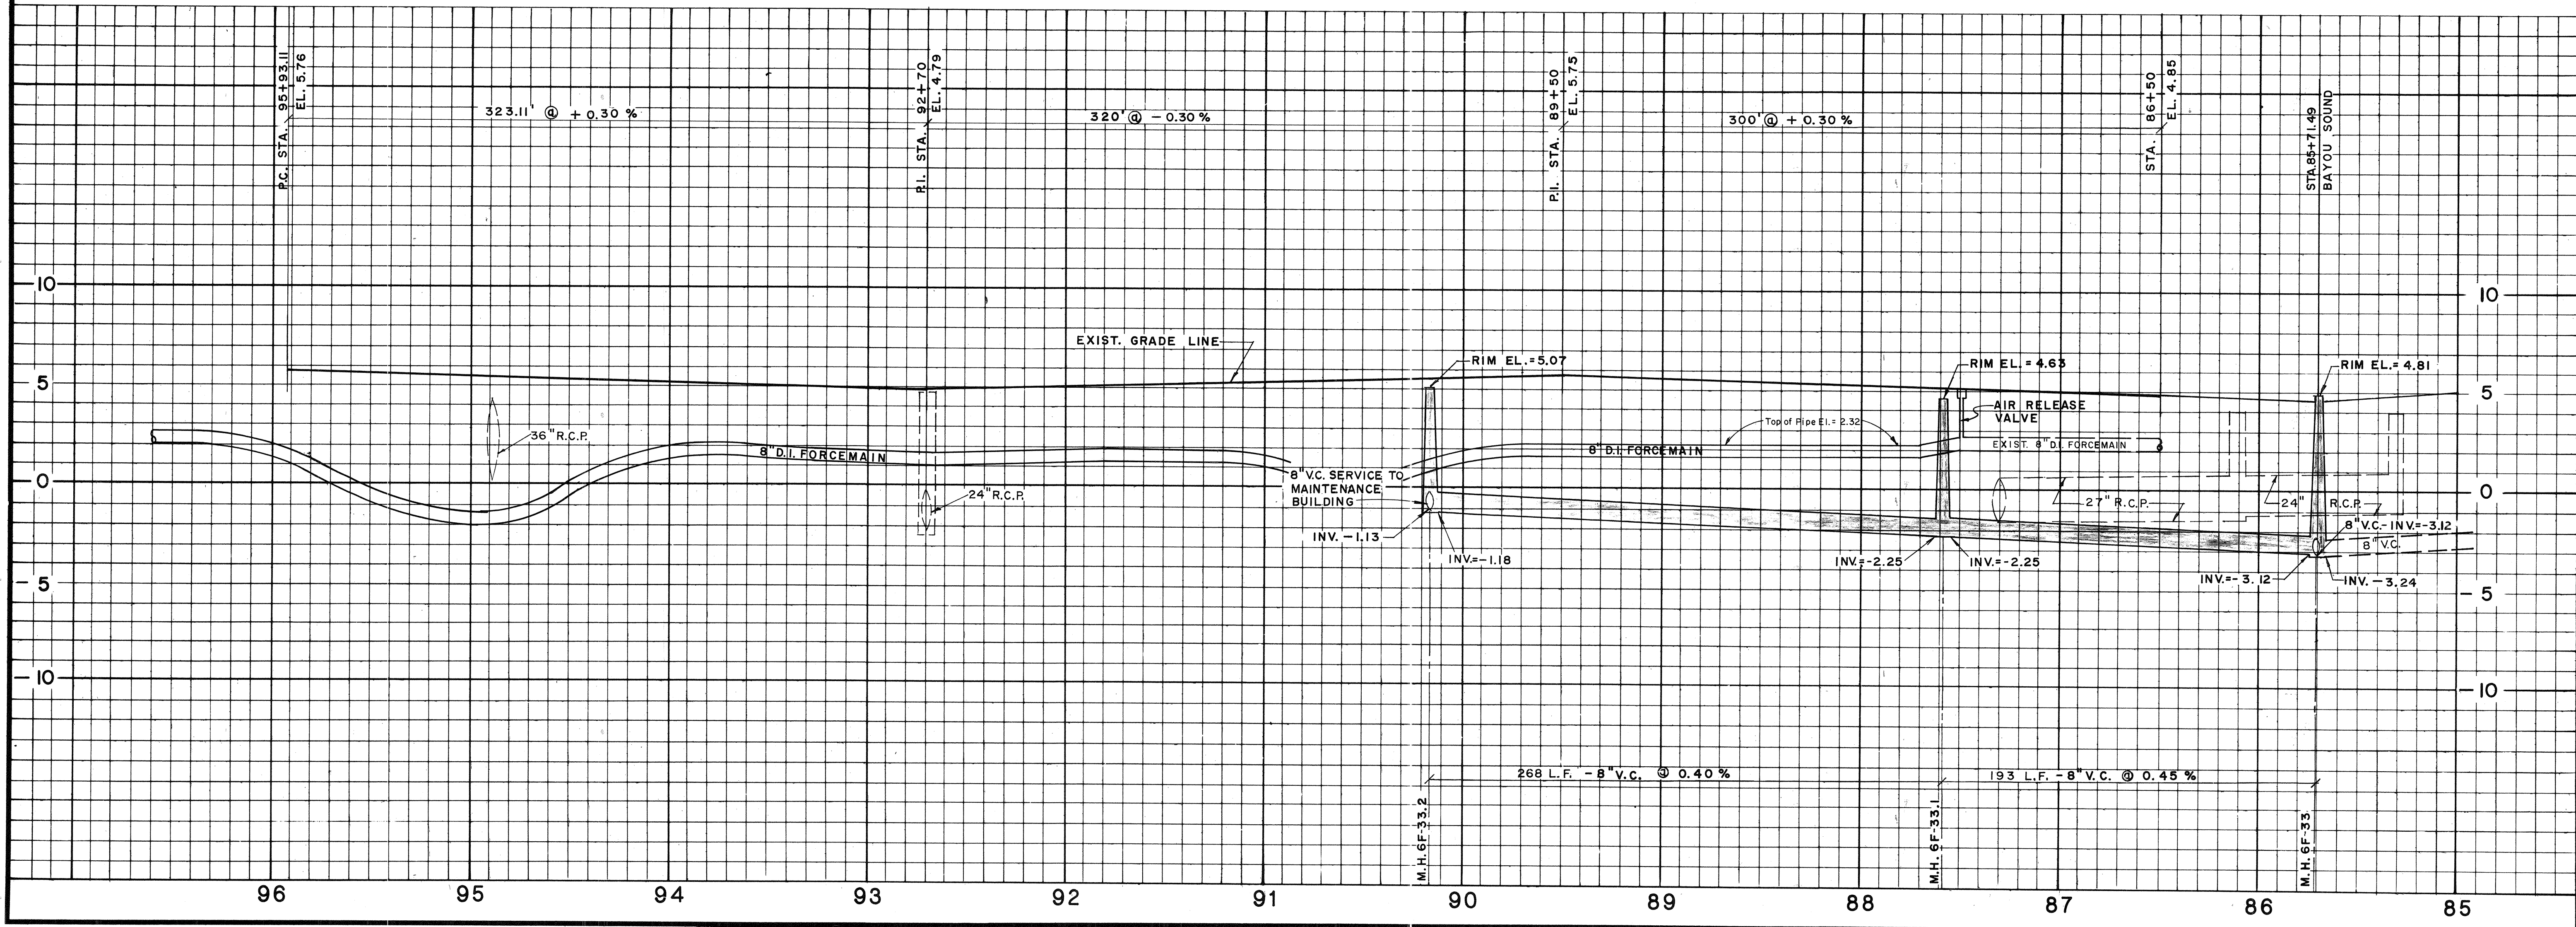

FOR CONTINUATION  
 SEE SHEET No. 191-663 AB

FOR CONTINUATION  
 SEE SHEET No. 191-147 AB

FOR CONTINUATION  
 SEE SHEET No. 191-137 AB

TOWN OF LONGBOAT KEY, FLORIDA ARVIDA CORPORATION RECORD DRAWING OF: HARBOURSIDE DRIVE BENNETT & BISHOP INC. ENGINEERS & SURVEYORS	PROJECT ENGINEER
	DATE:
DESIGNED BY:	CHECKED BY: PROJECT NO. 191-32
SCALE: HORIZ. 1"=40' VERT. 1"=4'	DRAWN BY: J.R. REESE FEB. 1985
REVISION	PHONE 371-8362
LTR. DATE	SARASOTA, FLORIDA
4509 BEE RIDGE ROAD	ENGINEERS & SURVEYORS
SHEET NUMBER 191-662 AB	T.L.K. FILE NO.
REVISION	ARVIDA CORPORATION