



SARASOTA

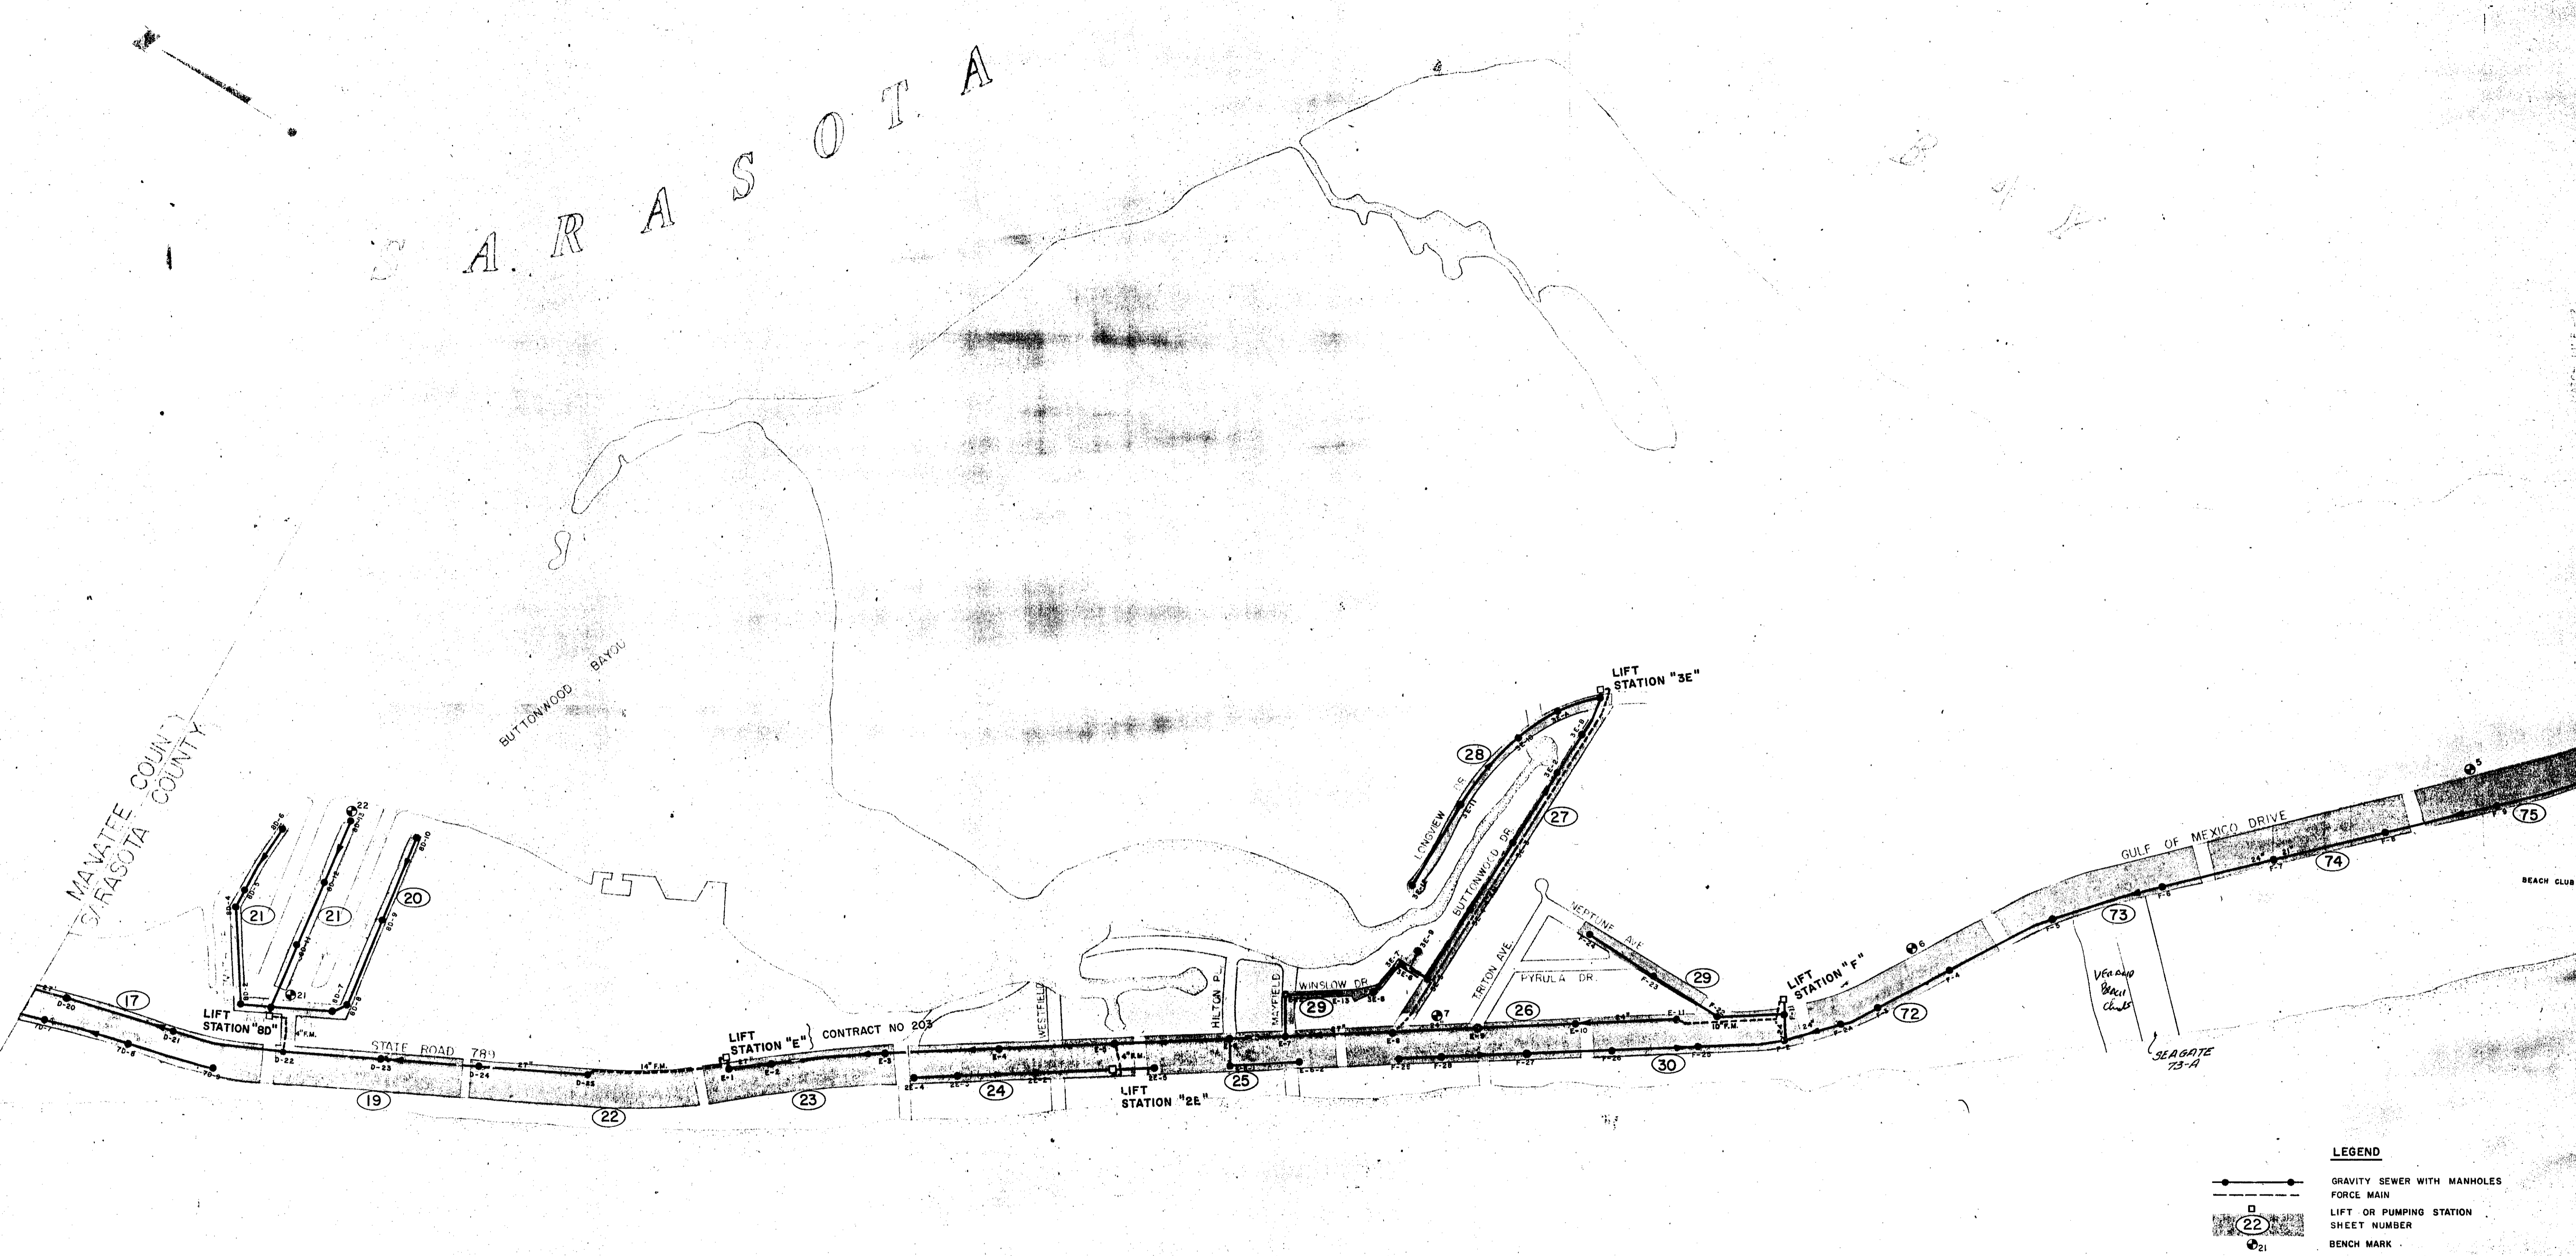

GULF OF MEXICO

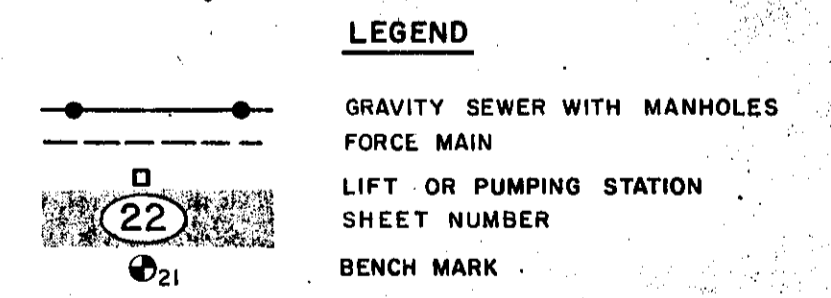

**NOTE:**  
 ALL GRAVITY LINES ARE 8" UNLESS OTHERWISE NOTED.  
 ALL CONSTRUCTION TO BE UNDER CONTRACT NO 201, UNLESS OTHERWISE INDICATED.

SARASOTA COUNTY

AS BUILT PLANS  
 Date: 12/12/75

DATE	REVISION	BY	SCALE	DATE	DESIGNED BY	TOWN OF LONGBOAT KEY, FLORIDA	APPROVED BY	SHEET NUMBER
3-7-73	GENERAL REVISION	J.L.	1"=400'	OCT. 20, 1972	J.D.W., E.M.	MASTER INDEX	J. DAVID YEAGER, P.E.	5
1-22-75	REVISIONS ON SHEETS 23, 24, & 25	L.D.L.				WASTEWATER COLLECTION SYSTEM	FLORIDA CERT. NO 12601	
1-30-75	REVISIONS ON SHEET 25	R.C.W.			U.L.L., S.M.C.	LONGBOAT KEY, FLORIDA	REVISION	"E"
2-24-75	REVISIONS FROM SHEETS 27, 28, & 72	L.J.V.			J.G., M.W.			
2-22-75	ADD 2" DIA. 12"	L.V.G.			EC	1217-S		
SMALLY, WELLFORD & NALVEN — CONSULTING ENGINEERS — SARASOTA, FLORIDA								