


AS BUILT PLANS
Date 12/2/15

TOWN OF LONGBOAT KEY, FLORIDA
GULF OF MEXICO DRIVE
W. MH 2D-9 TO MH 2D-11, E. MH D-4 TO MH D-5
WASTEWATER COLLECTION SYSTEM

FOR: LTR. DATE	AS BUILT	2-19-75
SCALE:	HORIZ. 1" = 40'	VERT. 1" = 4'
DATE:	4-13-73	
DESIGNED BY:	J.O.W. E.M.N.	7.0.7
CHECKED BY:	J.D.W. E.M.N.	1217-S
APPROVED BY:		

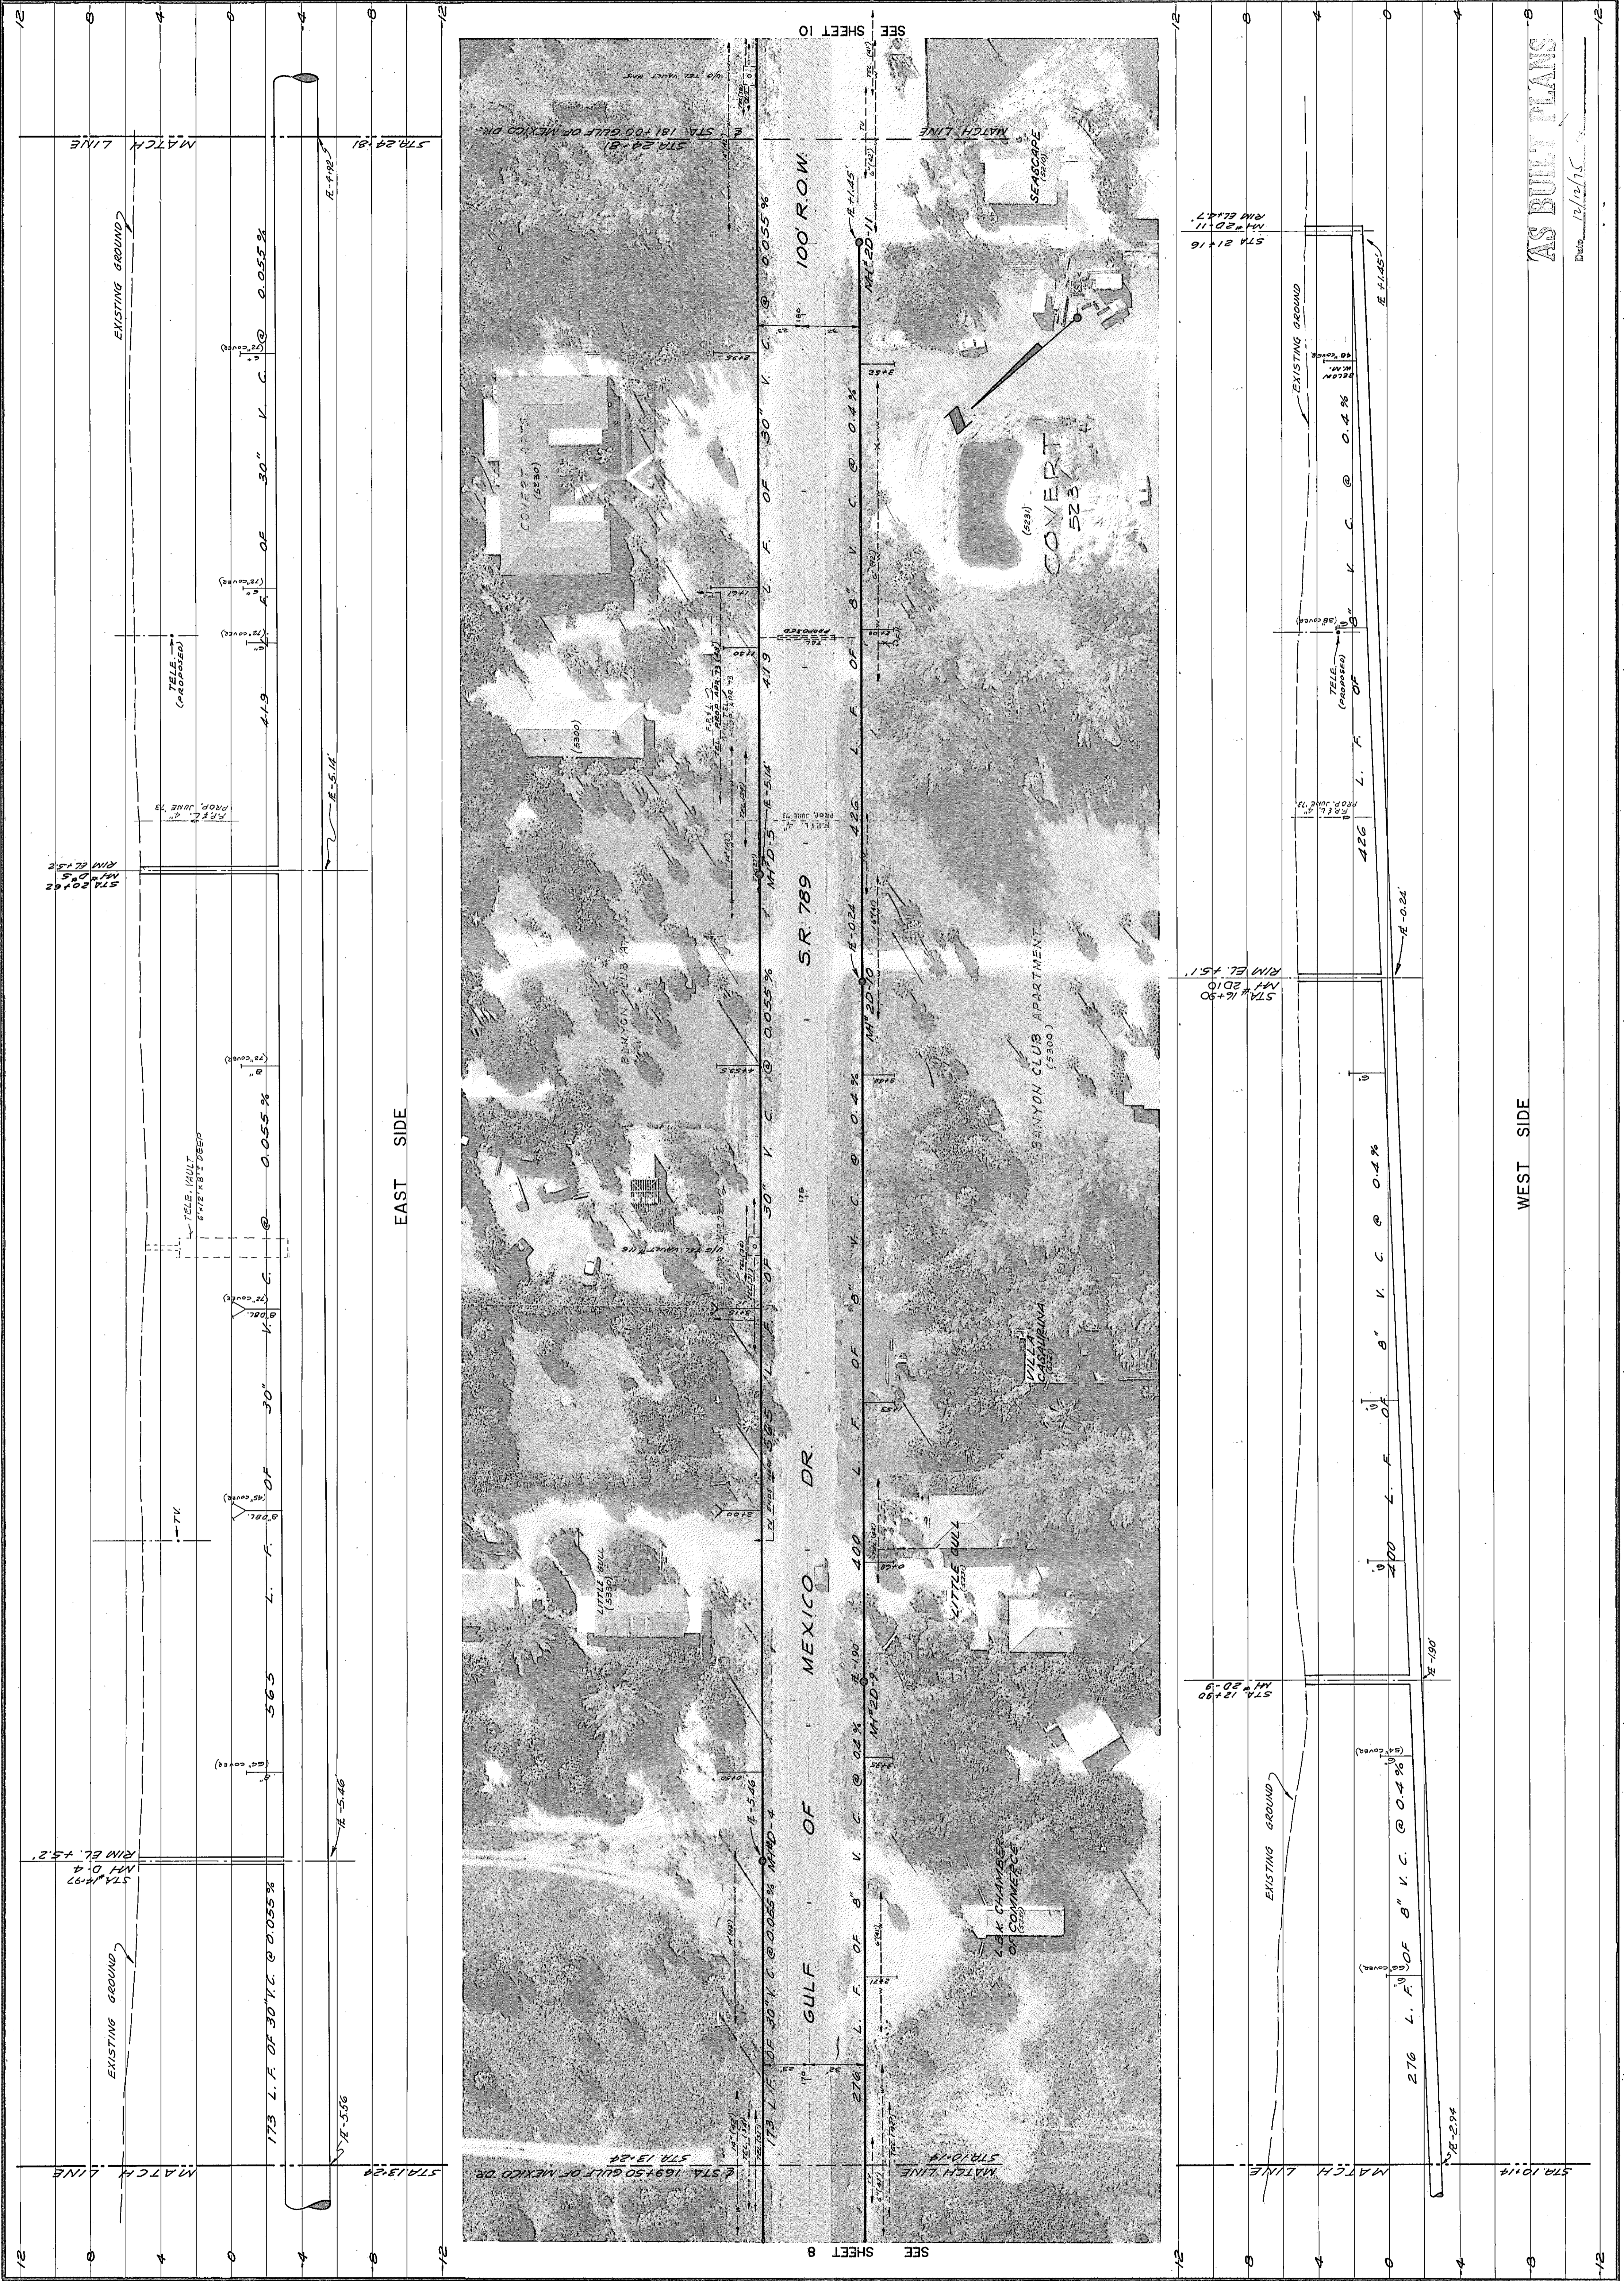

SEE SHEET 8	SEE SHEET 10
-------------	--------------