


GULF OF MEXICO DRIVE  
 W M 6D-5 TO M 6D-3, E M 6D-6 TO M 6D-7  
 WASTEWATER COLLECTION SYSTEM

TOWN OF LONGBOAT KEY, FLORIDA

SMALLY, WELLFORD & NALVEN—CONSULTING ENGINEERS—SARASOTA, FLORIDA

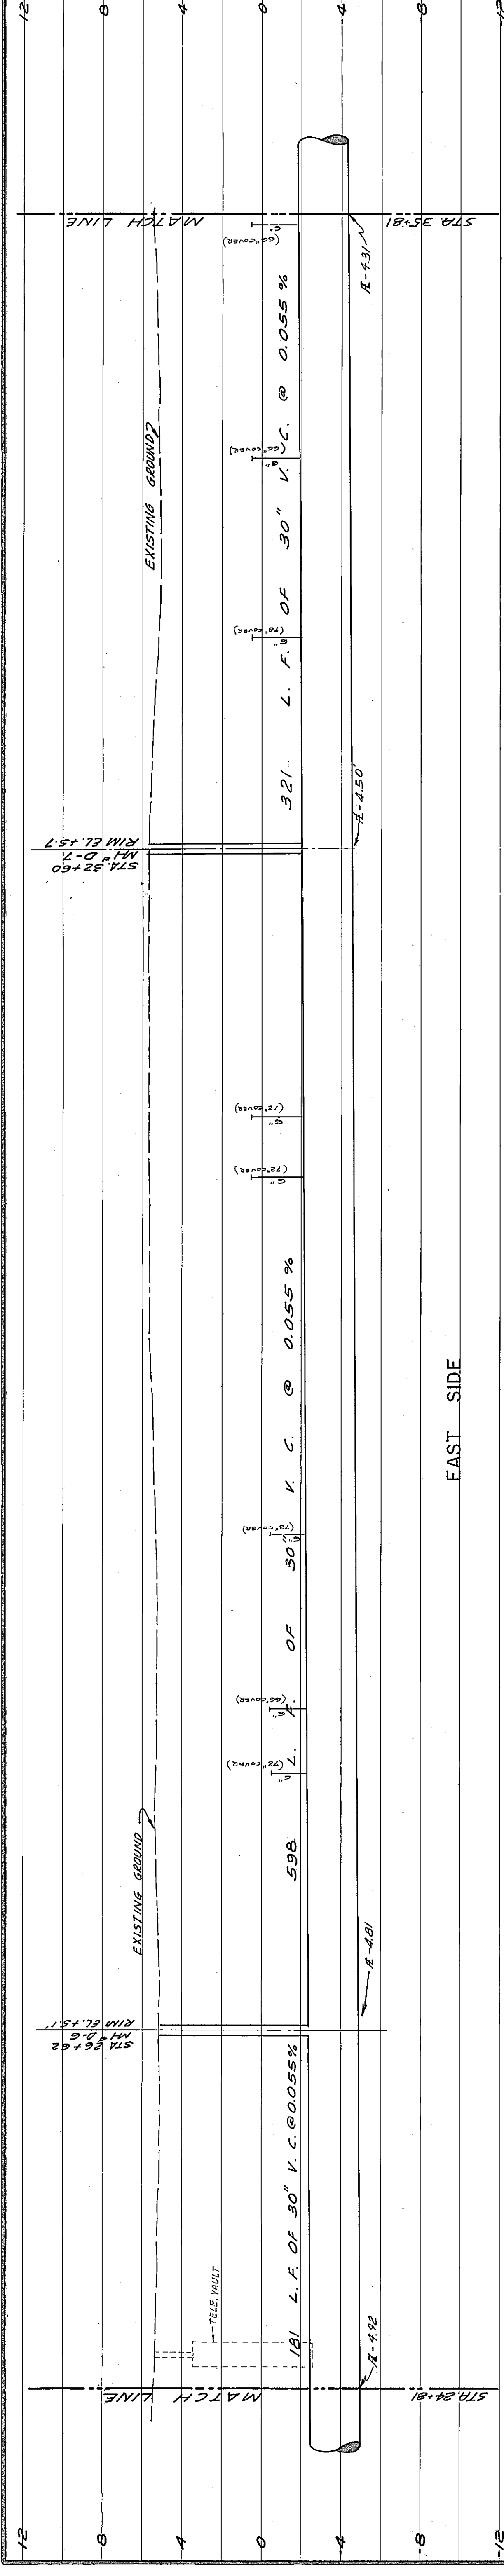

SEE SHEET 9  
 SEE SHEET 11

DATE: 4-13-73  
 DESIGNED BY: J.D.W. E.M.N.  
 CHECKED BY: U.G. M.W.  
 PROJECT NO. 1217-S

APPROVED BY: [Signature]  
 DATE: SEPT. 1972

SCALE: HORIZ. 1"=40'  
 VERT. 1"=4'

BY: [Signature]  
 DATE: 2-19-75

REVISION: AS BUILT FROM M 6D-5 TO M 6D-3 & E M 6D-6 TO M 6D-7  
 RELOCATED M 6D-3, M 6D-5 & E M 6D-6 TO M 6D-7

PHOTO: BOSWORTH AERIAL SURVEYS  
 DATE: SEPT. 1972