



EAST SIDE

SEE SHEET 29

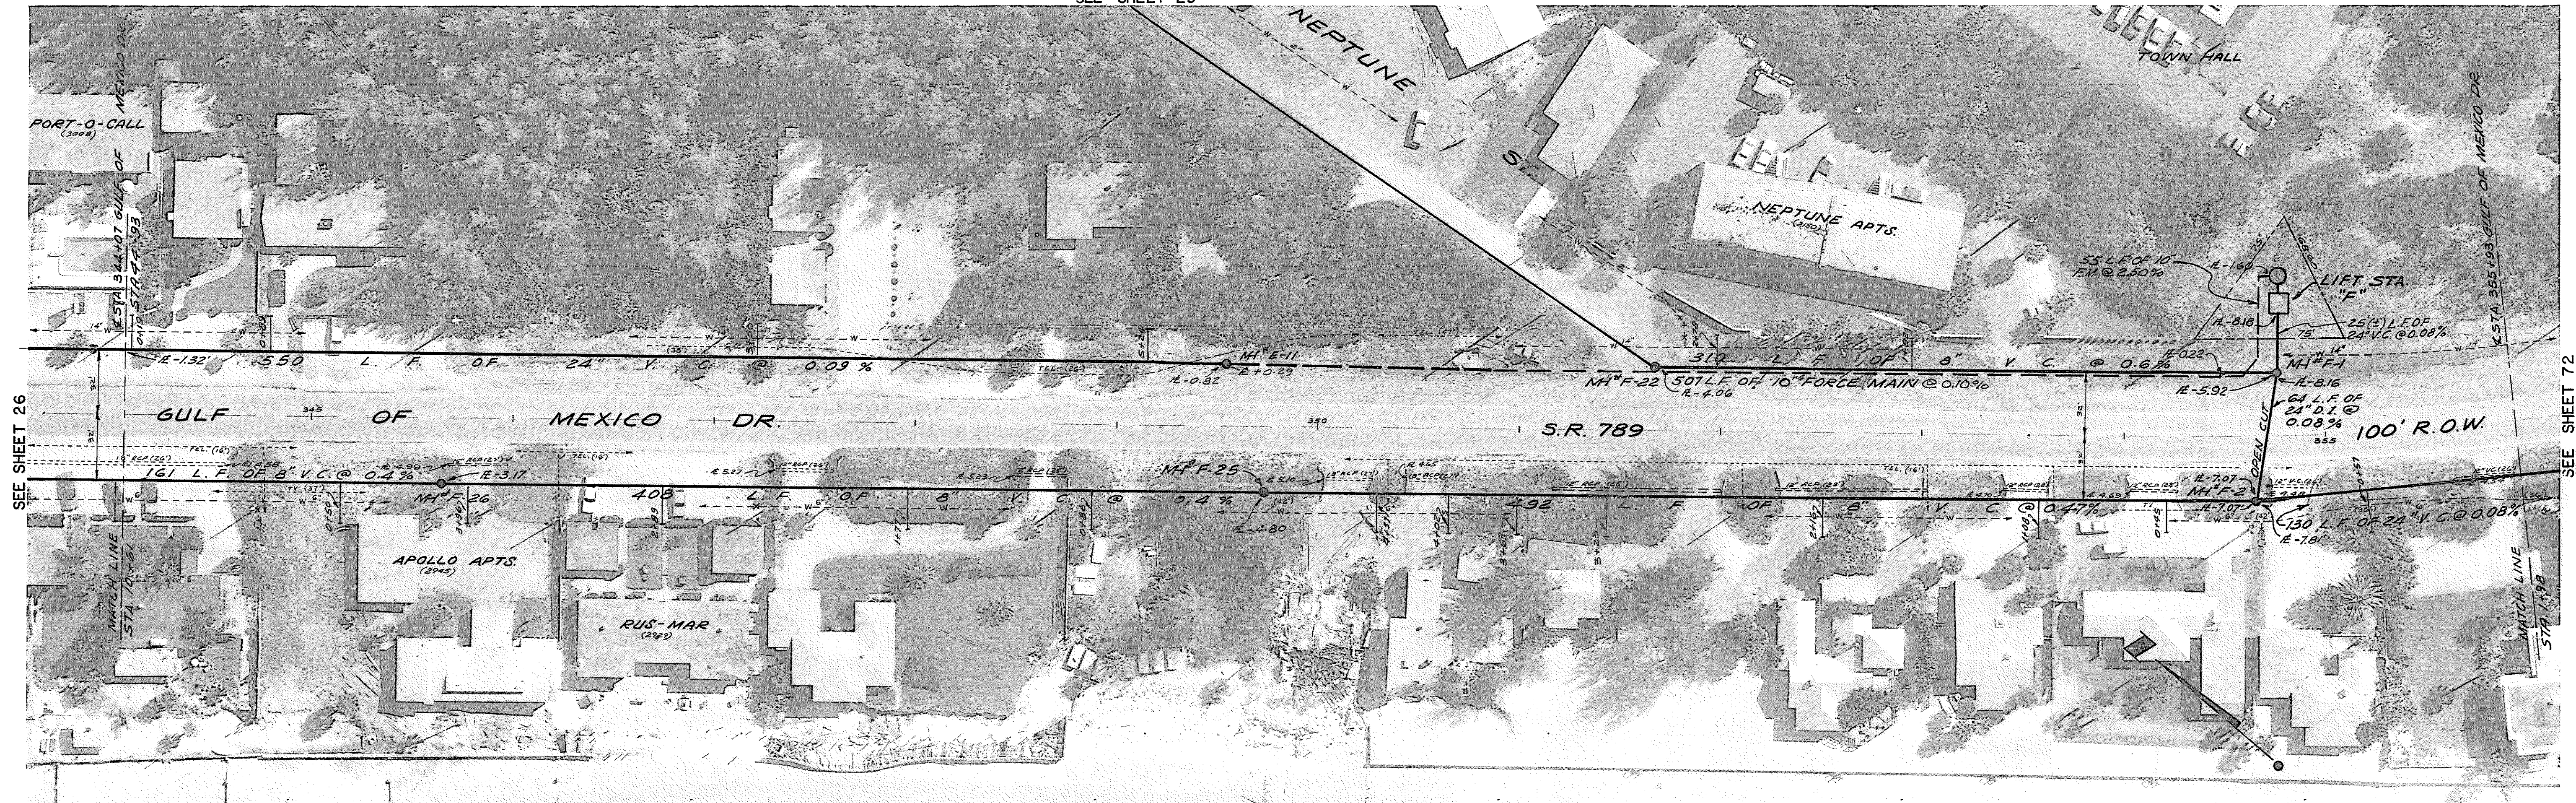

WEST SIDE

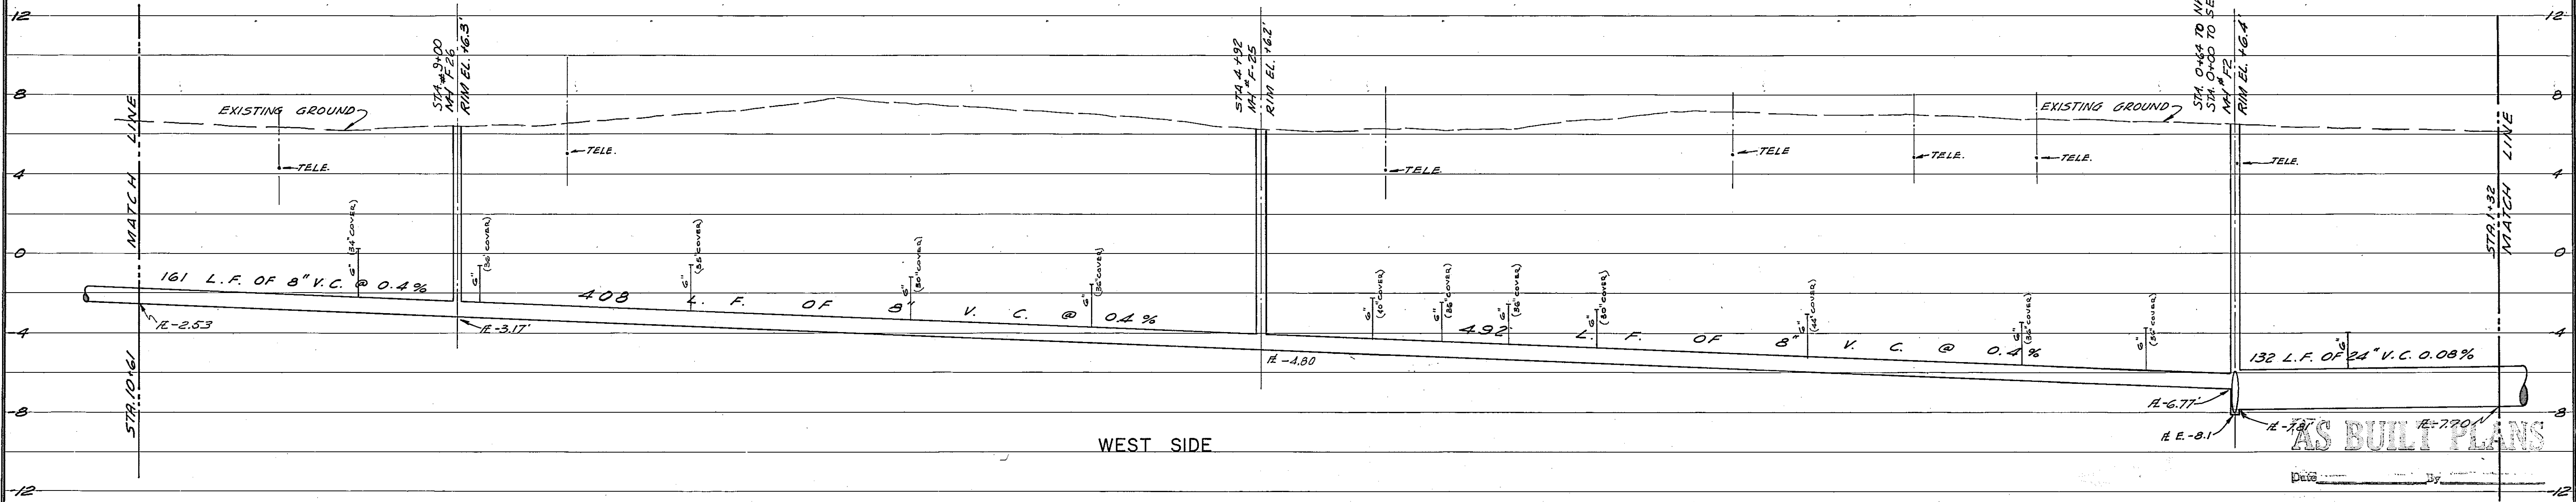

DESIGNED BY J.D.M., E.M.A. C.O.C.	APPROVED BY J. DAVID WEAVER, P.E. REGISTERED PROFESSIONAL ENGINEER
DATE 4-13-73	CHECKED BY J.S., M.H. E.C.
SCALE: HORIZ. 1"=40' VERT. 1"=4'	PROJECT NO. 1217-S
BY P.C.W.	REVISION RELOCATED MH F-25, F-26, F-27, F-28, F-29, F-30 AS BUILT
LTR. DATE 7/18/75	DATE 7/18/75
FOR: TOWN OF LONGBOAT KEY, FLORIDA GULF OF MEXICO DRIVE W. MH F-26 TO MH F-2, E. MH F-11 TO MH F-1 WASTEWATER COLLECTION SYSTEM	
SHEET NUMBER 30	
REVISION A	

SMALLY, WELLFORD & NALVEN—CONSULTING ENGINEERS—SARASOTA, FLORIDA

INDEX NO. E-1217-235