


SEE SHEET 31



SEE SHEET 31

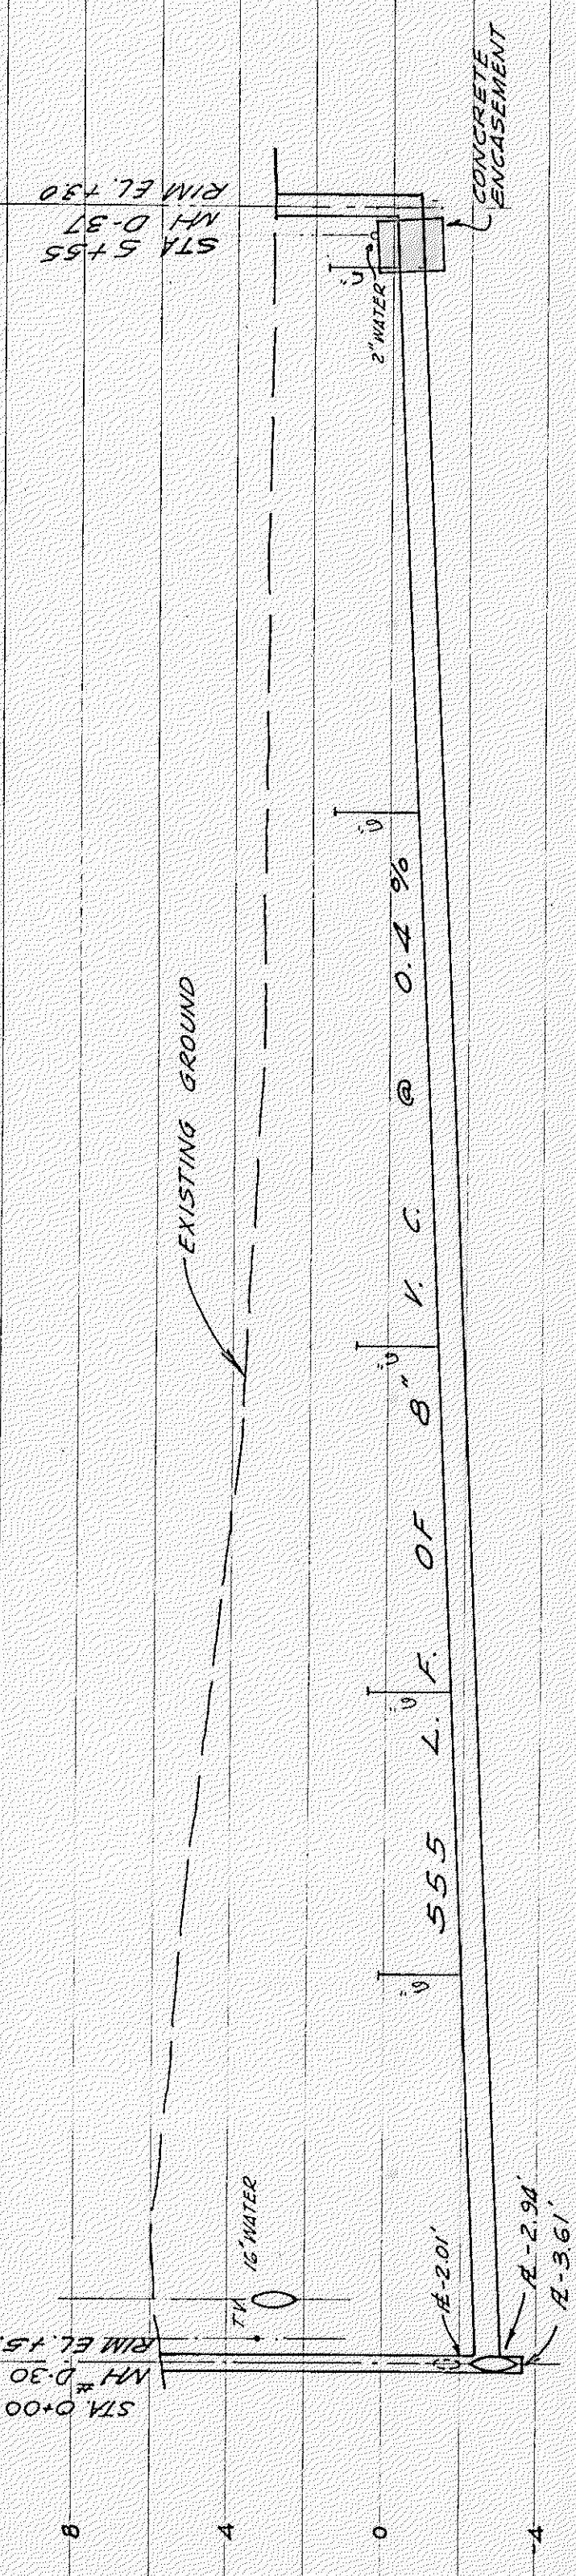

6



NO CONSTRUCTION

AS BUILT PLANS

REVISION 'A'
32

Record mylar

FOR: TOWN OF LONGBOAT KEY, FLORIDA		LTR. DATE	7/15/75	ADDED SERVICES, RELOCATED M.D. 97	REVISION	BY	SCALE: HORIZ. 1"=40' VERT. 1"=4'	DRAWN BY PCW	CHECKED BY J.G. M.W. EG	DESIGNED BY J.D.W. E.M.N. - C.D.C.	APPROVED BY J. DAVID WEAVER, P.E. PHOTO: BOB WORTH AERIAL SURVEYS FLORIDA CERT. NO. 2301	
COMPANION WAY		WASTEWATER COLLECTION SYSTEM		SMALLY, WELLFORD & NALVEN—CONSULTING ENGINEERS—SARASOTA, FLORIDA		INDEX NO. E-1217-237		SHEET NUMBER 32				REVISION 'A'