


AS BUILT PLANS

TOWN OF LONGBOAT KEY, FLORIDA  
WASTEWATER COLLECTION SYSTEM  
TARAWITT DR.

FOR: TOWN OF LONGBOAT KEY, FLORIDA	DATE: 7-23-73	BY: L.B.W.	SCALE: HORIZ. 1"=40'	DESIGNED BY: J.D.M./E.M.N.	APPROVED BY: [Signature]
REVISION	DATE	BY	SCALE	DESIGNED BY	APPROVED BY
1	7-23-73	L.B.W.	HORIZ. 1"=40'	J.D.M./E.M.N.	[Signature]
2					
3					

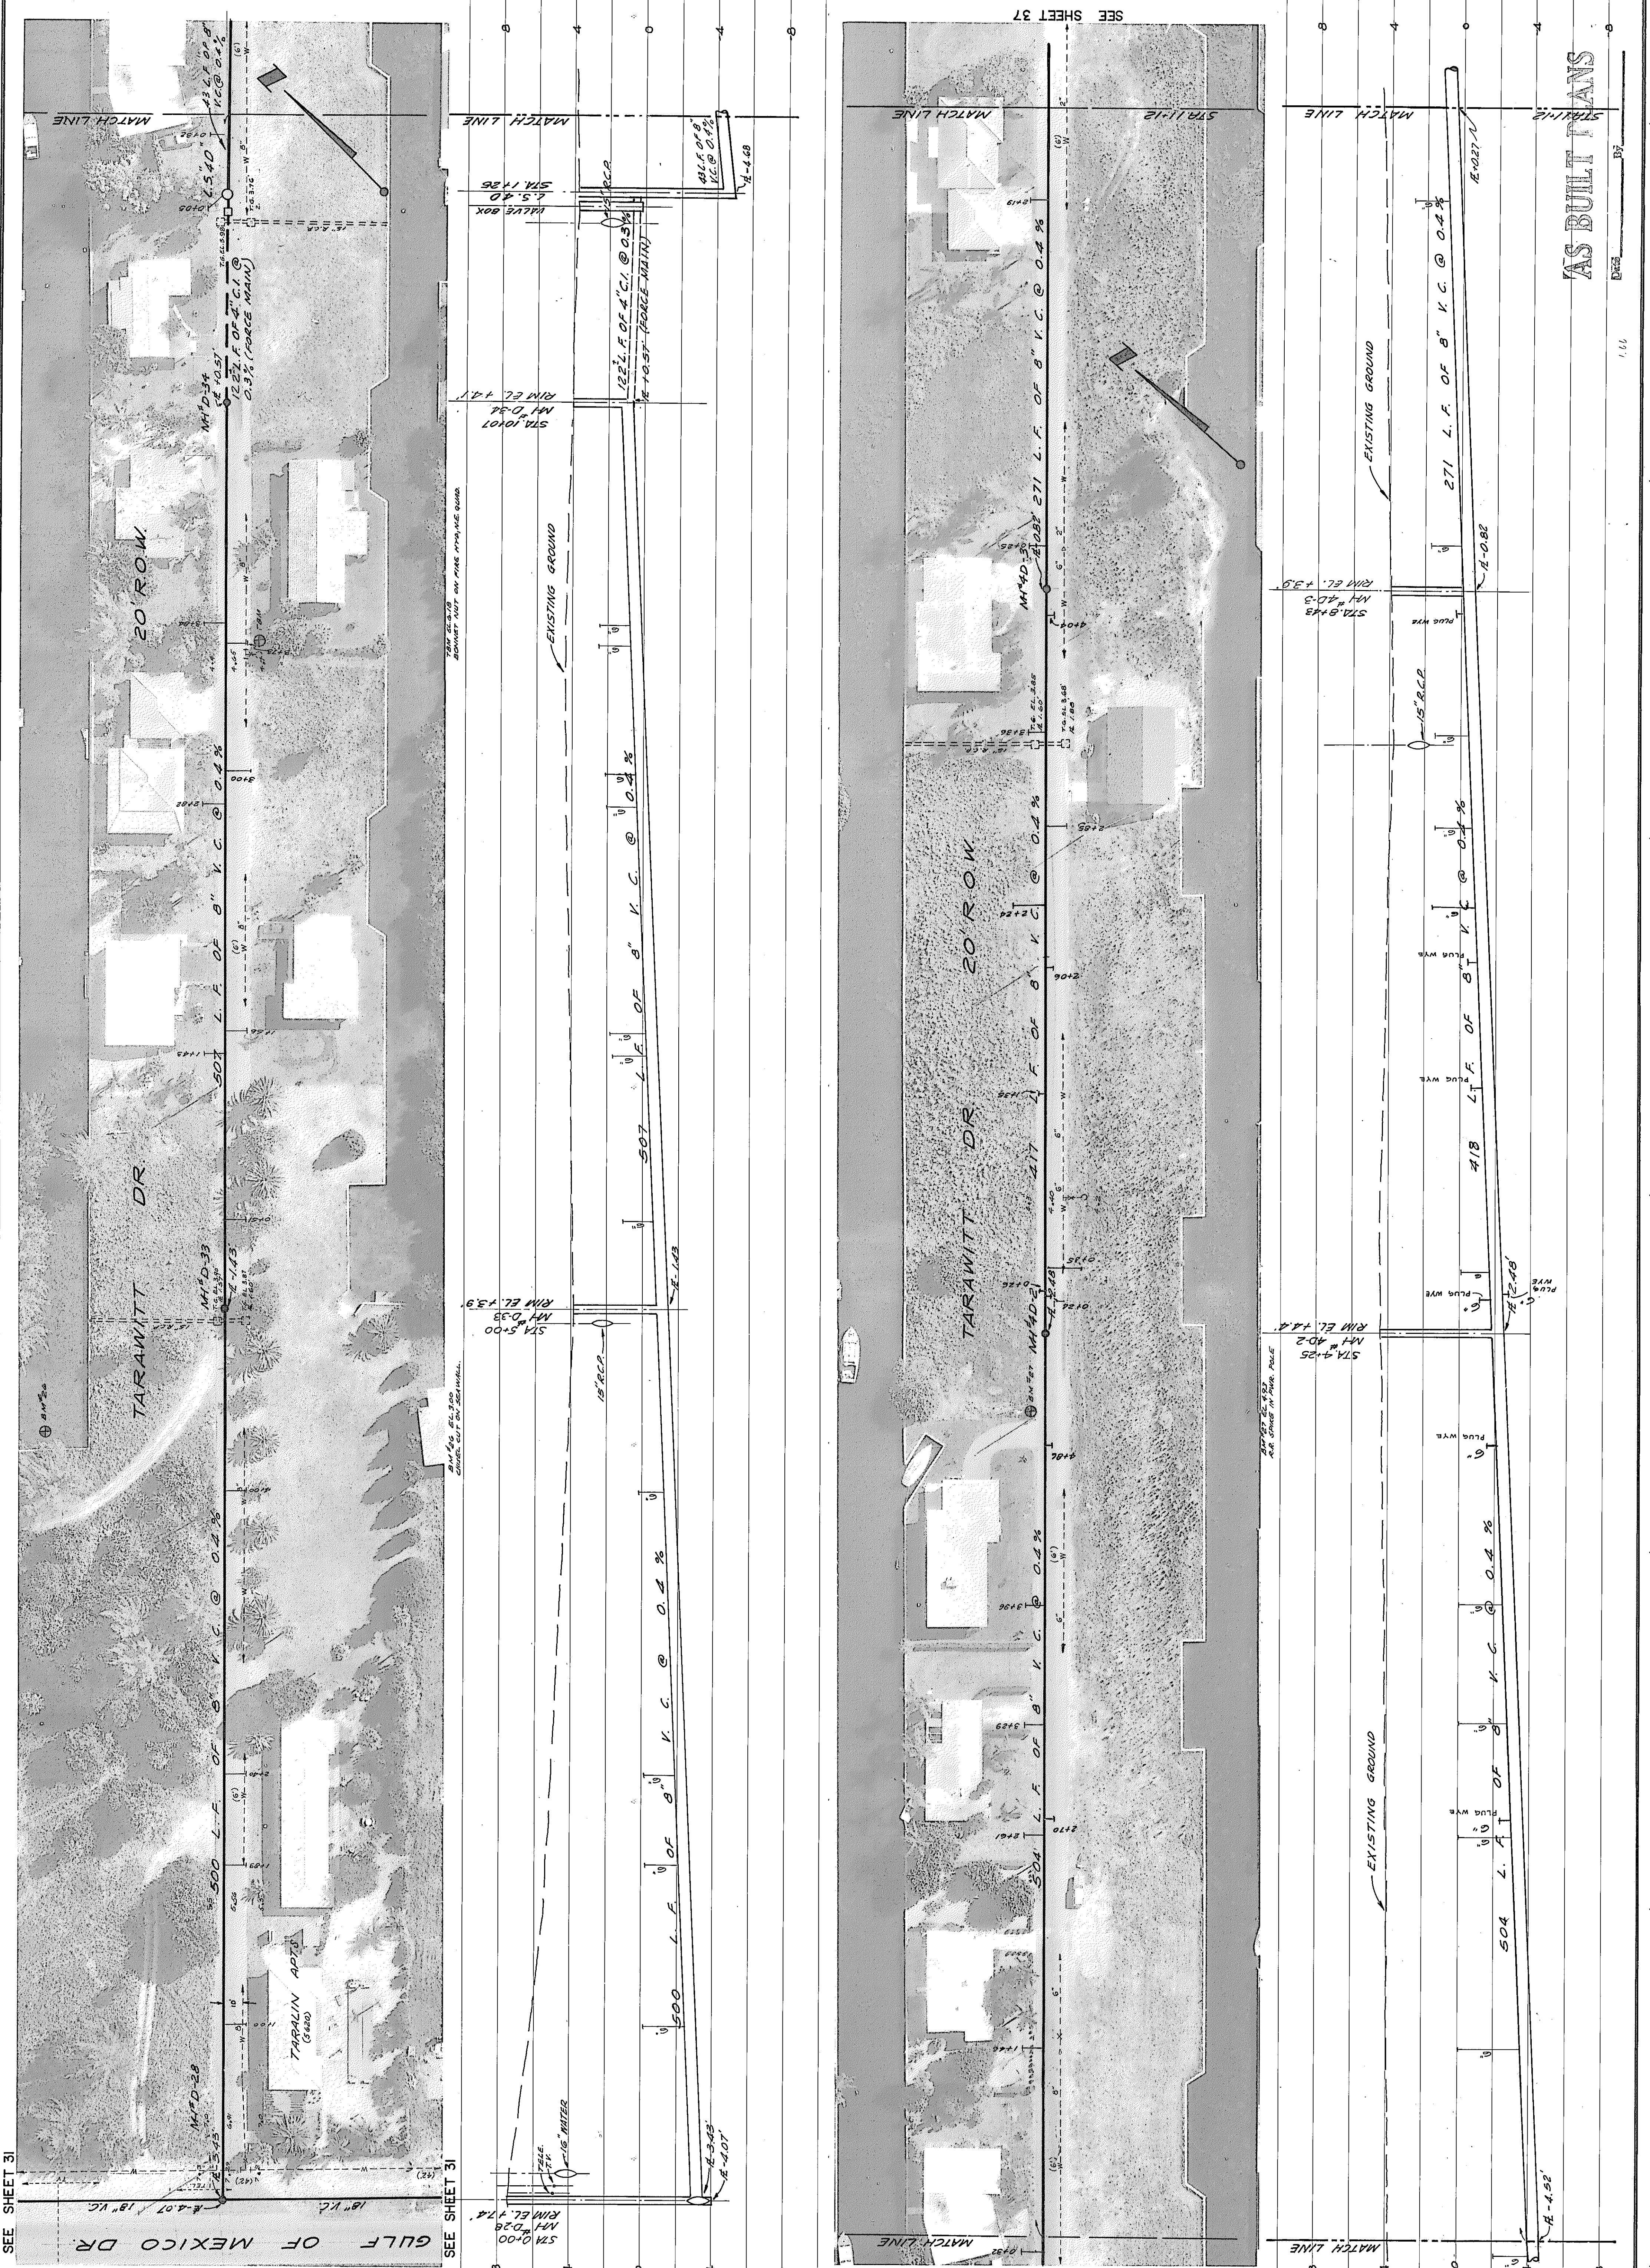

SEE SHEET 31

SEE SHEET 31

SEE SHEET 37

SEE SHEET 31