


SEE SHEET 32

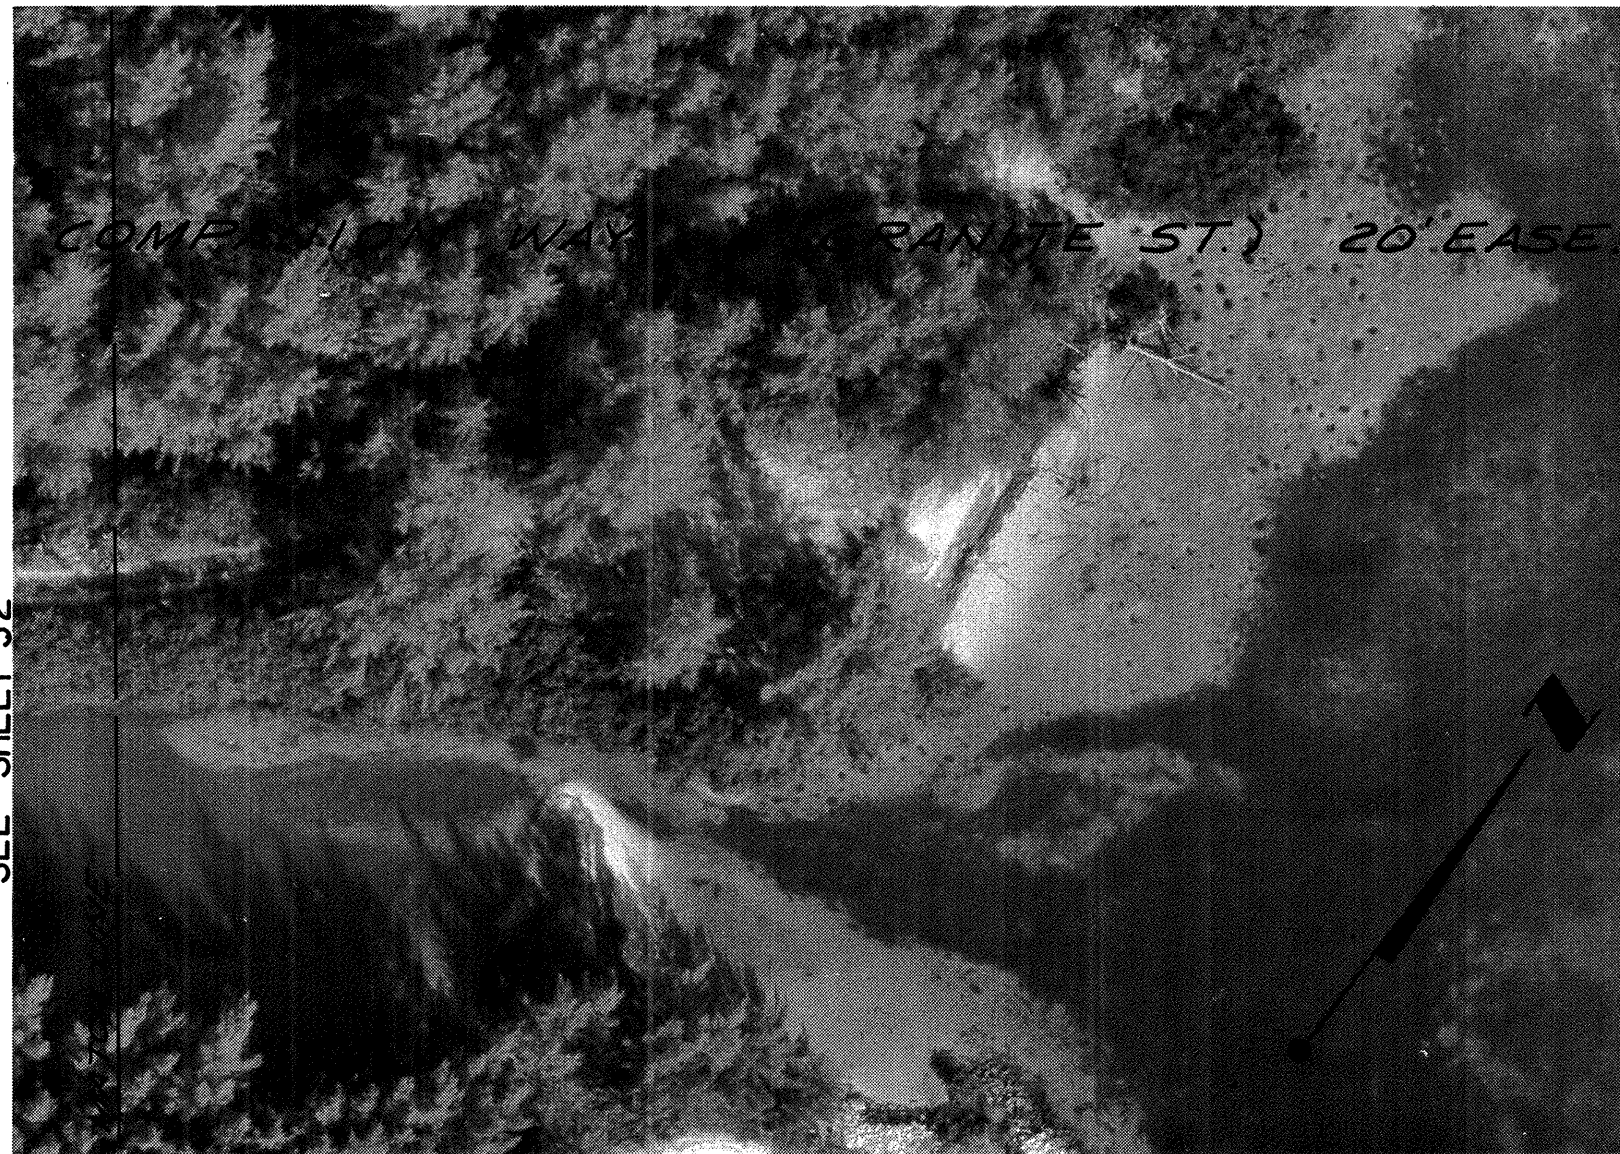

NO CONSTRUCTION

SEE SHEET 33





SEE SHEET 34



AS BUILT PLANS


SEE SHEET 36

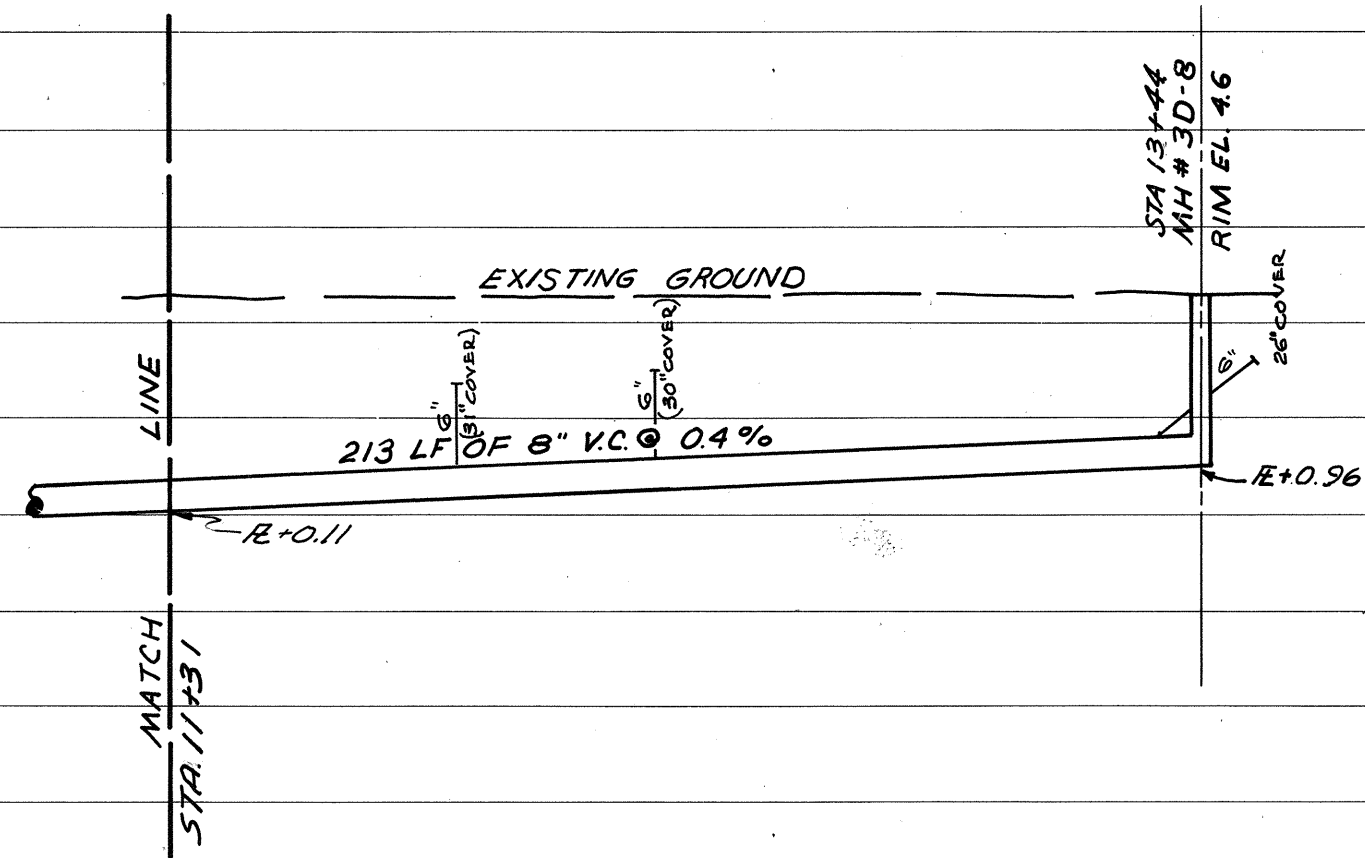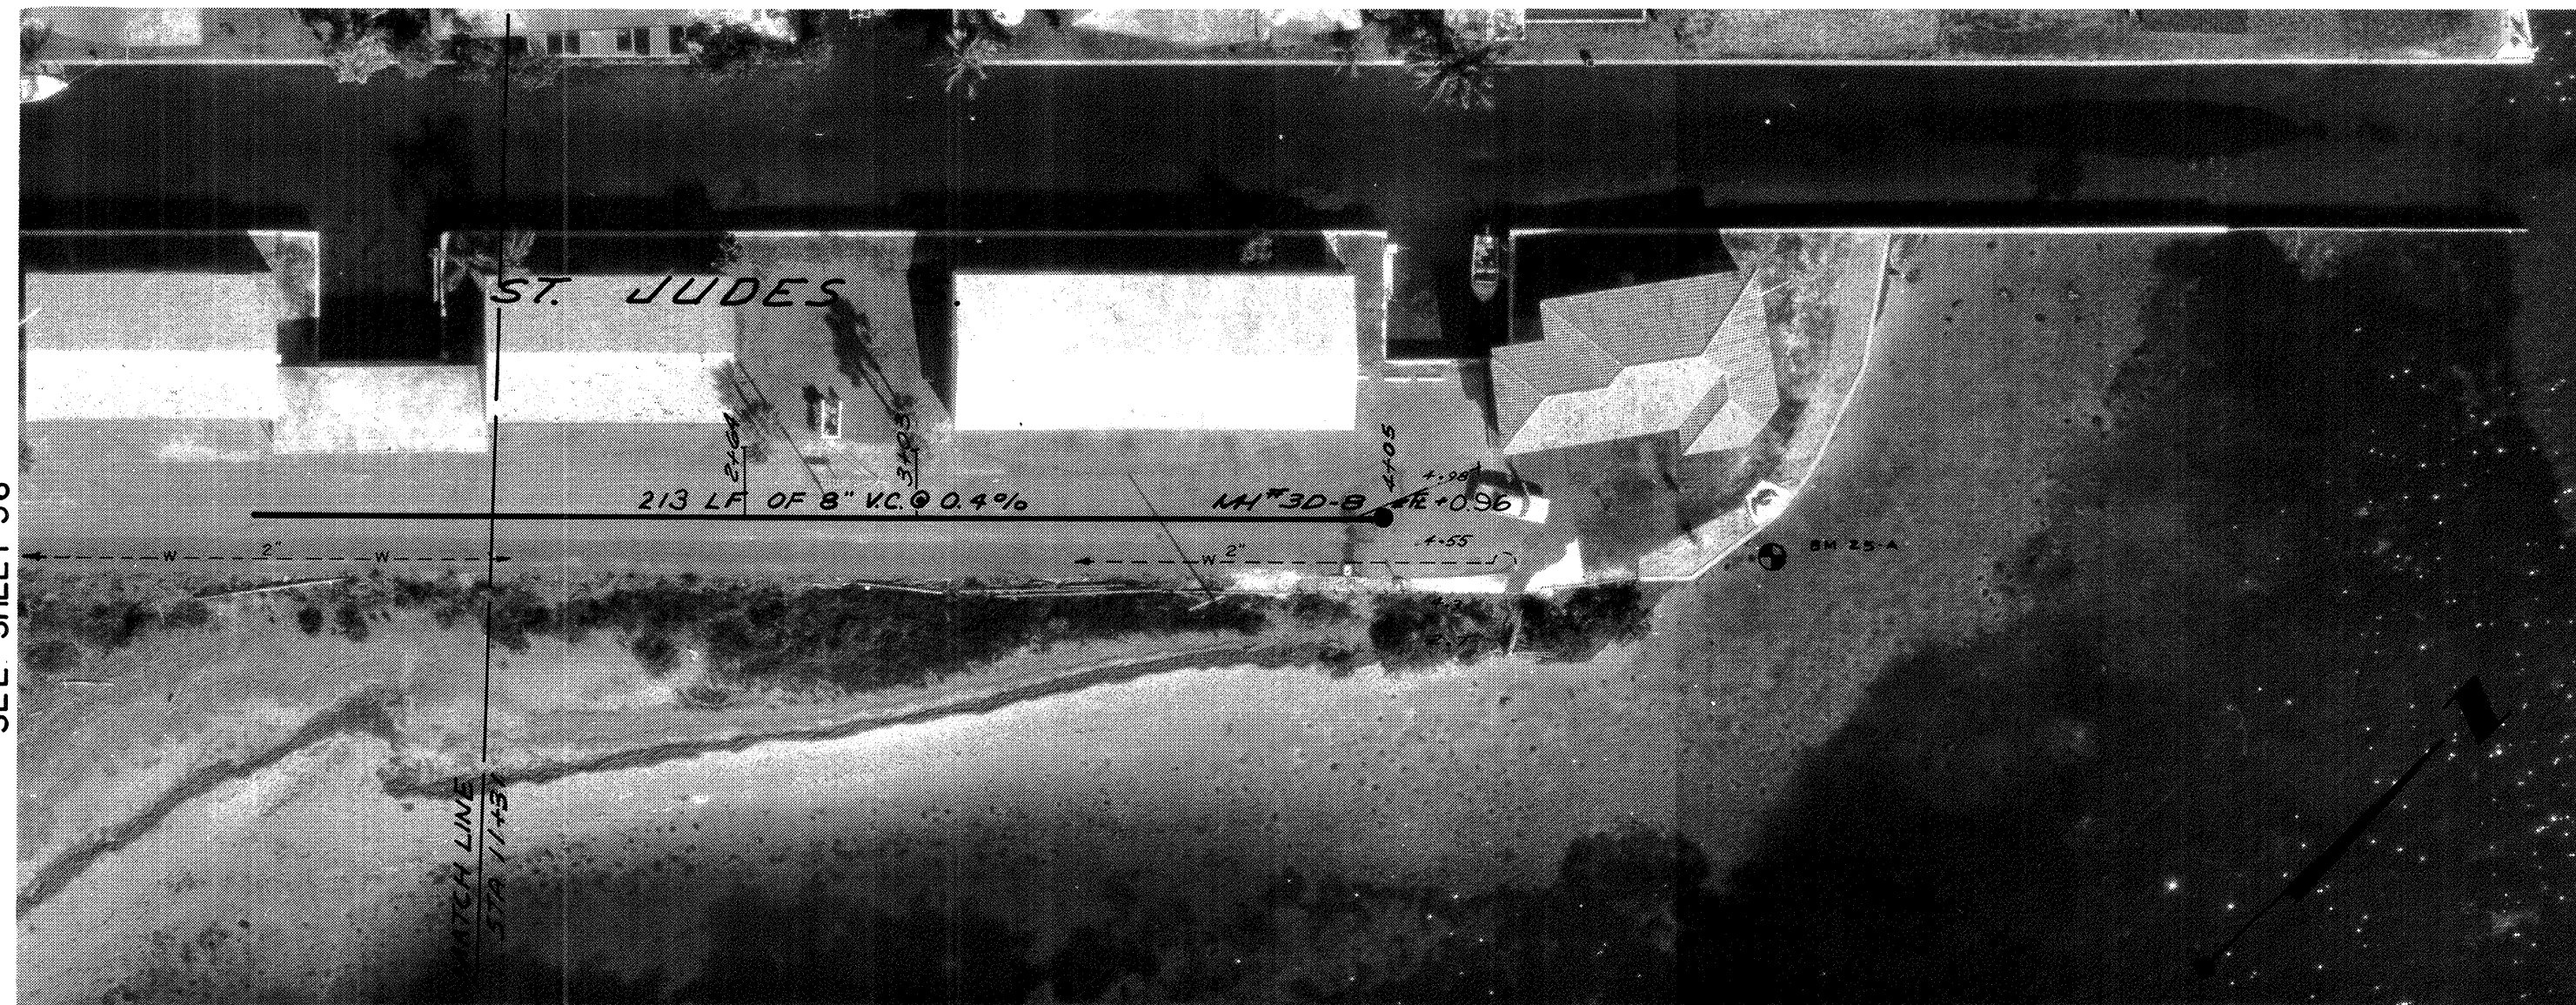


BM 25-A EL. 4.02 CHISEL CUT ON SEAWALL

SEE SHEET 35

SEE SHEET 36

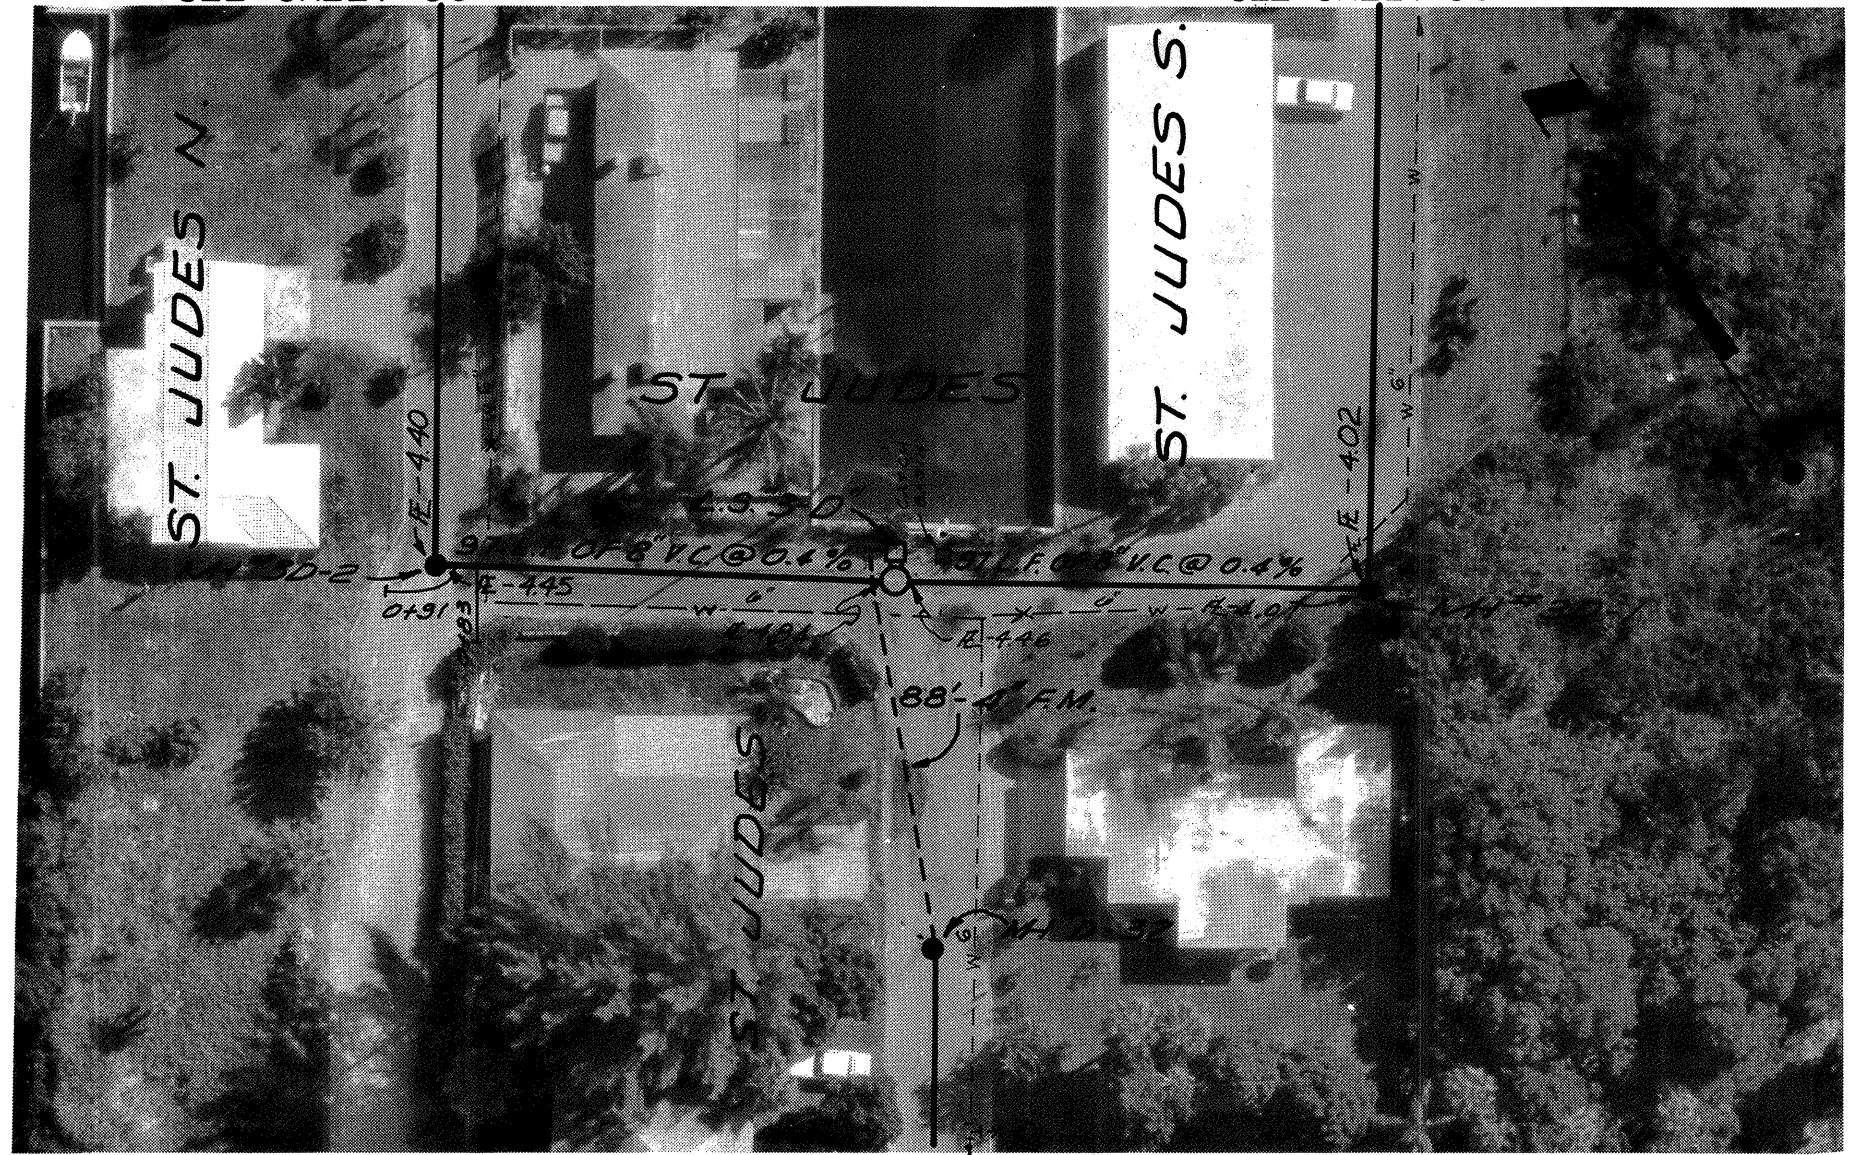

SEE SHEET 36

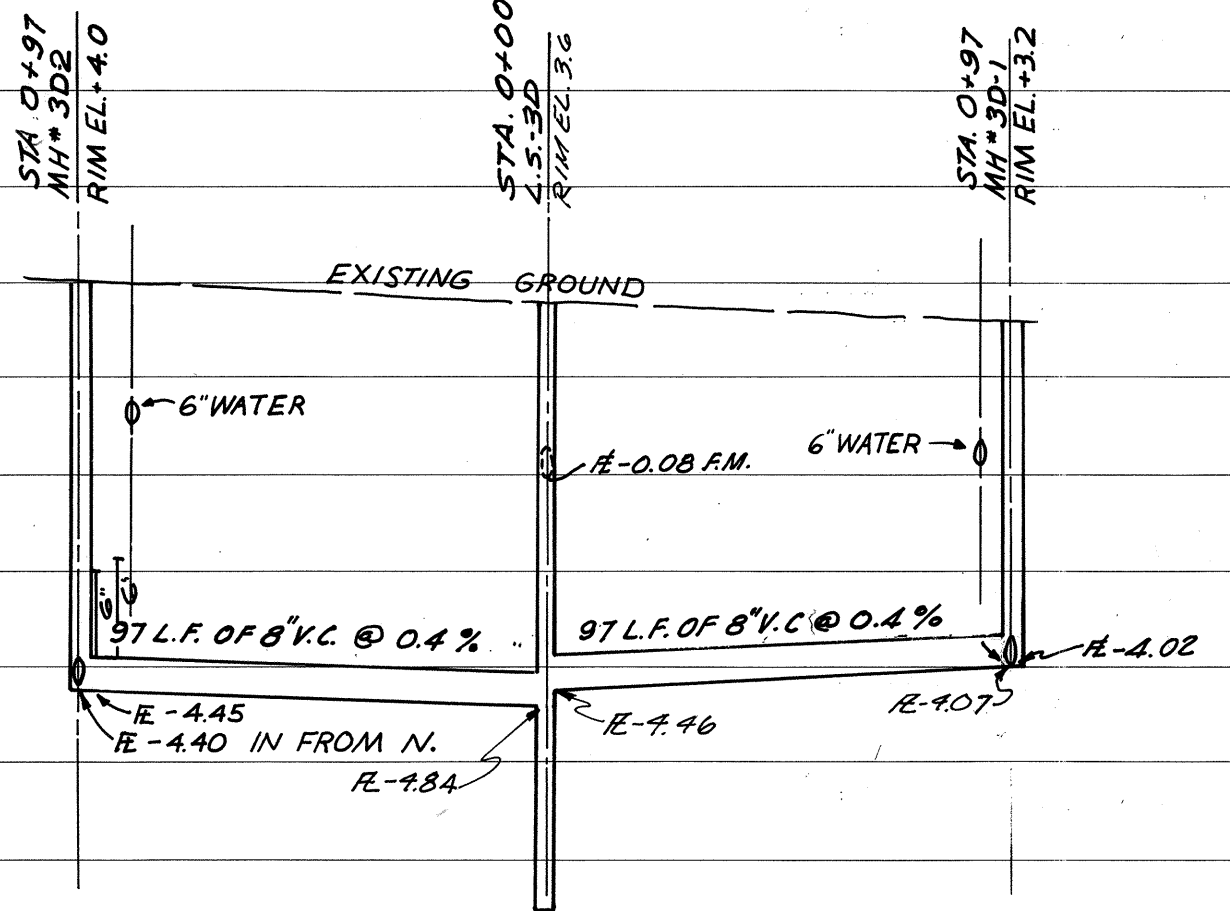

DESIGNED BY J.D.W./M.V.	DATE 4-13-73	SCALE HORIZ. 1"=40' VERT. 1"=4'	BY L.D.L.	REVISION REMOVE LINE FROM JUNGLE QUEEN WAY CHANGED ALIGNMENT OF 4" FM. FROM L.S. TO M.D. 35, MOVED M4104 ADDED SERVICES.	LTR. "A" "B" "C"	DATE 1-15-74 8-24-75	FOR TOWN OF LONGBOAT KEY, FLORIDA	INDEX NO. E-1217-242
CHECKED BY L.G.M./M.V.	PROJECT NO. 1217-S	DRAWN BY HMG	P.C.W.					
APPROVED BY J. DAVID WEARE, P.E. FLORIDA CERT. NO. 15301								