

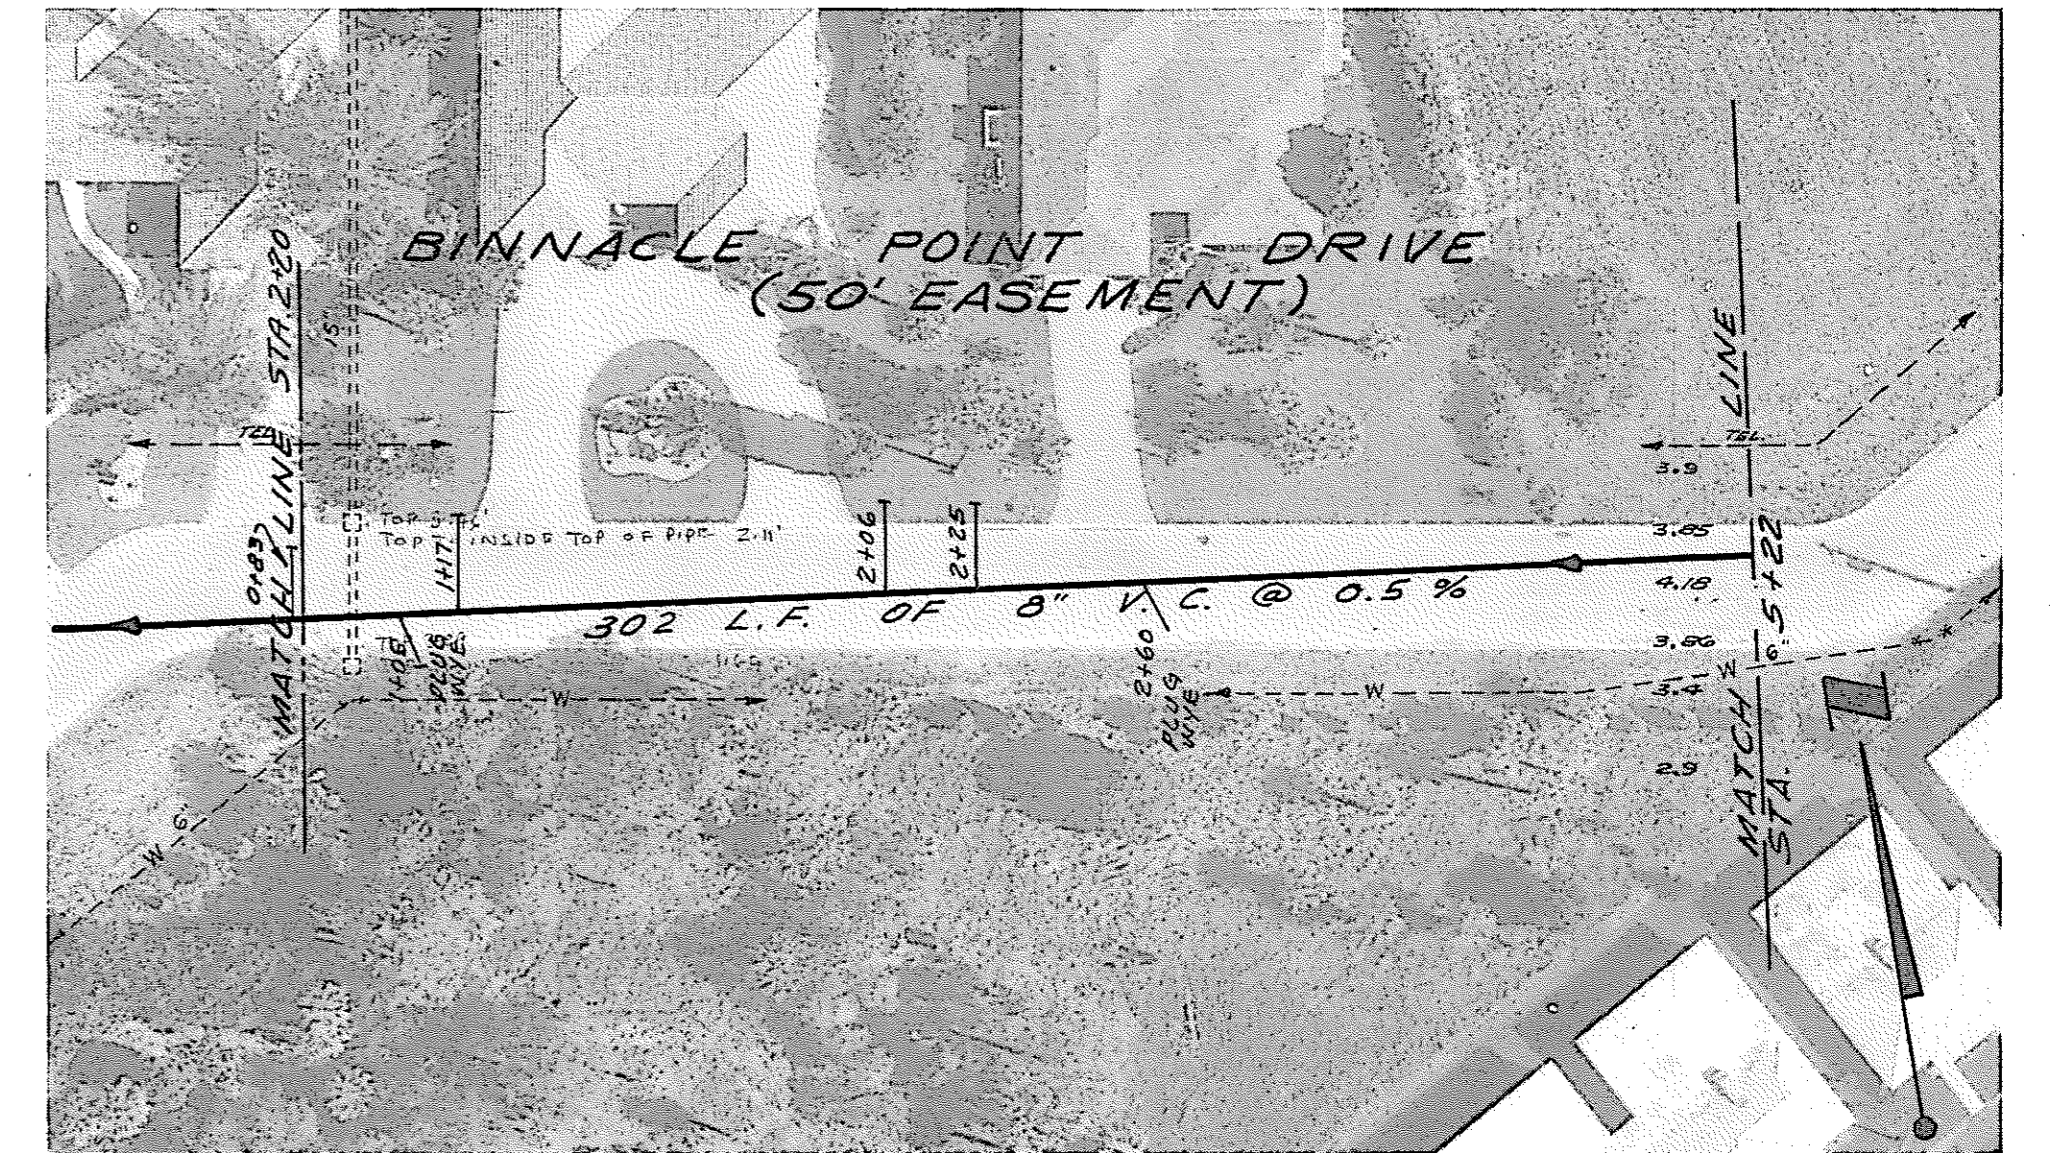
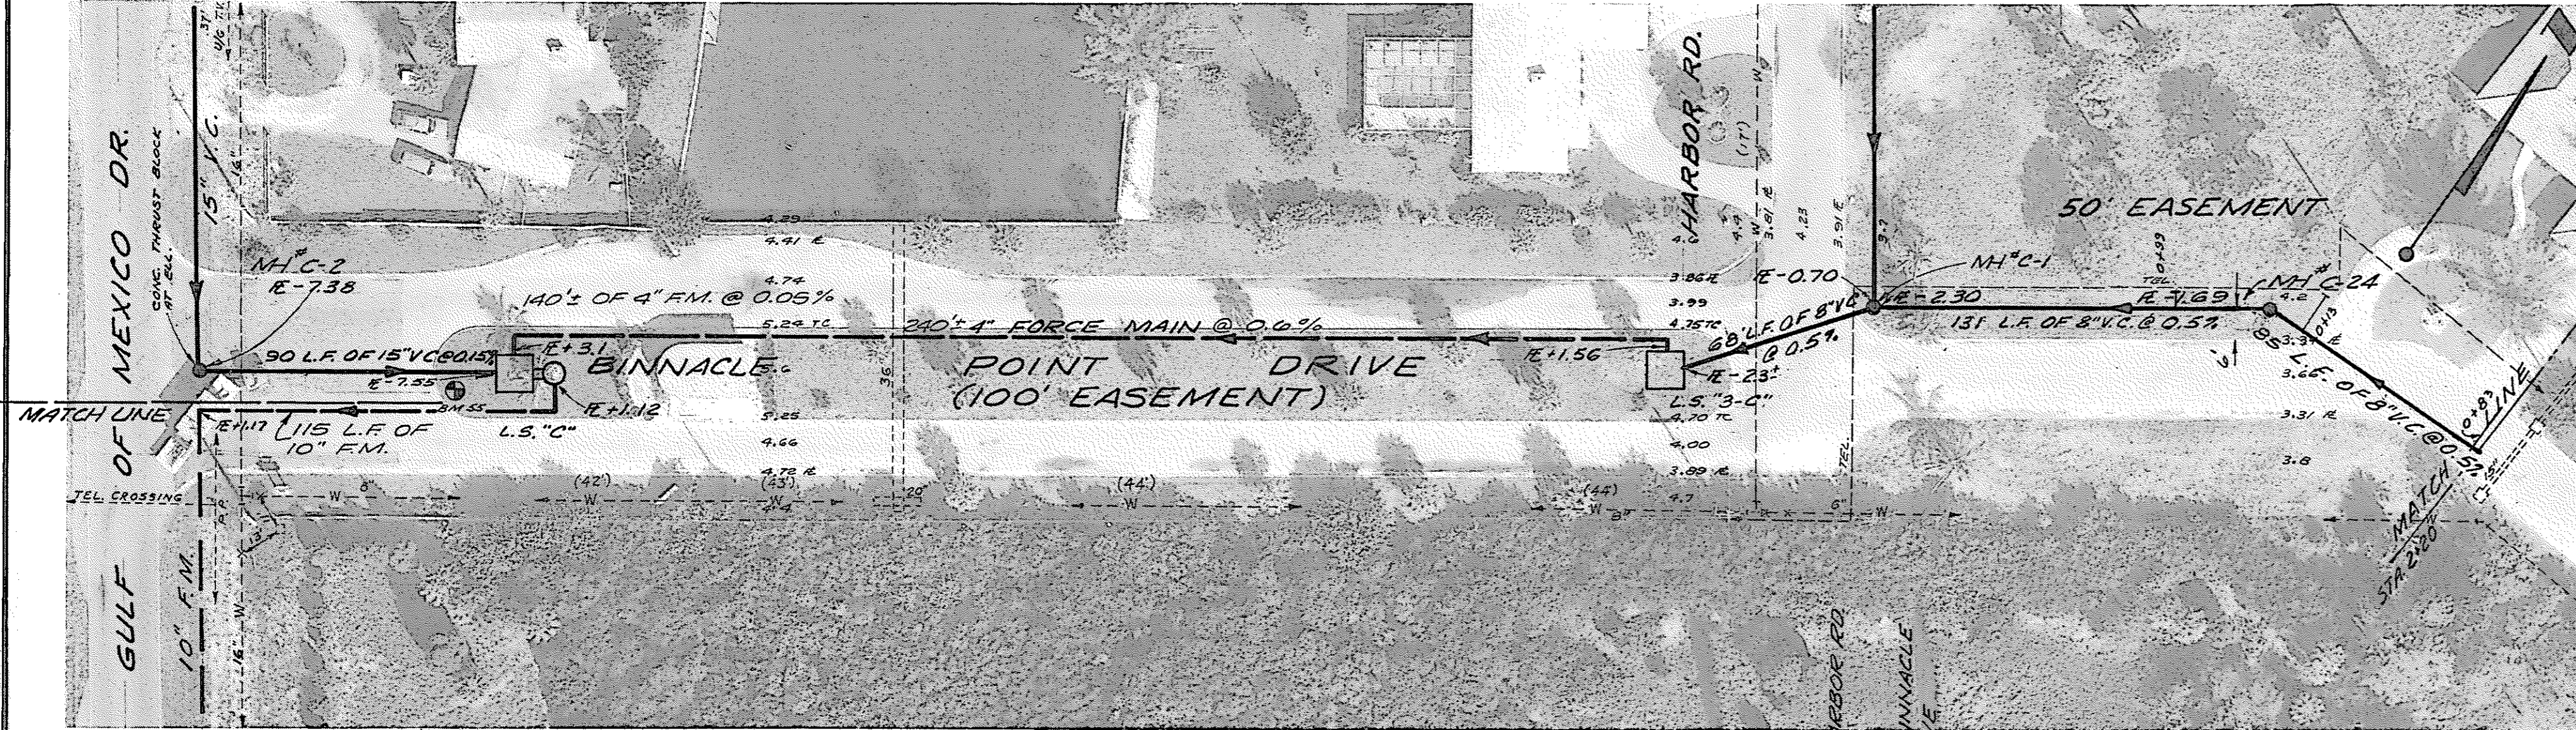
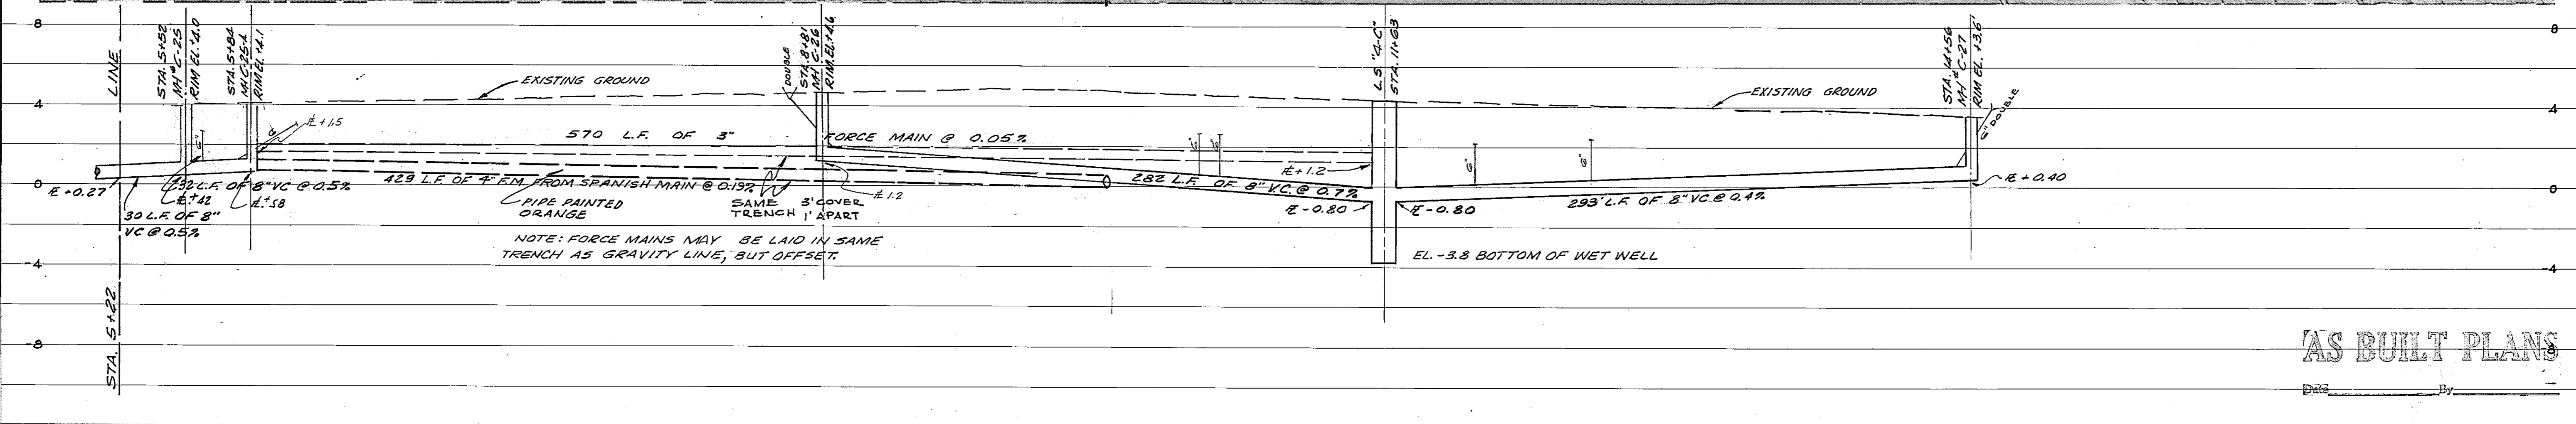


SEE SHEET 42

SEE SHEET 40

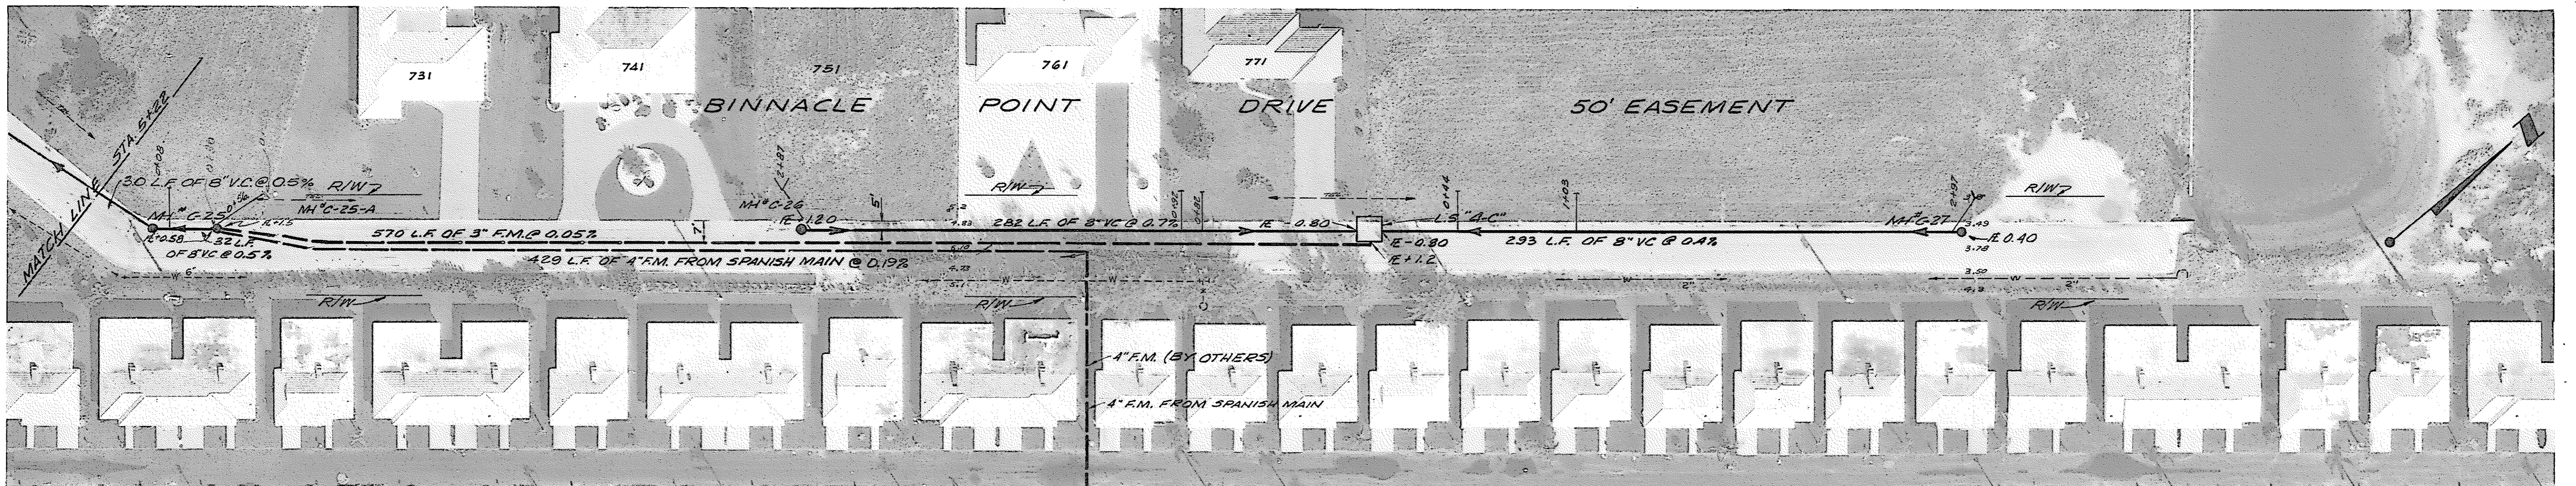

SEE SHEET 38

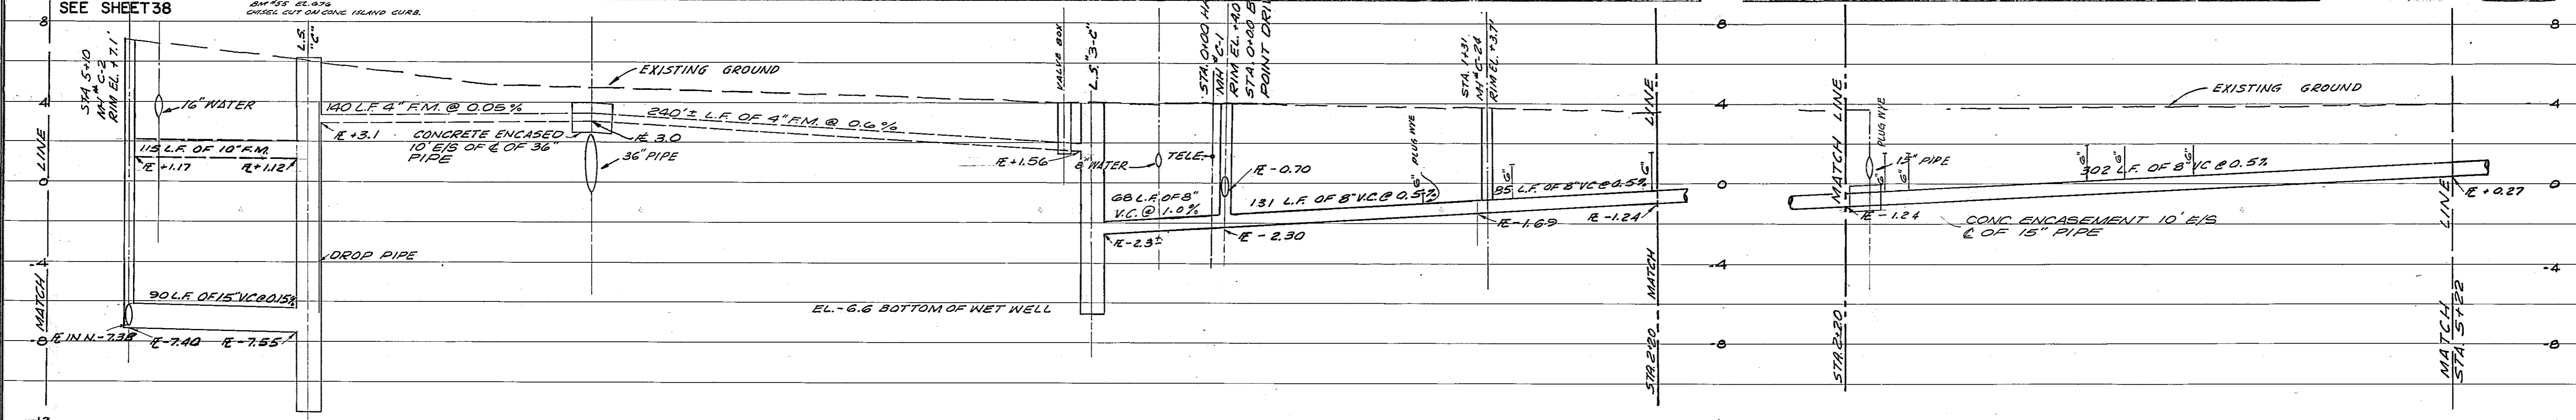

AS BUILT PLANS

DESIGNED BY J.D. LALAN	DATE 4-13-73	SCALE HORIZ. 1"=40' VERT. 1"=4'	BY L.D.L. ADD	REVISION 7/19/73 MOVED L.S.V.C. & ADDED VALVE BOX 10-28-74 REVISED GRAVITY LINES AND FORCE MAINS. 1-13-75 REVISED FORCE MAIN TO SPANISH MAIN. 8-14-75 RELOCATED MH, C-2, C-1, C-4, C-5, ADDED SERVICE 8-22-75 RELOCATED MH, C-2, C-1, C-4, C-5	APPROVED BY J. DAVID WEARE, P.E. FLORIDA, CERT. NO. 15670
CHECKED BY J.G. CUMMINS	PROJECT NO. 1217-S	DRAWN BY P.C. MC...	DATE 4-13-73	TOWN OF LONGBOAT KEY, FLORIDA	
				BINNACLE POINT DRIVE	
				WASTEWATER COLLECTION SYSTEM	
				SMALLY, WELLFORD & NALVEN—CONSULTING ENGINEERS—SARASOTA, FLORIDA	
				SHEET NUMBER 39	INDEX NO. E-1217-244
				REVISION E	