
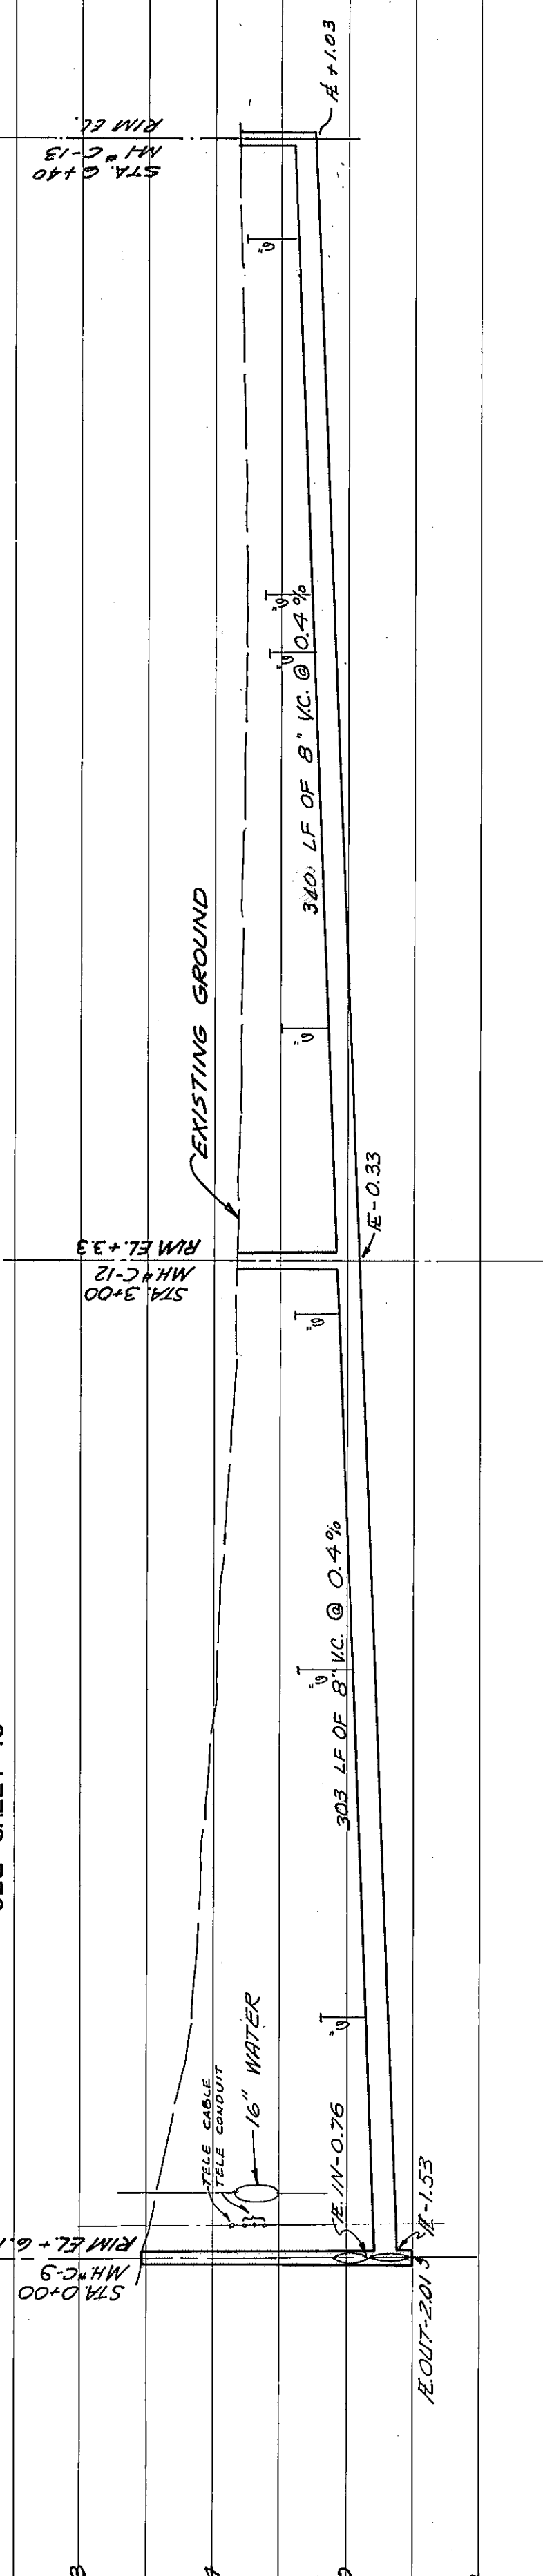
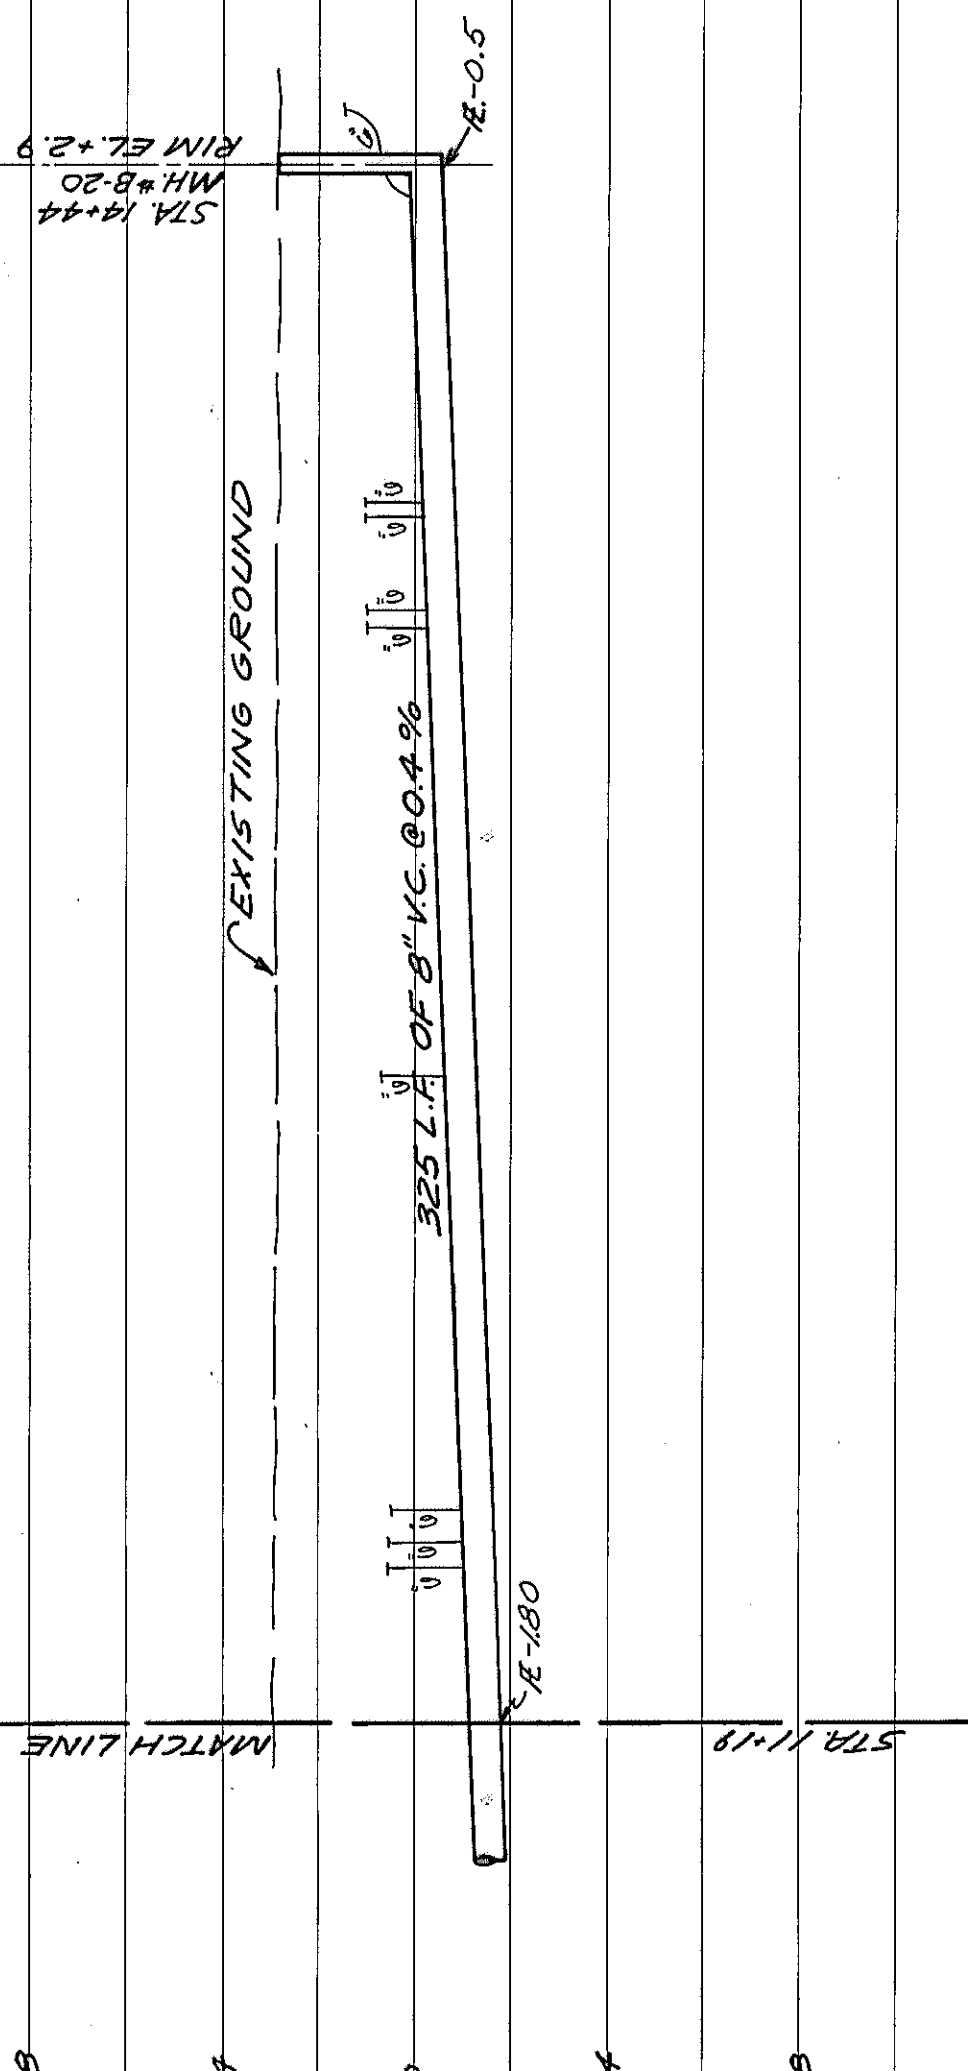


FOR: TOWN OF LONGBOAT KEY, FLORIDA	LTR. DATE: 1-24-75	BY: A.S. BUILT	REVISION
DESIGNED BY: JDM/CKM	SCALE: HORIZ. 1"=40'	DATE: 4-13-73	
APPROVED BY: J. DAVID WEAVER, P.E.	CHECKED BY: UG/MKH	DRAWN BY: UG/MKH	
PROJECT NO. 1217-S			

AS BUILT PLANS

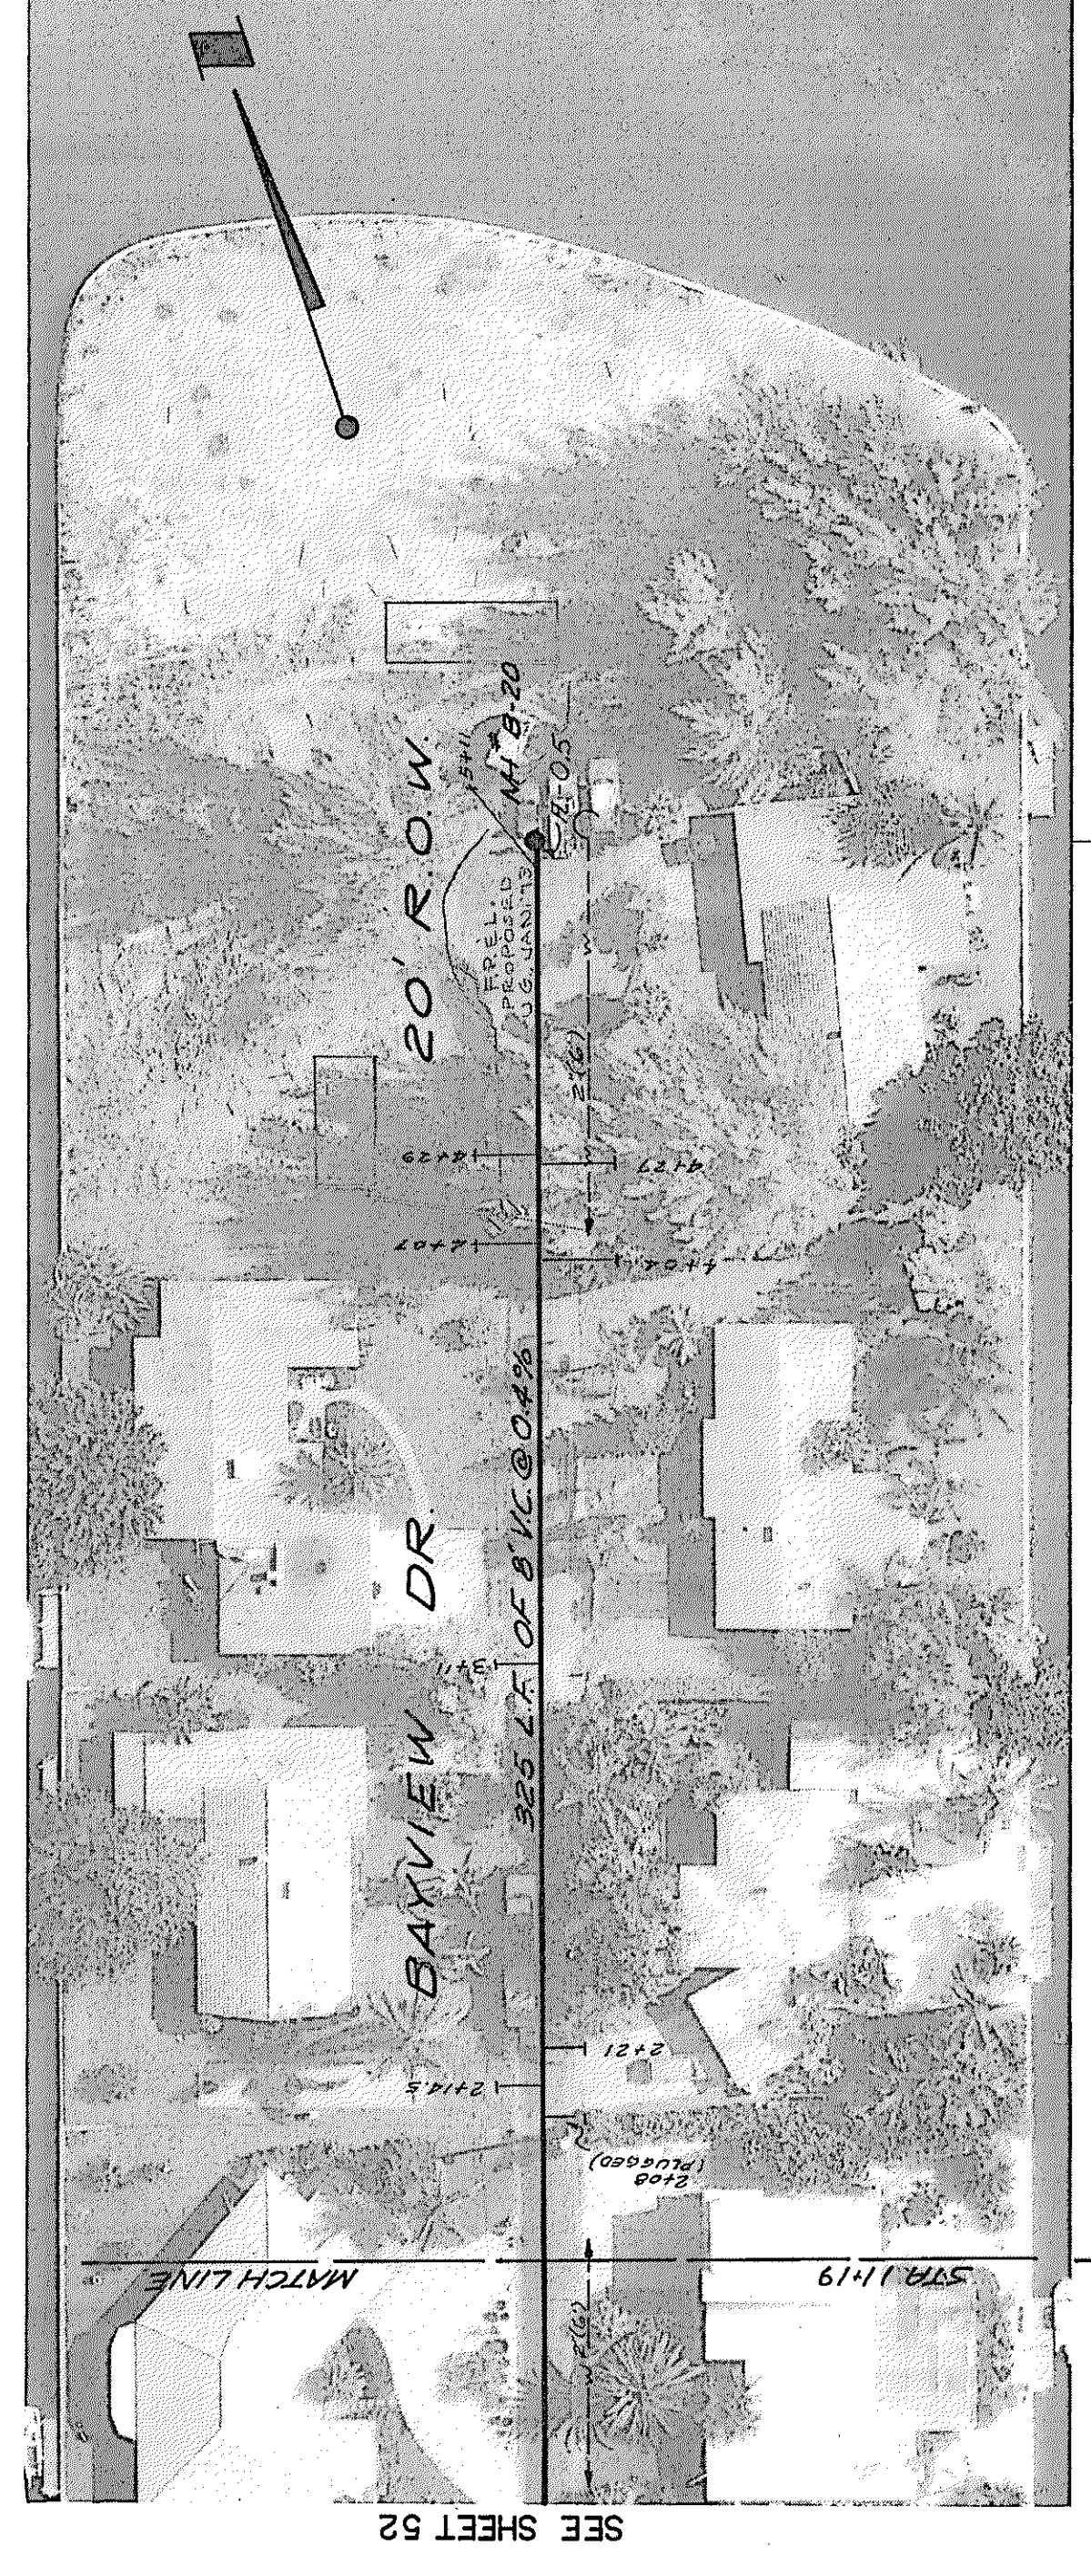

SEE SHEET 52

SEE SHEET 47

SEE SHEET 45

RECUT-20' X-1.53

16" WATER

FILE GRADE

FILE GRADE

STA 0+00

MH#9

RIM EL. +6.1

STA 3+00

MH#12

RIM EL. +3.3

STA 1+15

MH#15

RIM EL.

STA 14+44

MH#20

RIM EL. +2.9

BM B-10, E.L. 5.40

CHISEL CUT ON 55MM