



SEE SHEET 50

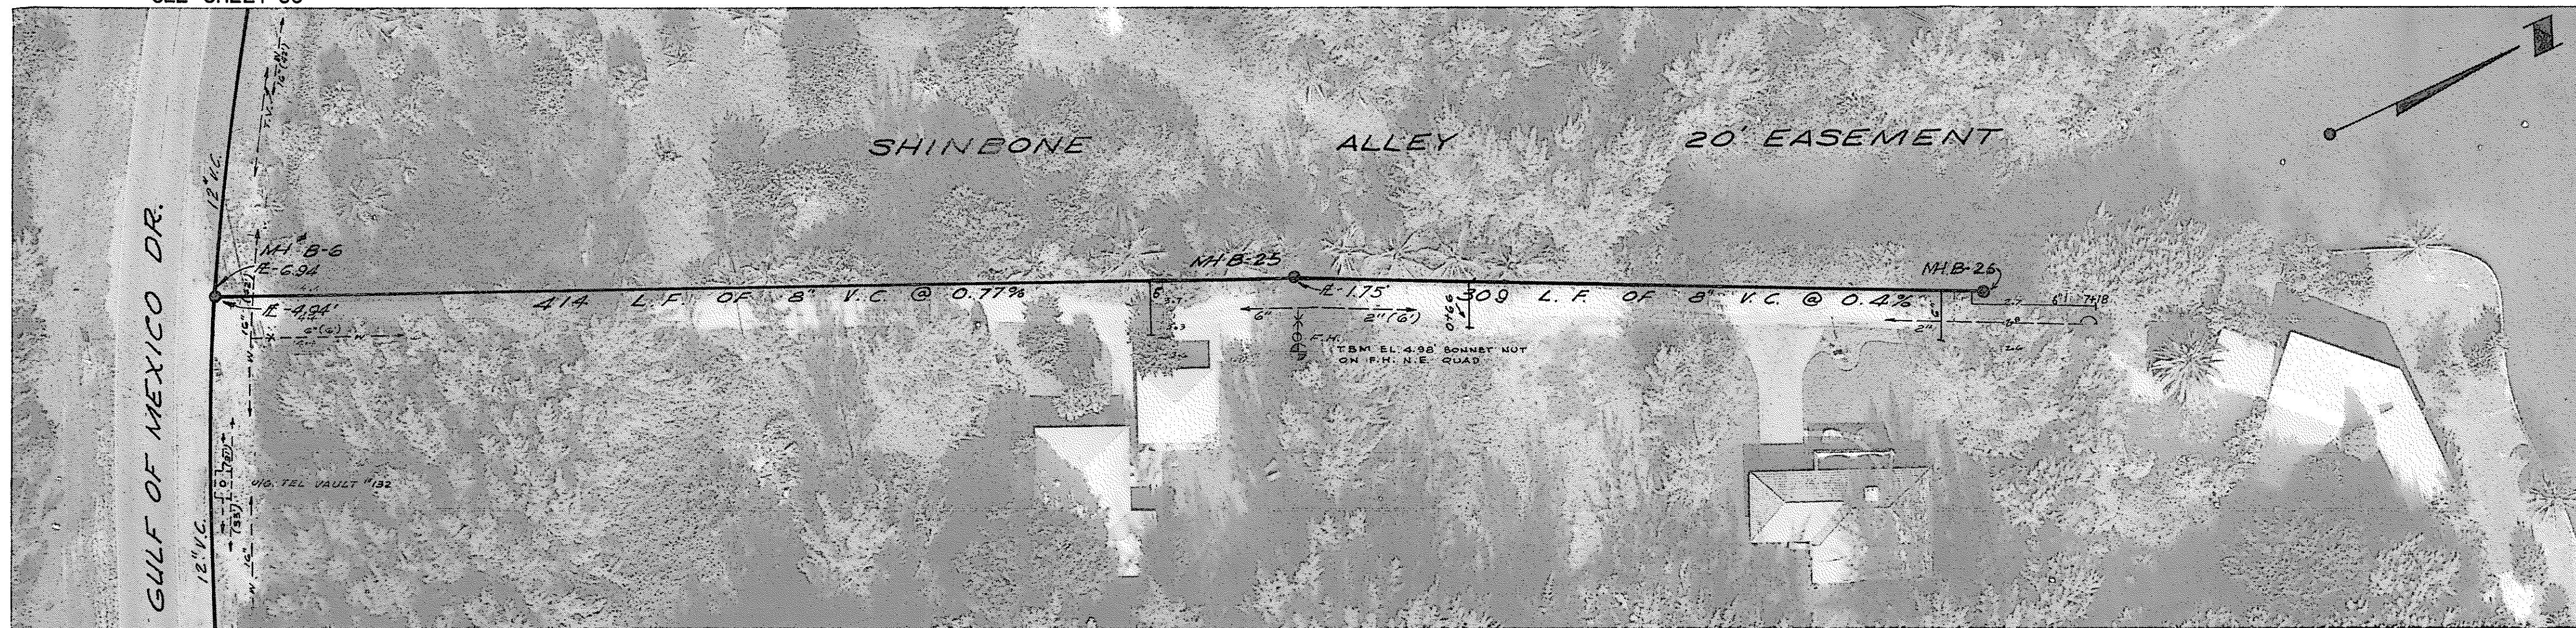


SEE SHEET 50

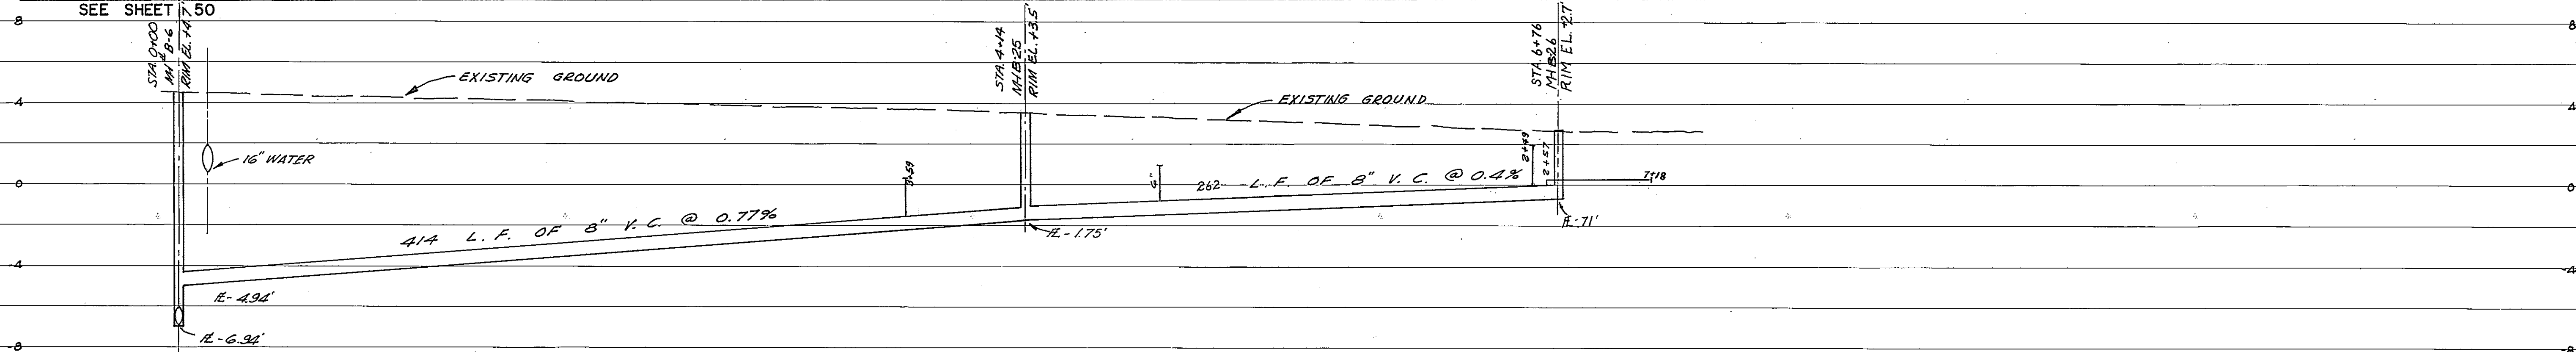

SEE SHEET 48



SEE SHEET 48

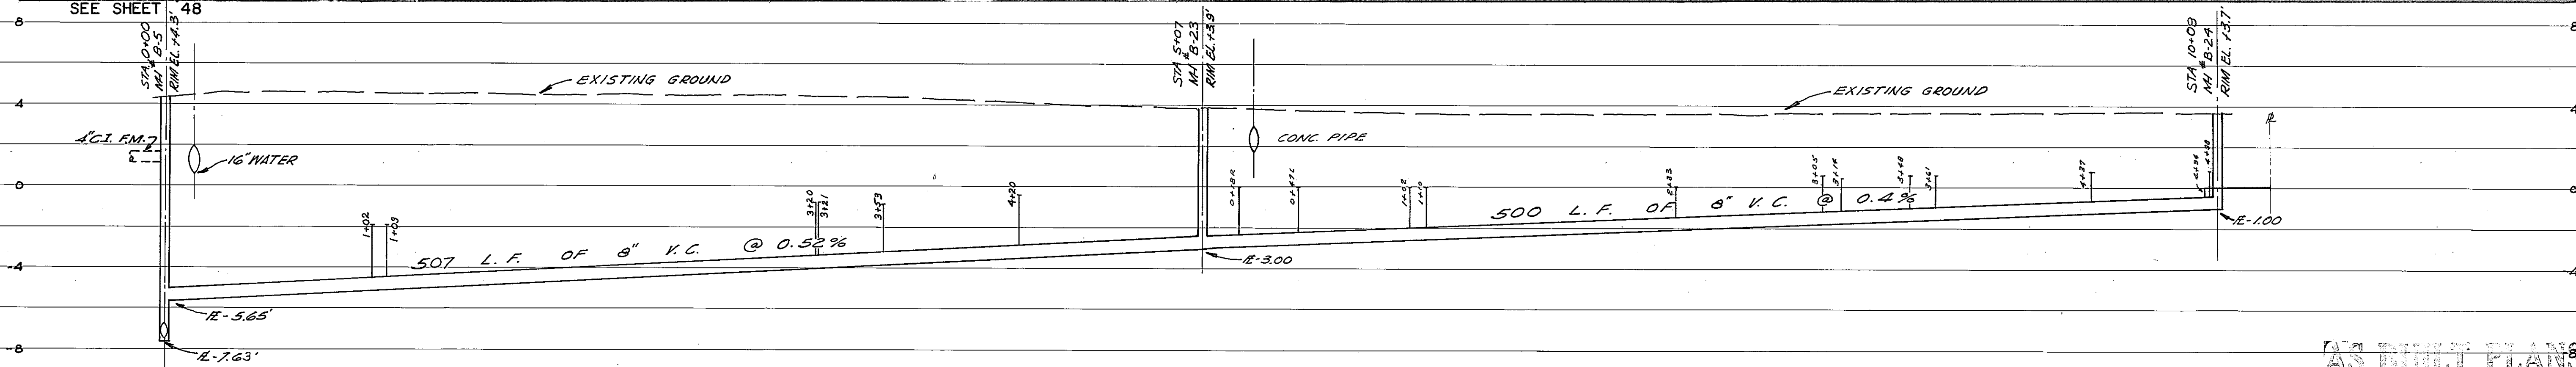

AS BUILT PLANS

FOR:	TOWN OF LONGBOAT KEY, FLORIDA	DATE:	4-19-73	DESIGNED BY:	J.C. WILSON	APPROVED BY:	J. DAVID WEARE, P.E.
	JUAN ANASCO DR., SHINEBONE ALLEY	SCALE:	HORIZ. 1" = 40'	DRAWN BY:	J.C. WILSON		
	WASTEWATER COLLECTION SYSTEM	VERT.:	1" = 4'	CHECKED BY:	J.C. WILSON		
	SMALLY, WELLFORD & NALVEN—CONSULTING ENGINEERS—SARASOTA, FLORIDA	PROJECT NO.:	1217-S				
SHEET NUMBER:	51						
REVISION:	A						

INDEX NO. E-1217-255