


SEE SHEET 48




SEE SHEET 48

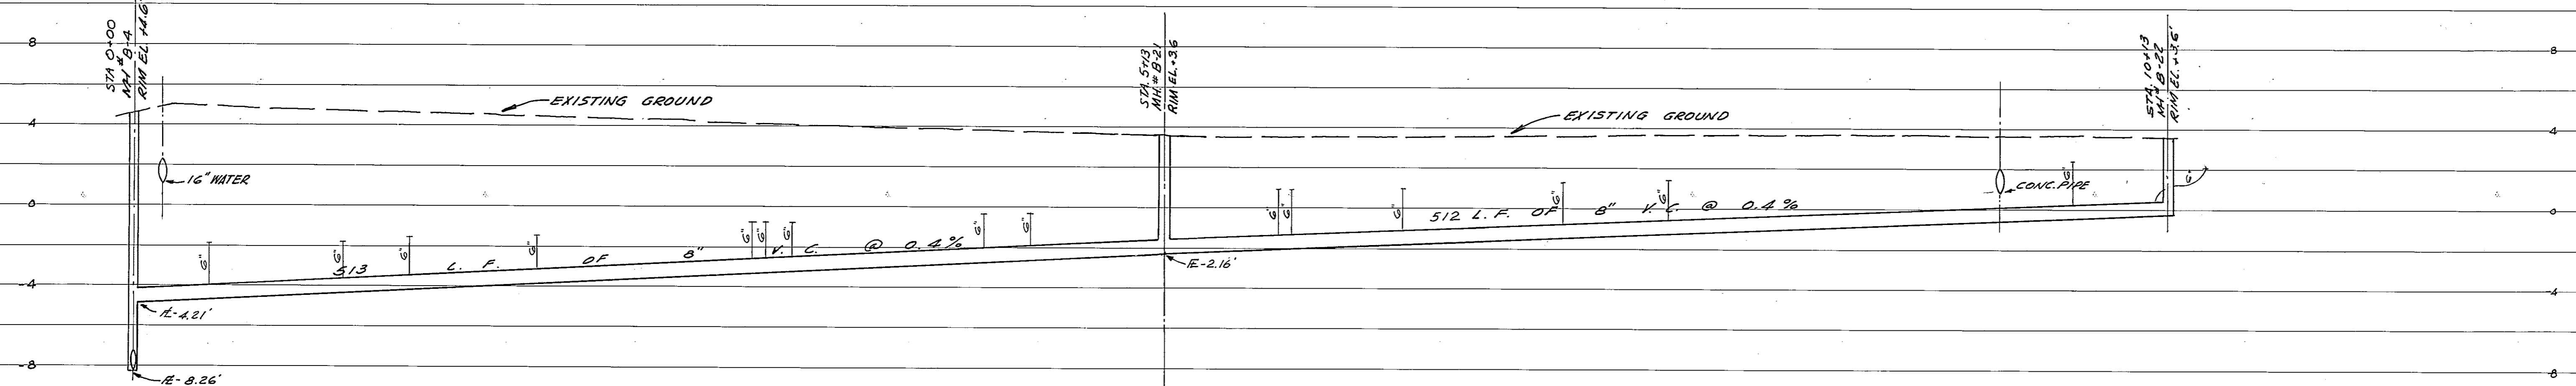

SEE SHEET 48



SEE SHEET 48

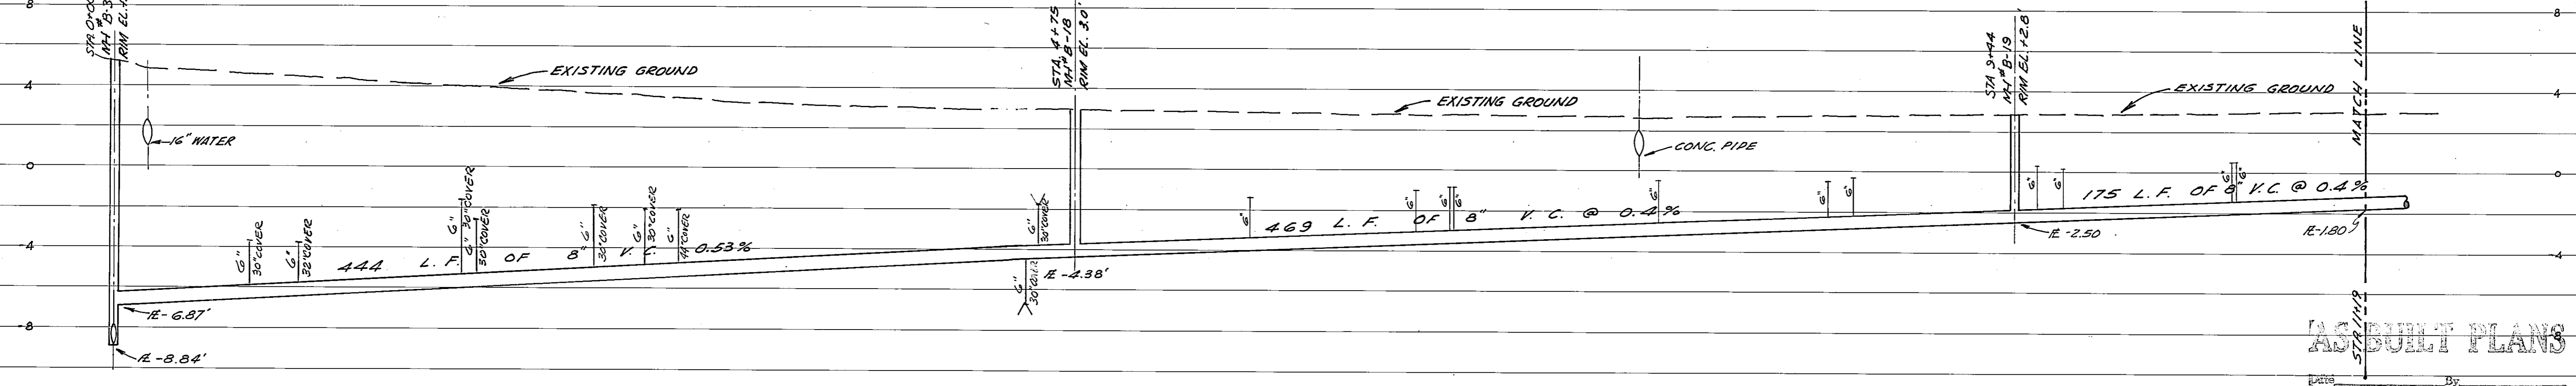

AS BUILT PLANS

DESIGNED BY J.M. ENN L.D.L.	DATE 4-13-73	APPROVED BY T. DAVID WHEASE FLORIDA STATE REG. NO. 1217-S
SCALE: HORIZ. 1"=40' VERT. 1"=4'	DRAWN BY P.C.W.	CHECKED BY J.S. ENN E.C.
BY P.C.W.	REVISION AS BUILT, MH B-4 TO B-22 (FOR NARVAEZ DR) / MH B-18 FROM MH B-19	DATE 8/1/75
FOR: TOWN OF LONGBOAT KEY, FLORIDA DE NARVAEZ DRIVE, BAYVIEW DR. WASTEWATER COLLECTION SYSTEM		L.T.R. A
SMALLY, WELLFORD & NALVEN—CONSULTING ENGINEERS—SARASOTA, FLORIDA		INDEX NO. E-1217-256
SHEET NUMBER 52		REVISION A