

SMALLY, WELLFORD & NALVEN—CONSULTING ENGINEERS—SARASOTA, FLORIDA

WASTEWATER COLLECTION SYSTEM

FIREHOUSE CT, SEABREEZE AVE.

FOR: TOWN OF LONGBOAT KEY, FLORIDA

DATE: 12-76

AS BUILT

BY: R.C.M.

SCALE: HORIZ. 1"=40'

VERT. 1"=40'

DATE: 4-13-73

CHECKED BY: L.G. MMW

PROJECT NO. 1217-S

DESIGNED BY: J.D.W., E.M.M.



APPROVED BY: L.D.L.

PHOTO: BOSKORTH AERIAL SURVEYS

SEPT. 1972

REVISION

A

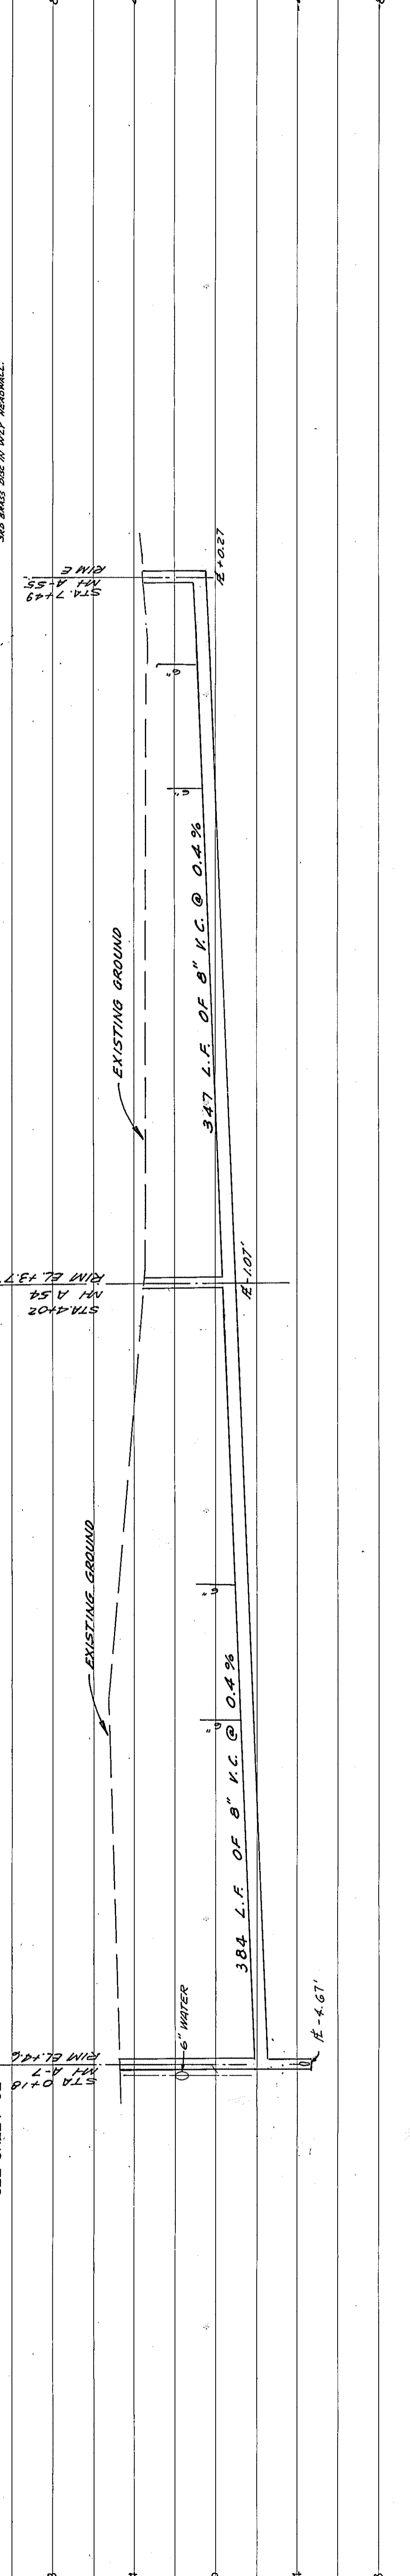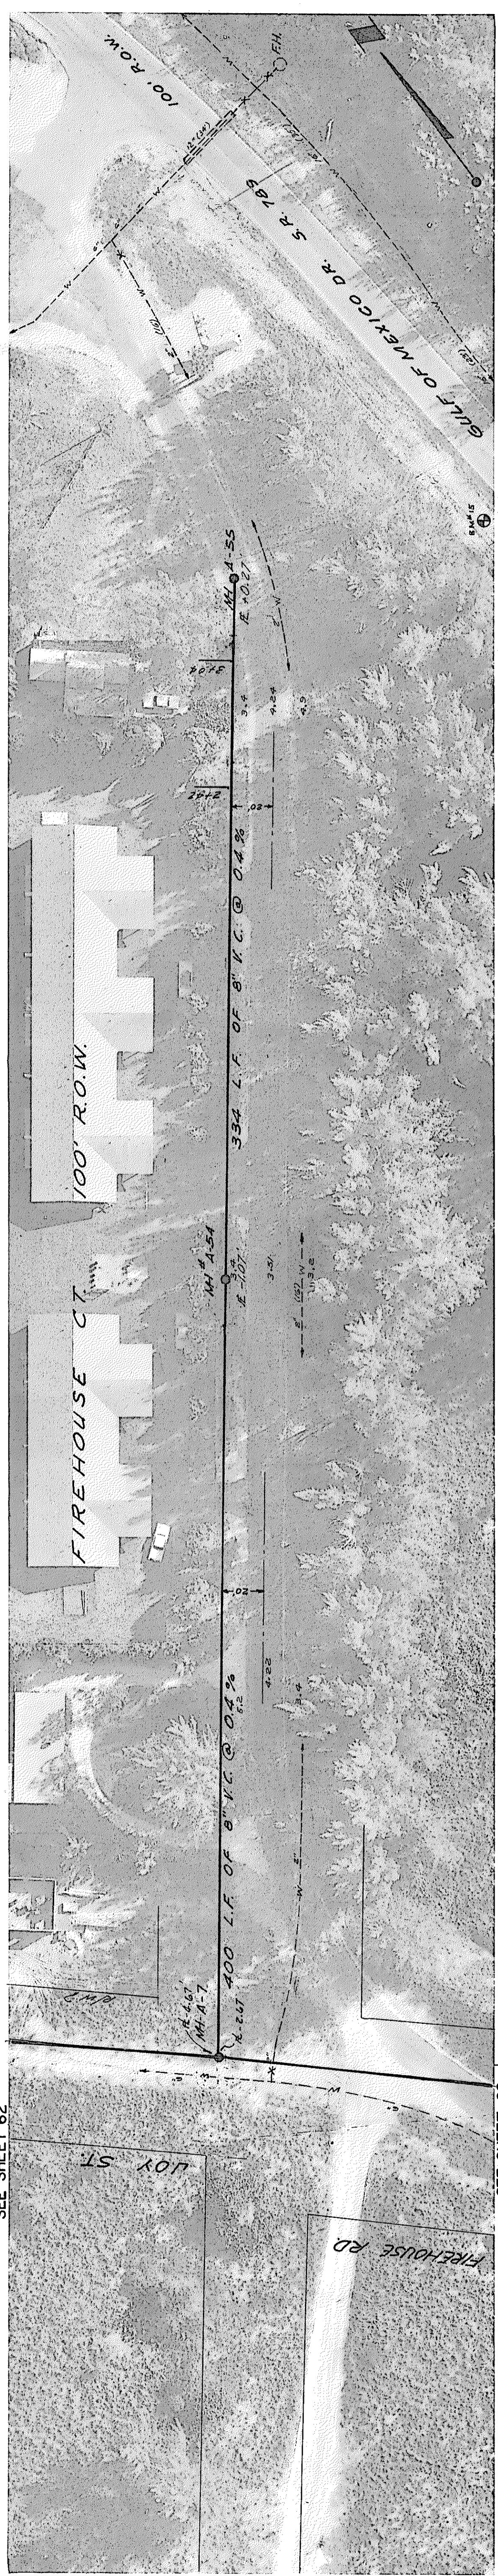

SEE SHEET 62

SEE SHEET 62