
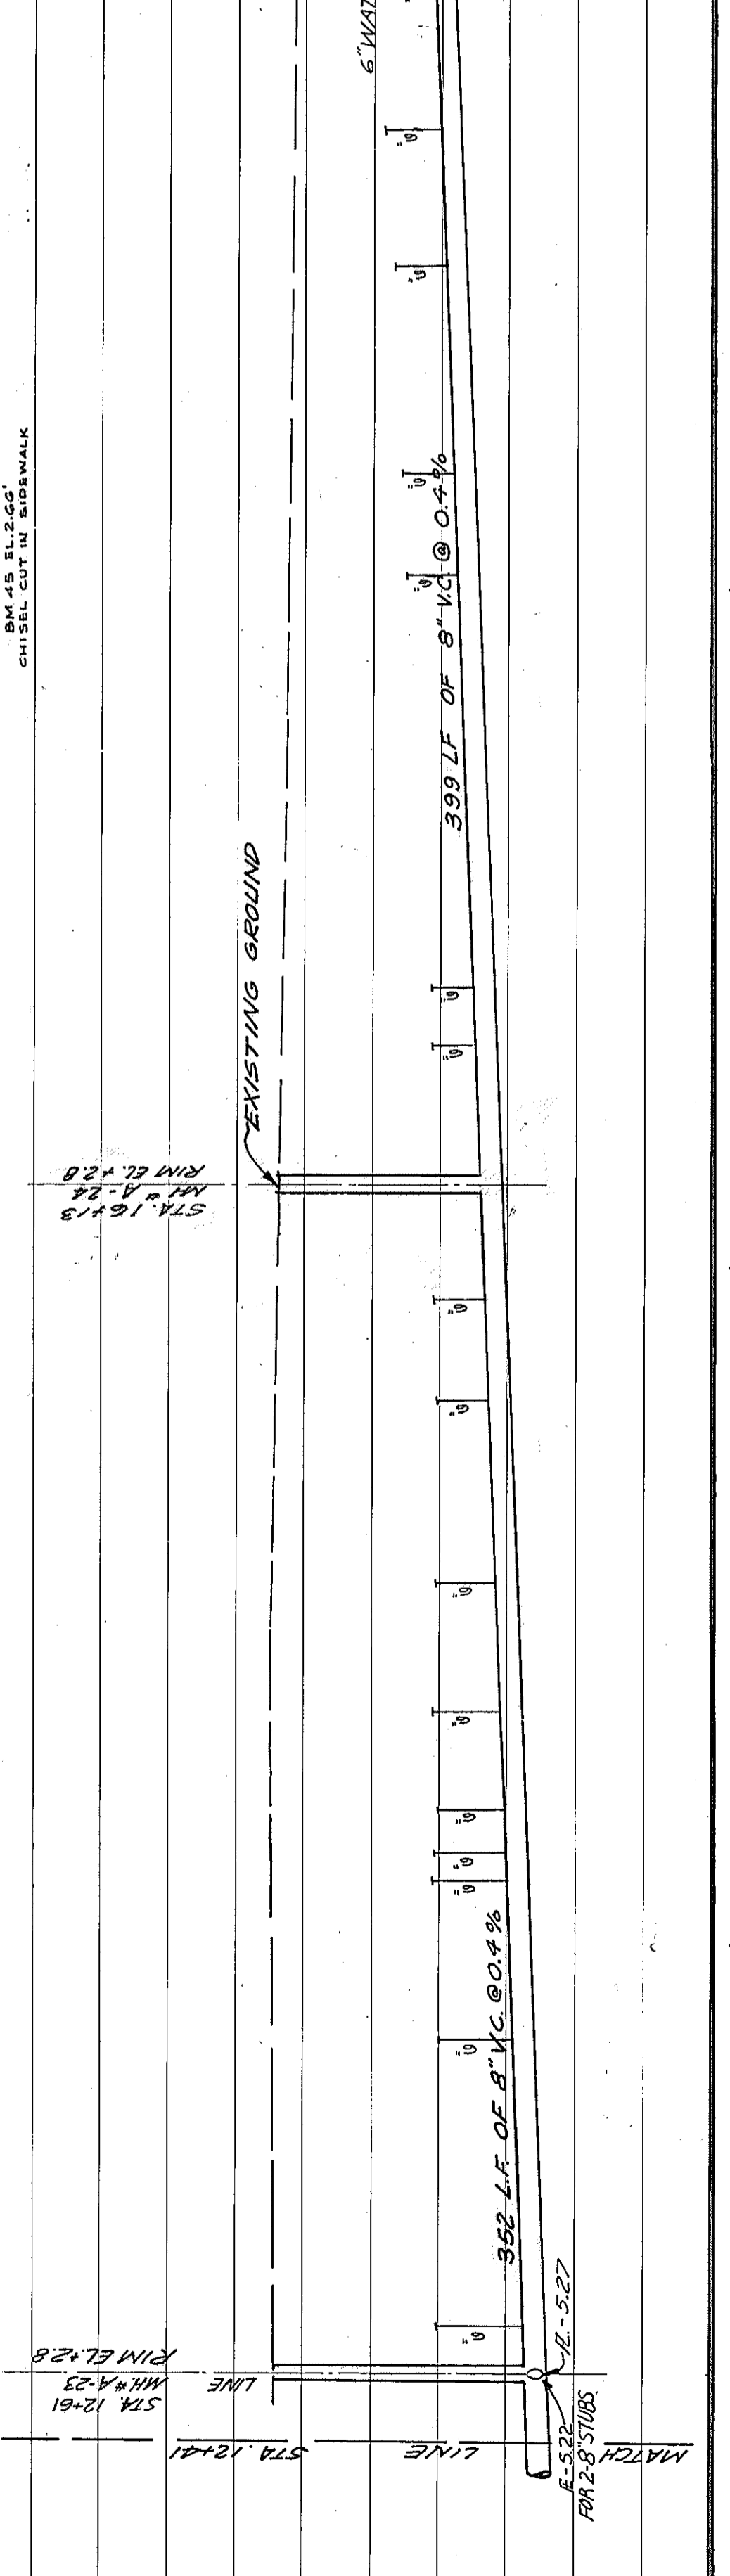
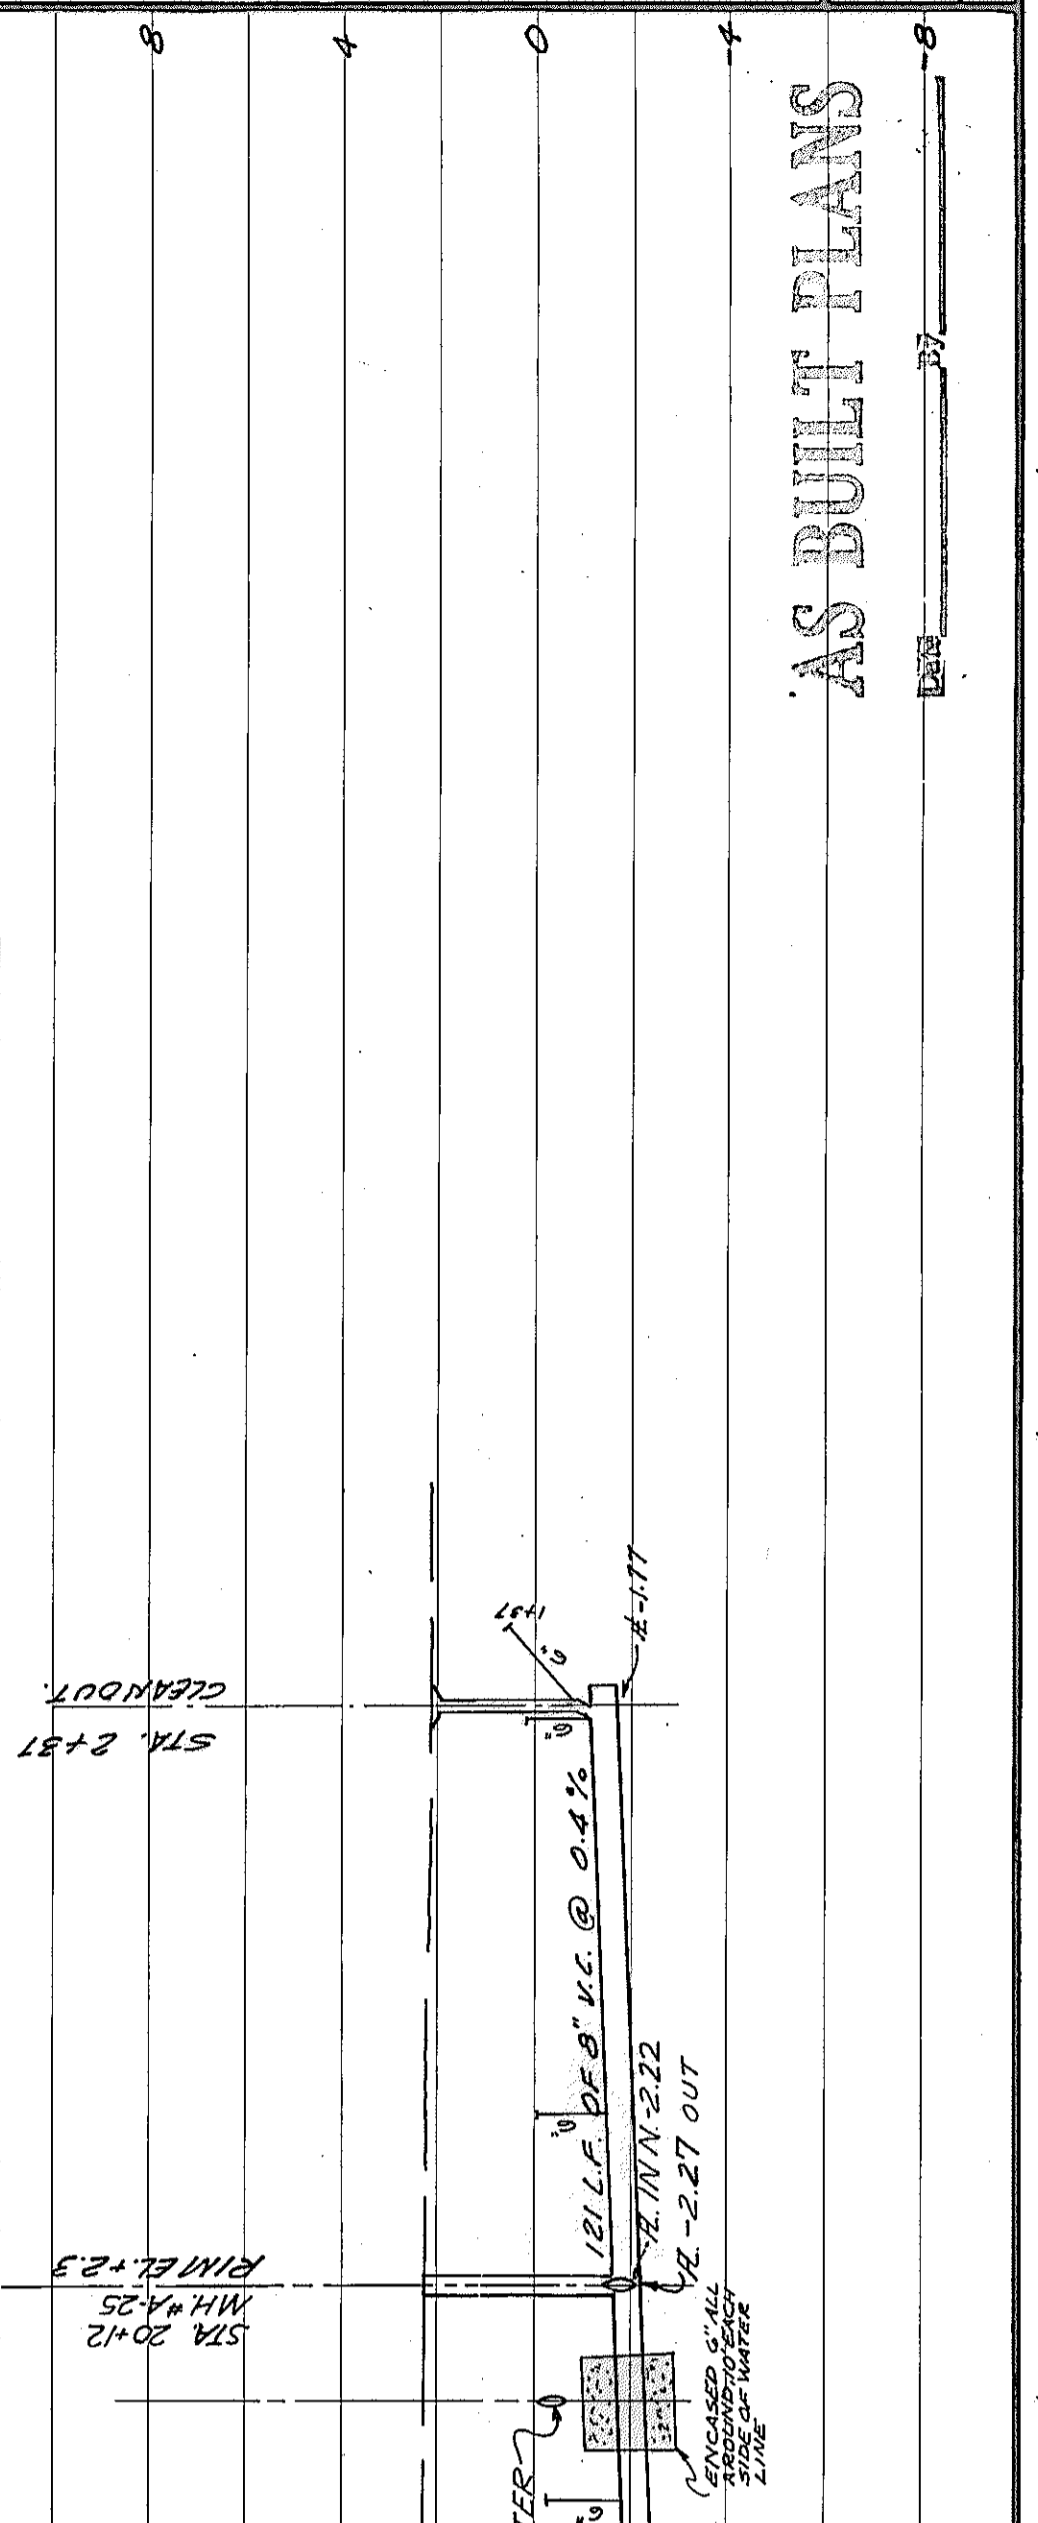
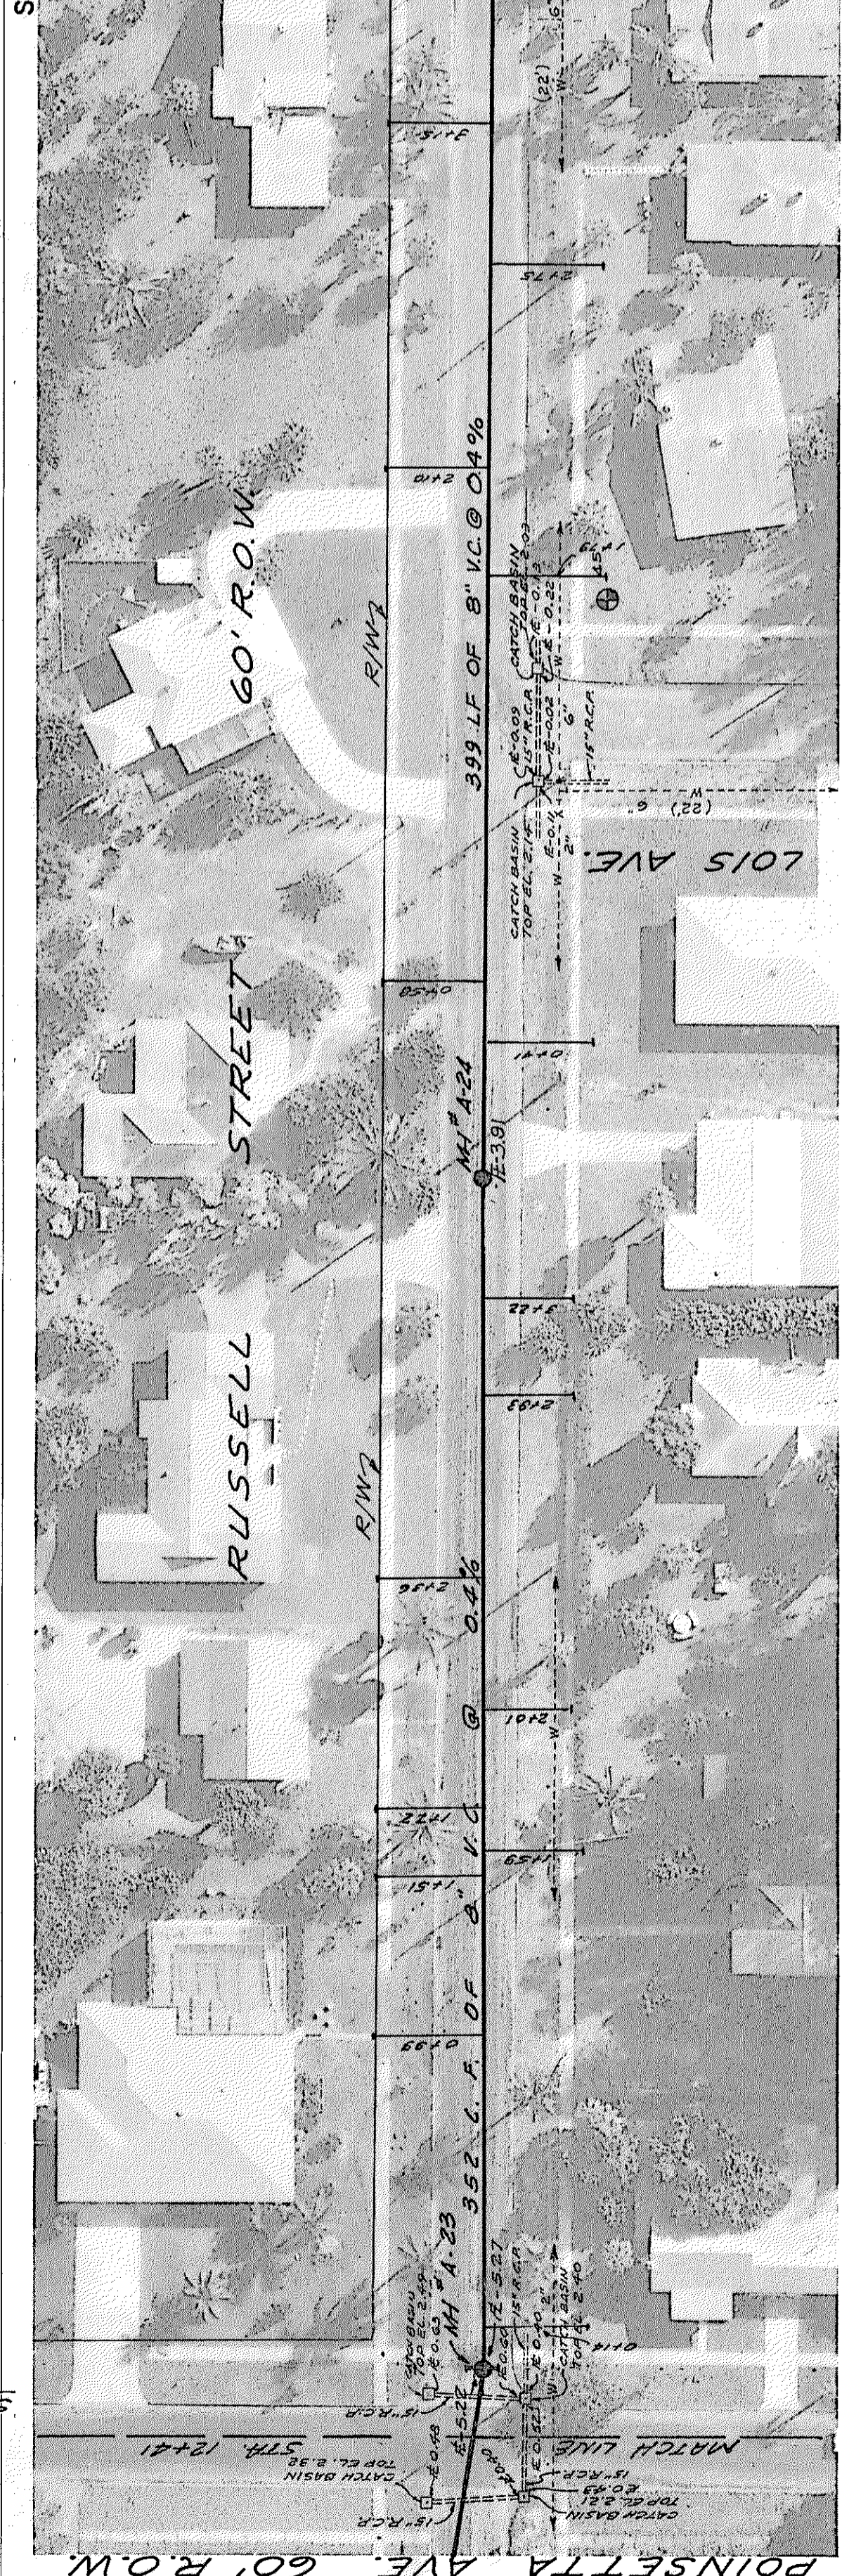
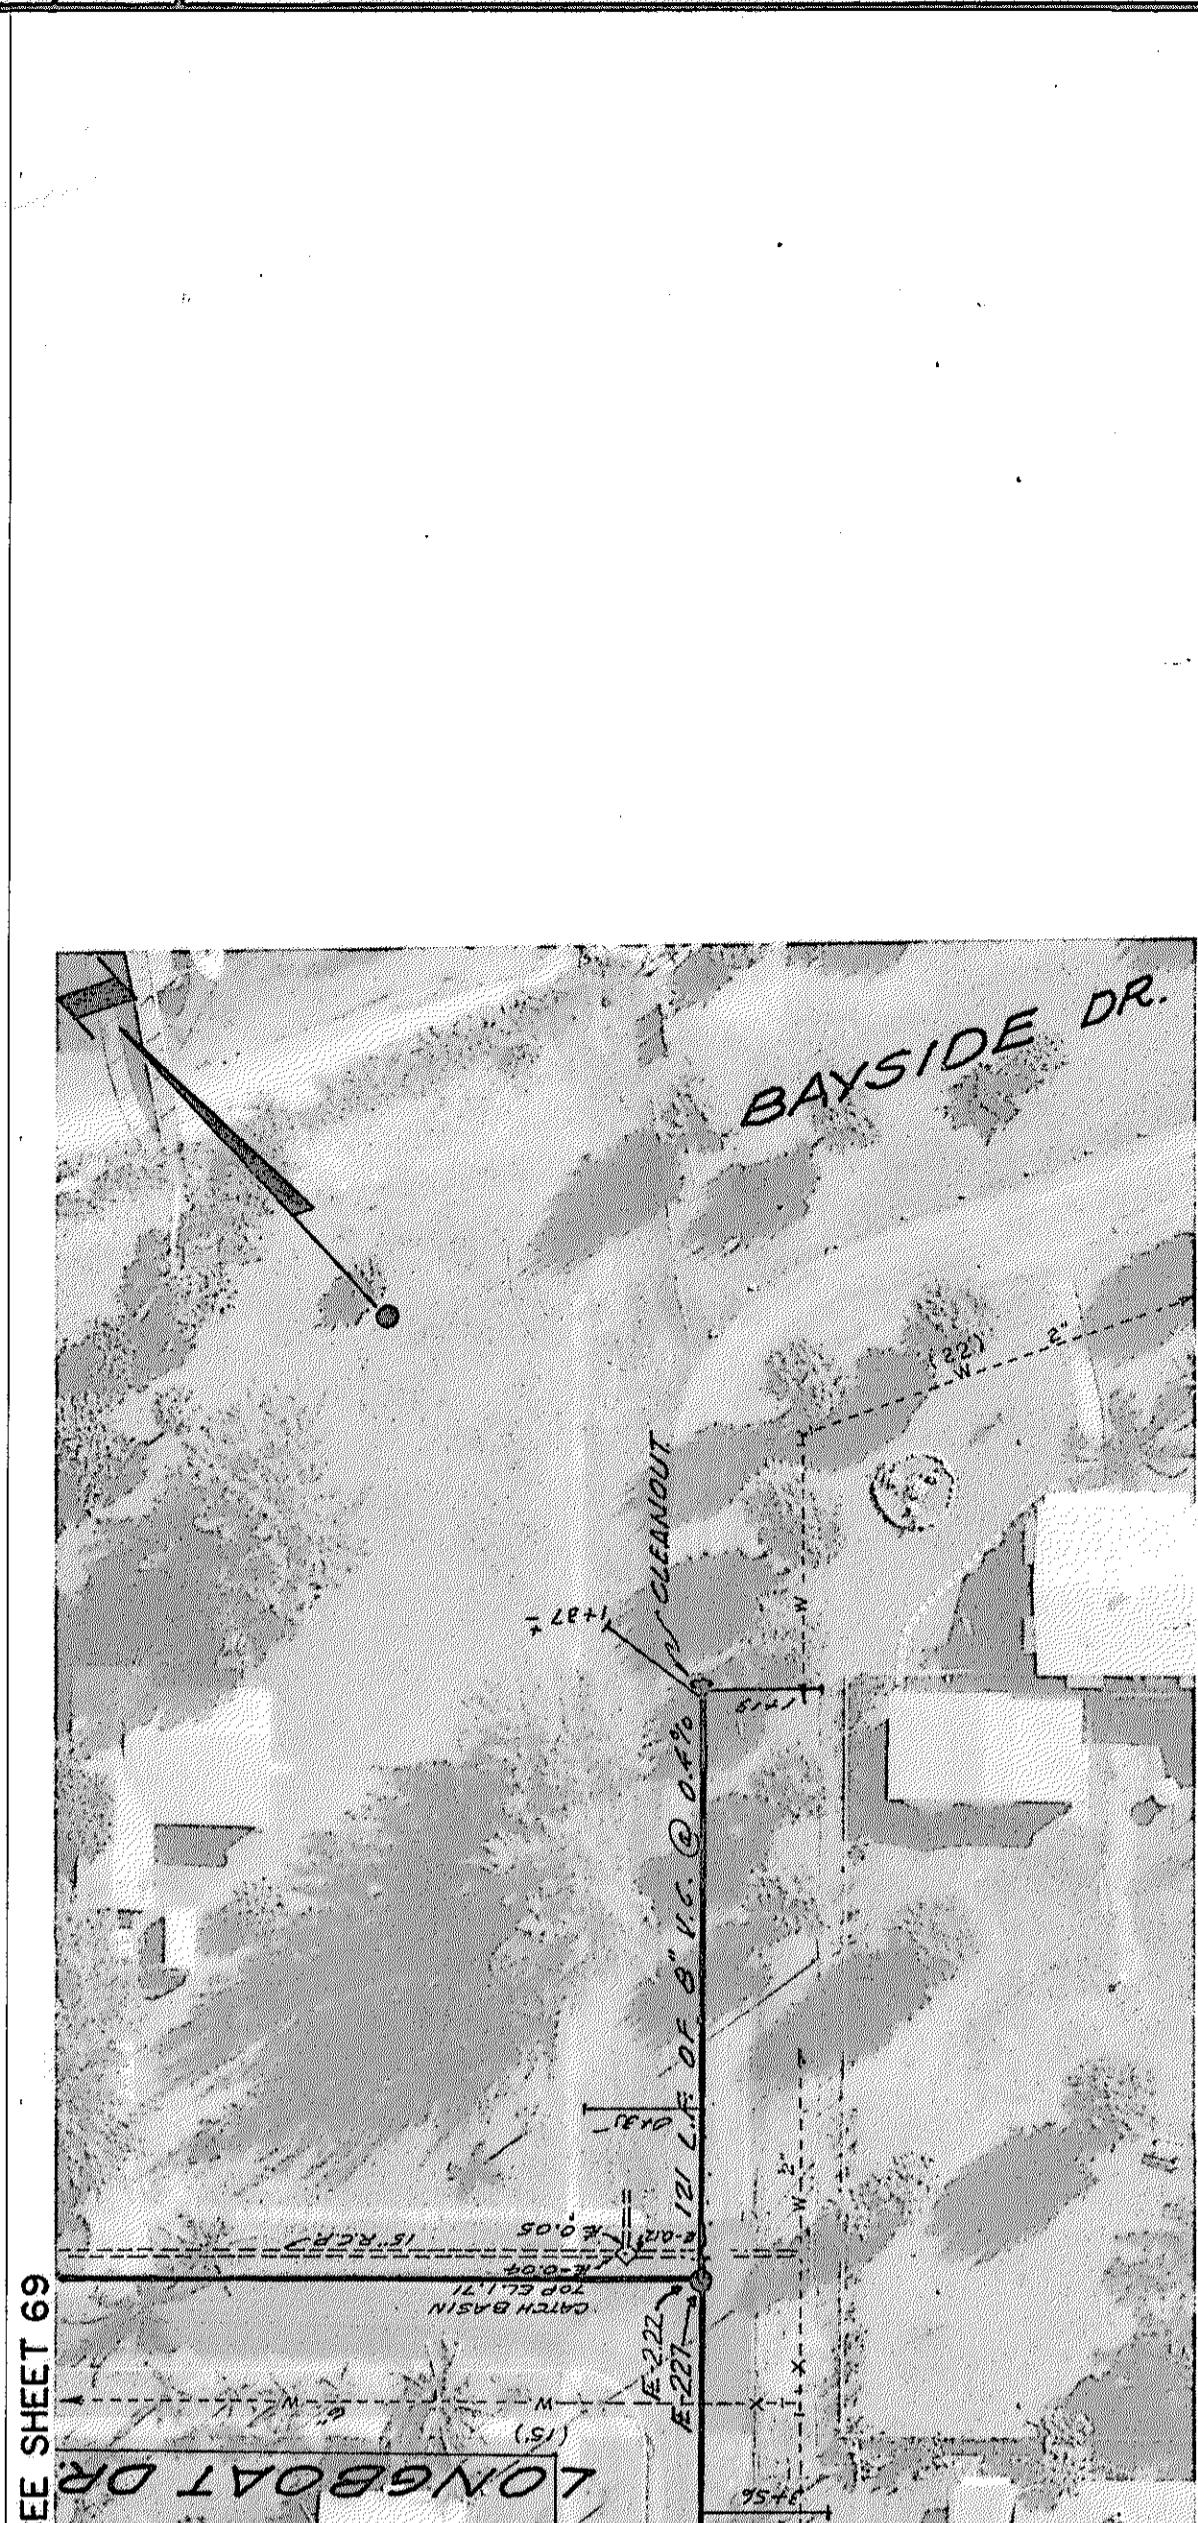
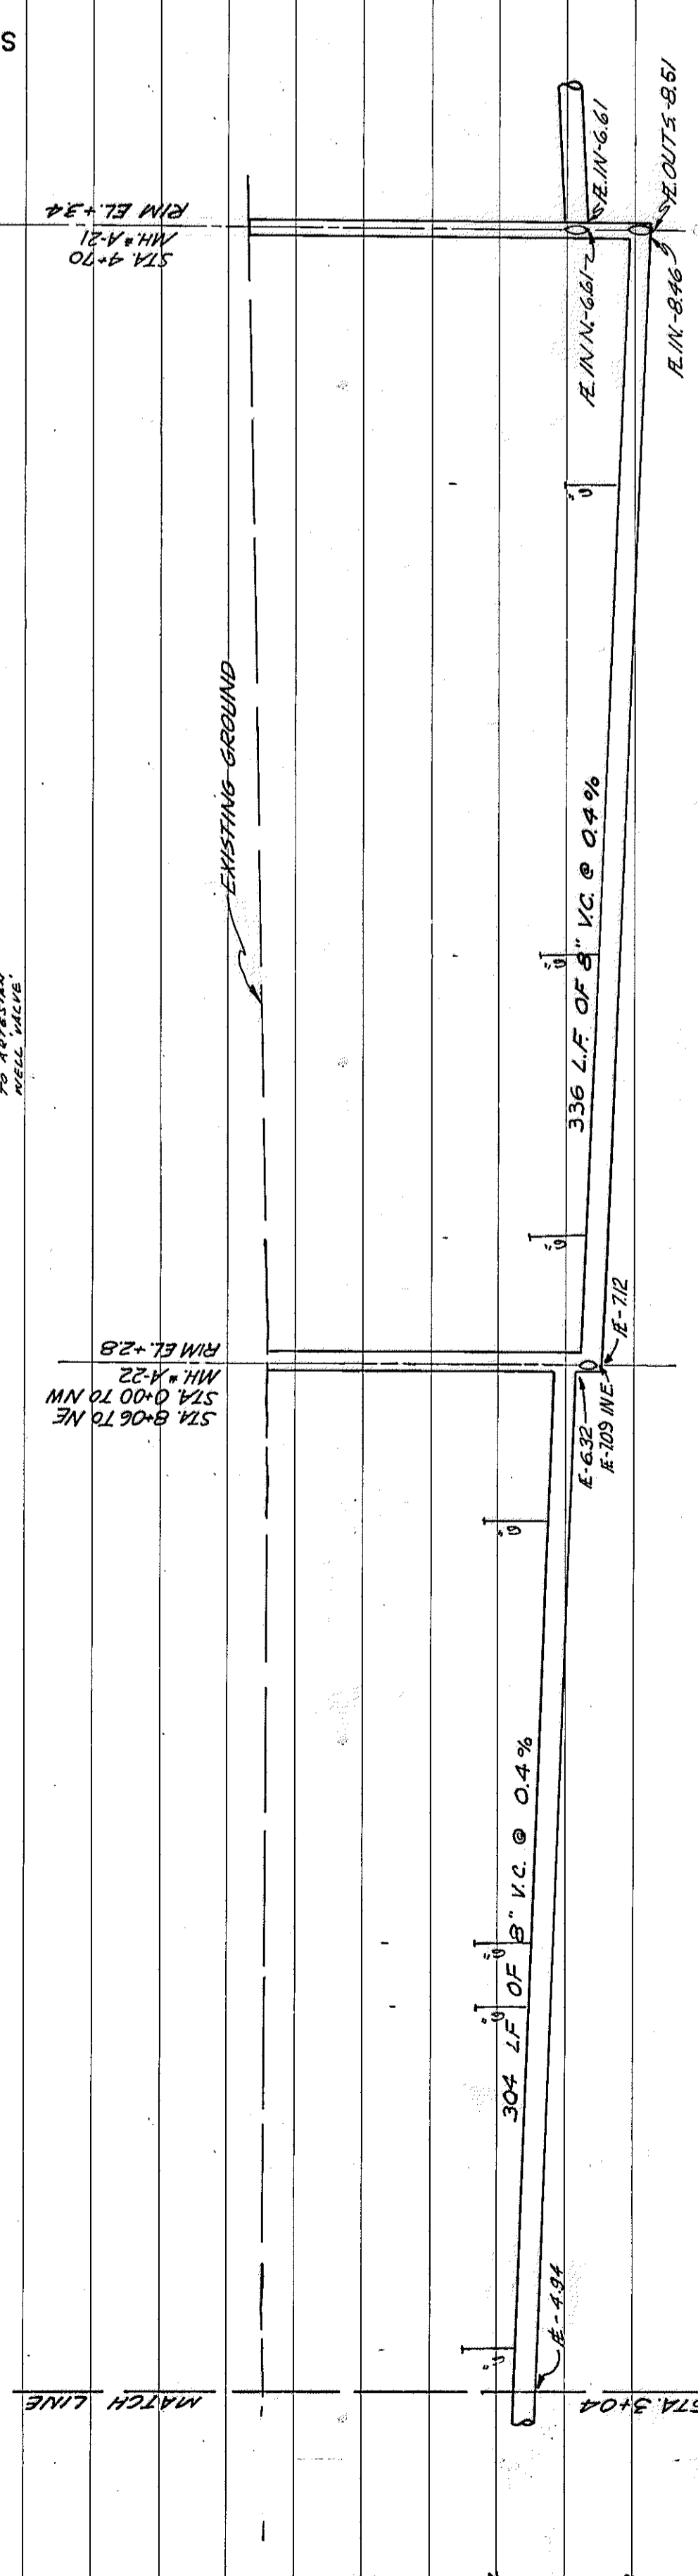
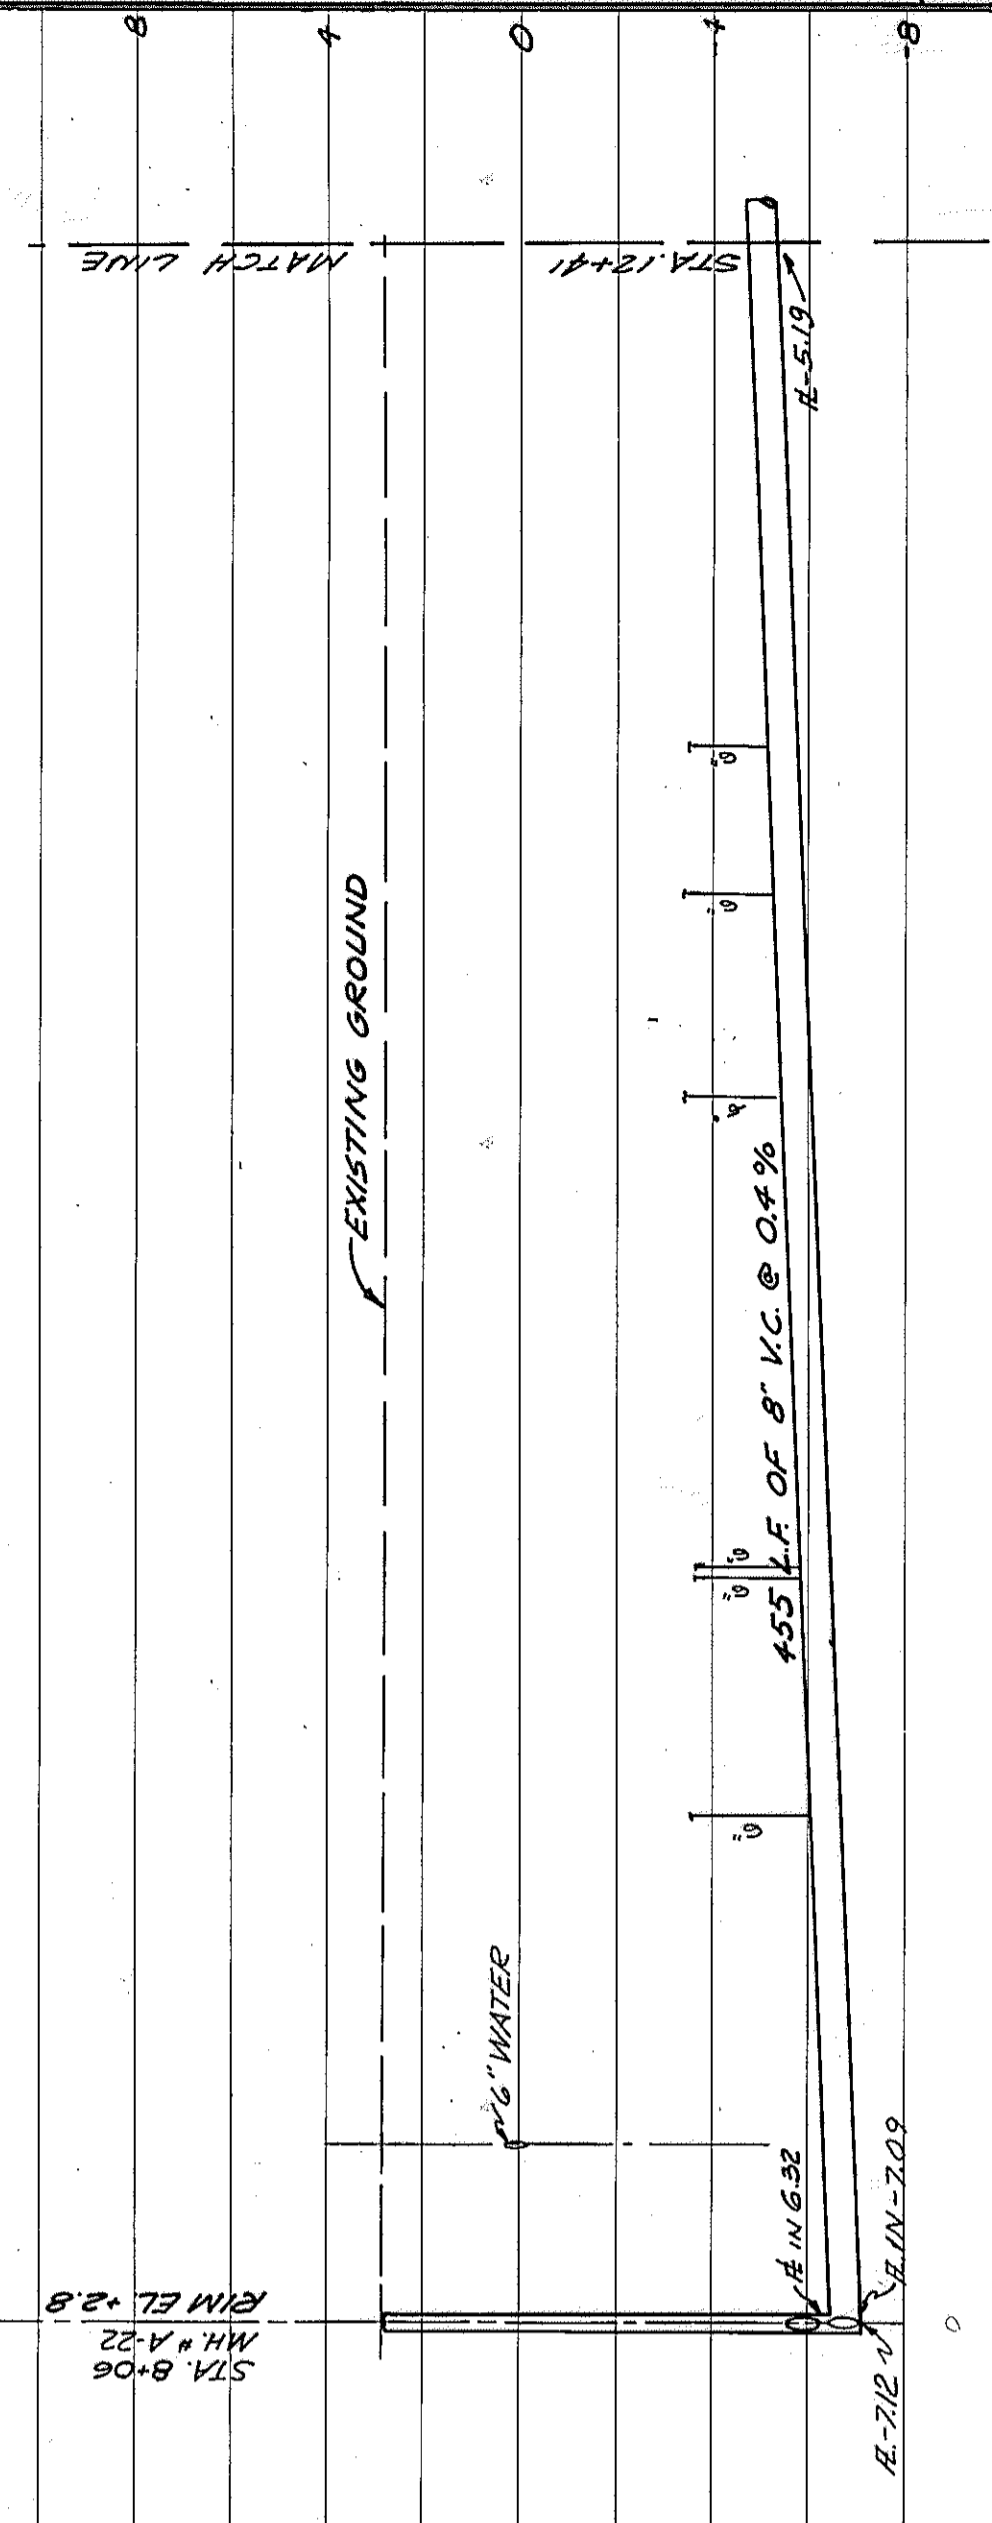
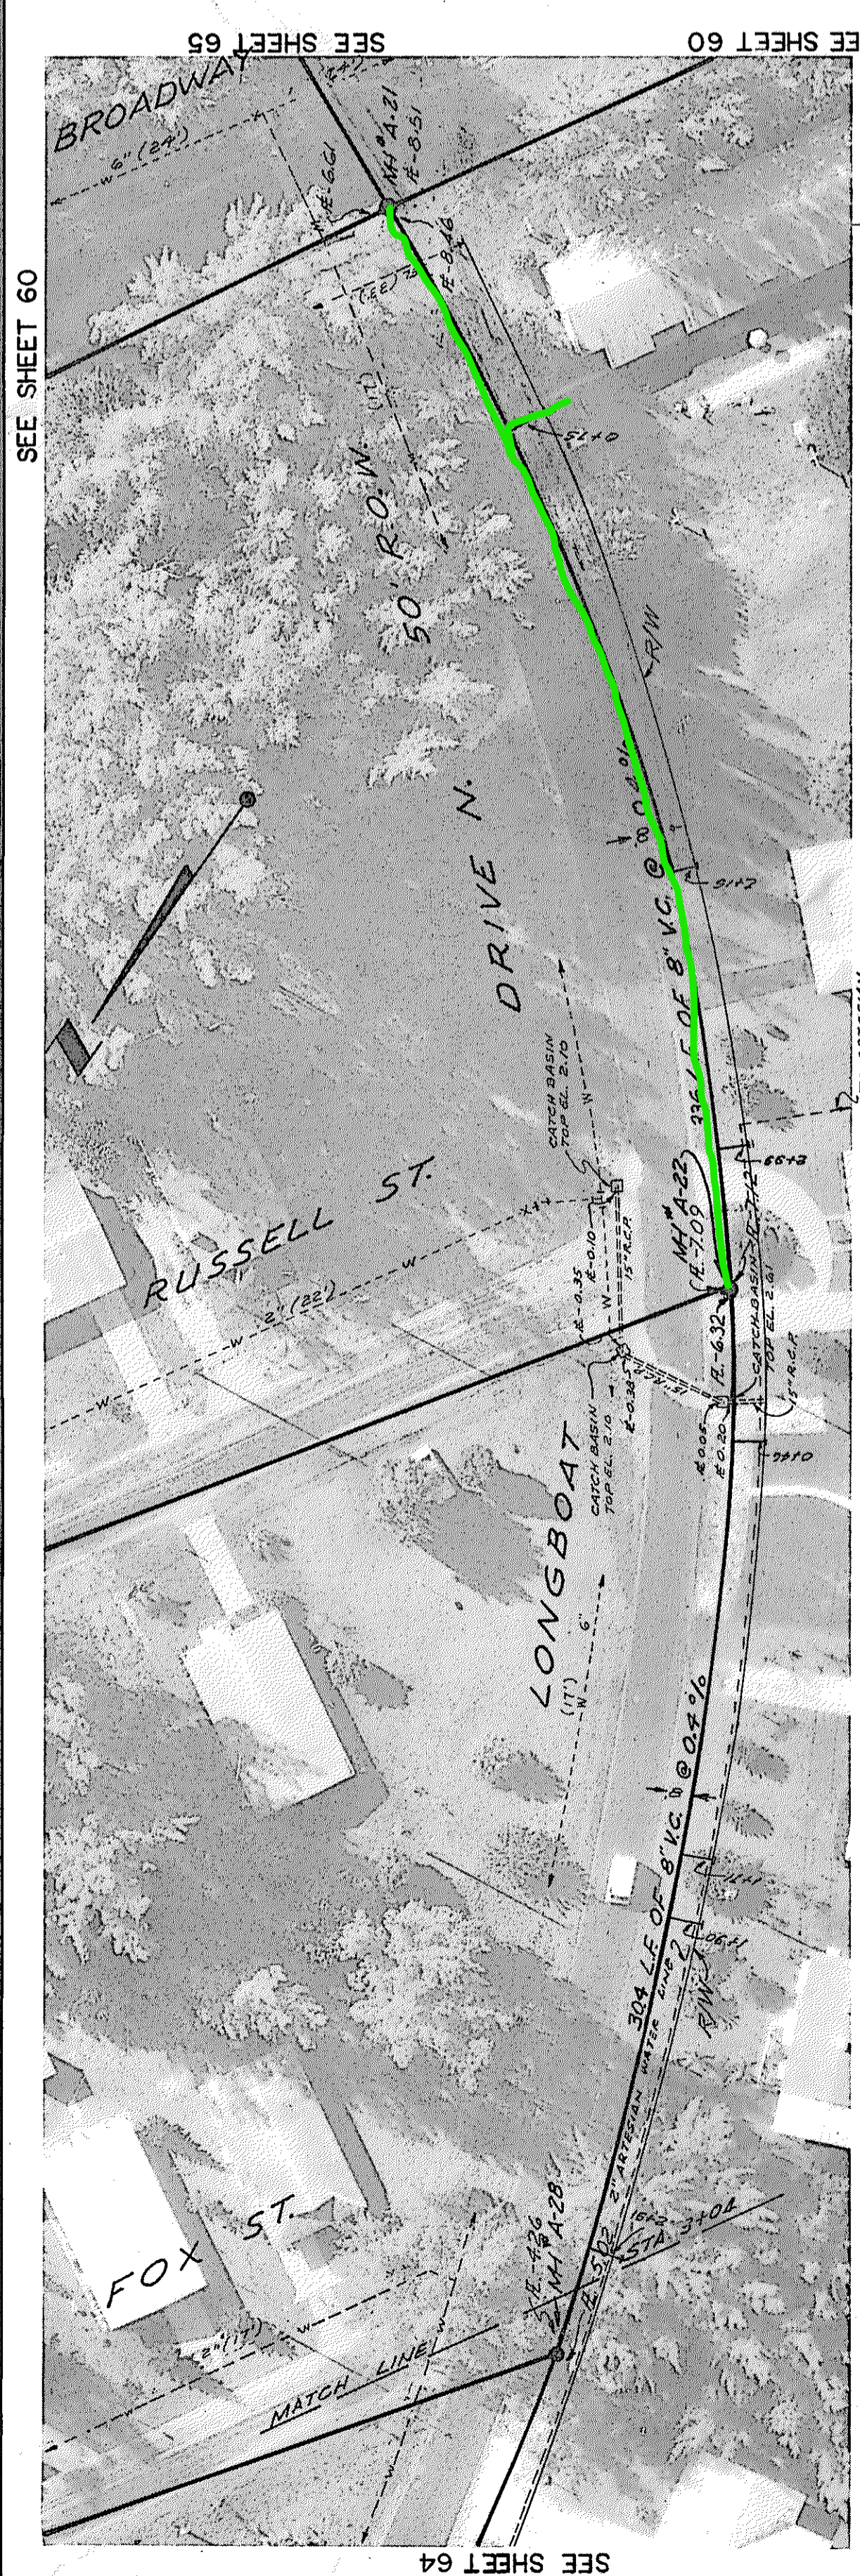


SMALLY, WELLFORD & NALVEN—CONSULTING ENGINEERS—SARASOTA, FLORIDA
 WASTEWATER COLLECTION SYSTEM
 RUSSELL STREET, LONGBOAT DRIVE N.
 TOWN OF LONGBOAT KEY, FLORIDA

DESIGNED BY J. D. WEAVER PHOTO. BOBWHITE AERIAL SURVEYS	DATE: 4-13-73	SCALE: HORIZ. 1"=40' VERT. 1"=4'	BY J. D. WEAVER	REVISION
APPROVED BY	DATE: 4-13-73	SCALE: HORIZ. 1"=40' VERT. 1"=4'	BY J. D. WEAVER	REVISION
CHECKED BY J. D. WEAVER	DATE: 4-13-73	SCALE: HORIZ. 1"=40' VERT. 1"=4'	BY J. D. WEAVER	REVISION
PROJECT NO. 1217-S	DATE: 4-13-73	SCALE: HORIZ. 1"=40' VERT. 1"=4'	BY J. D. WEAVER	REVISION

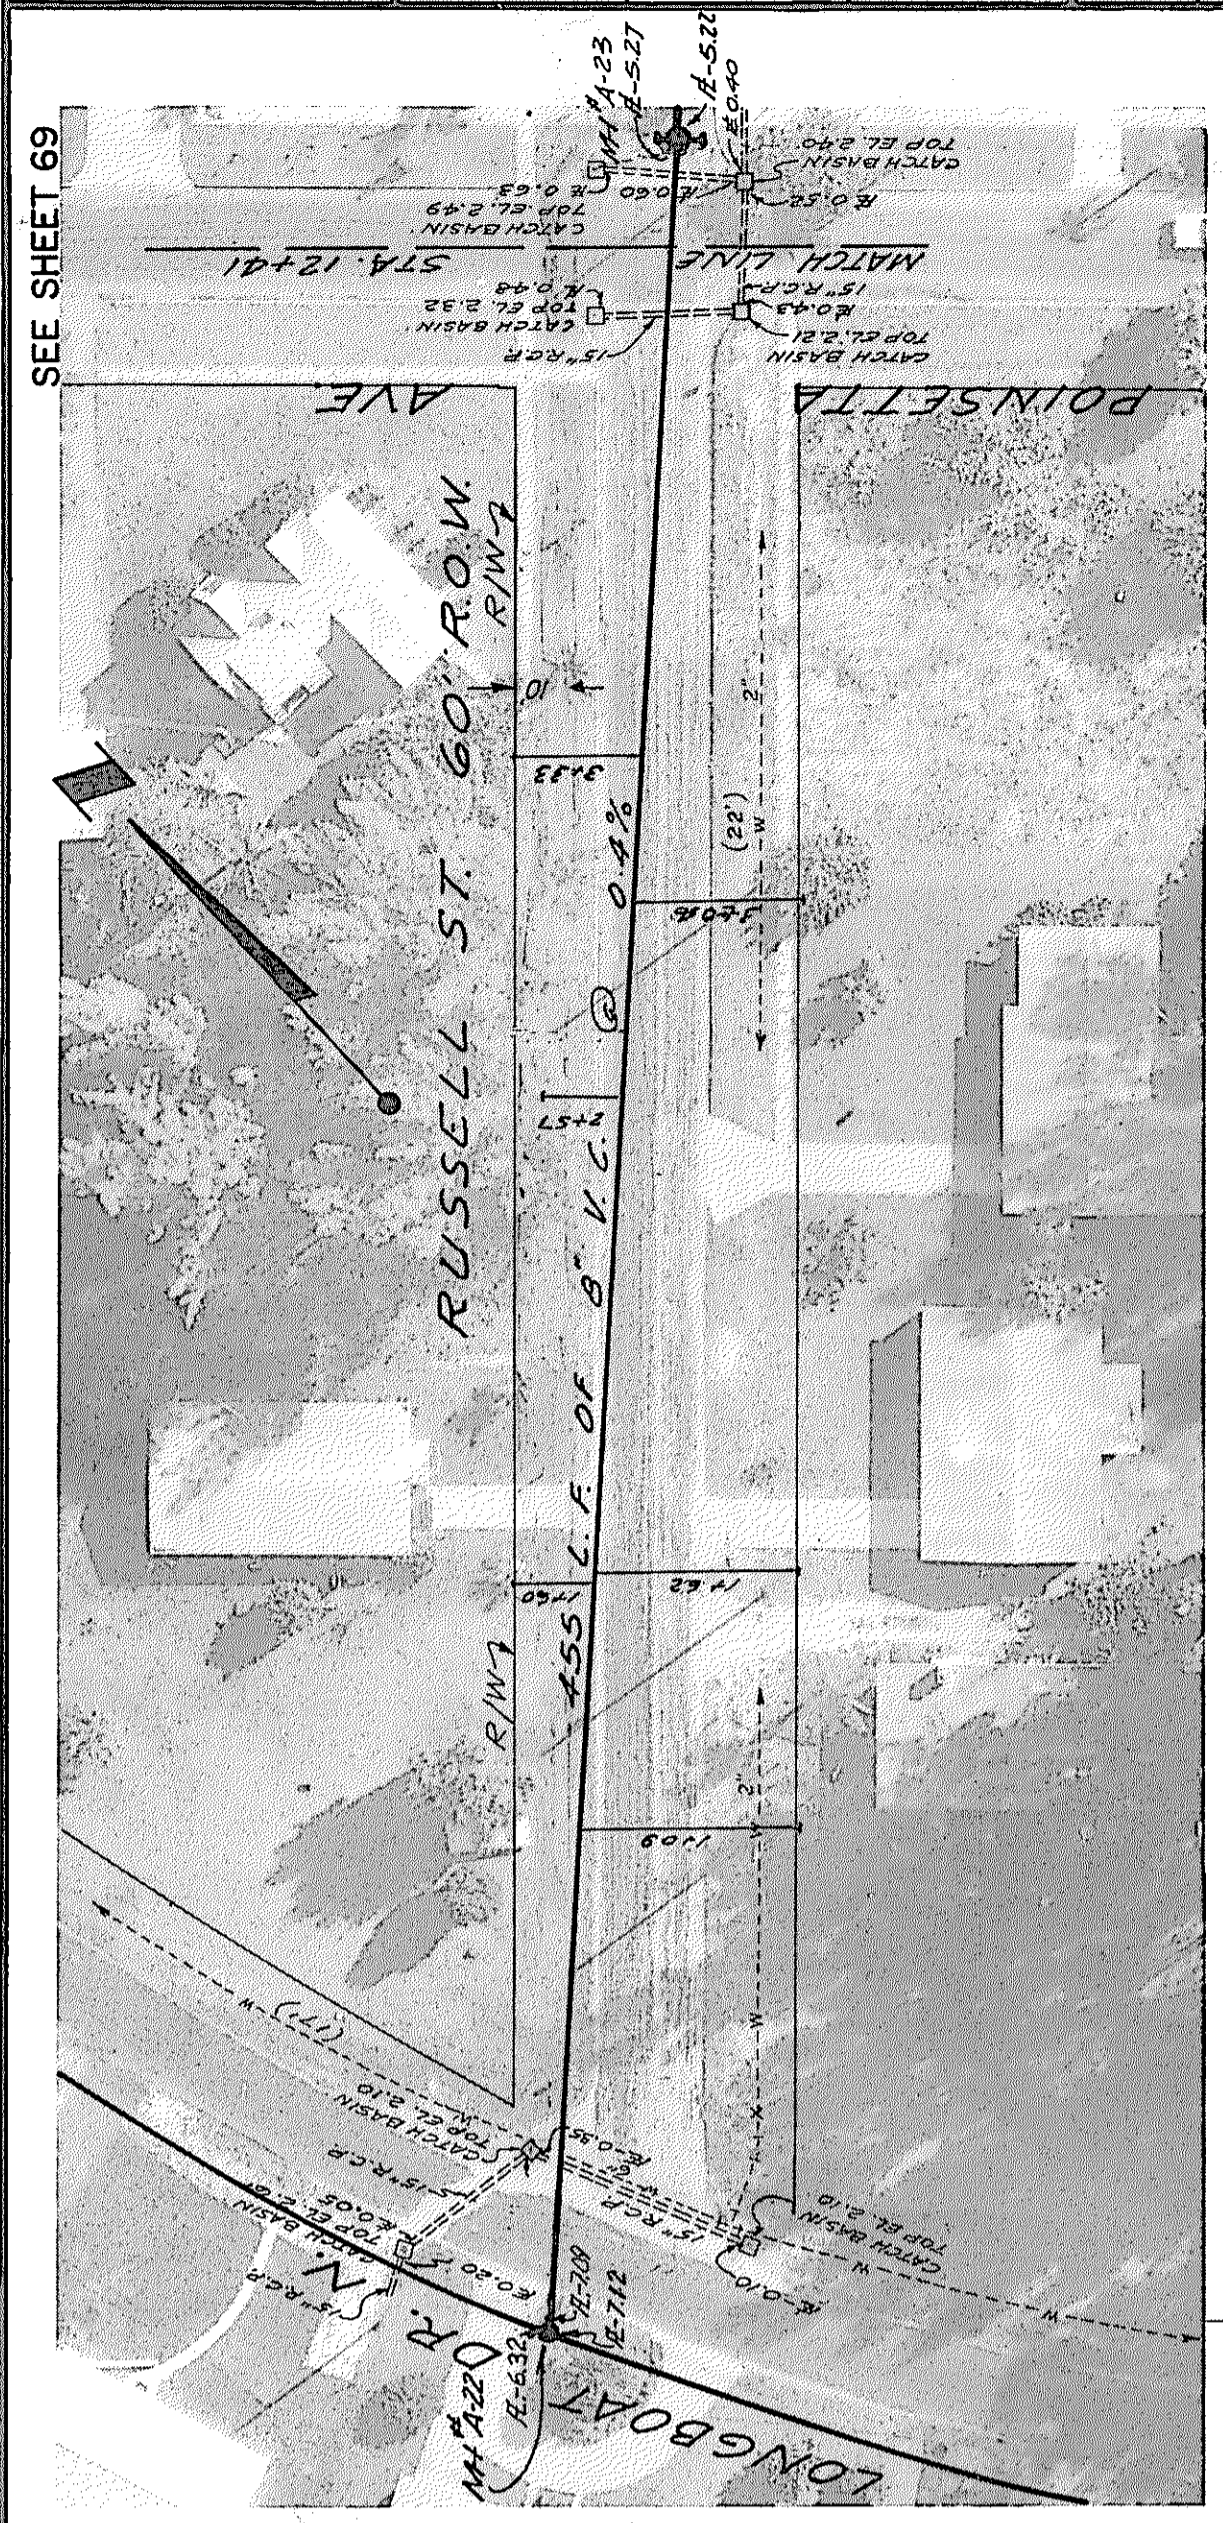

AS BUILT PLANS