
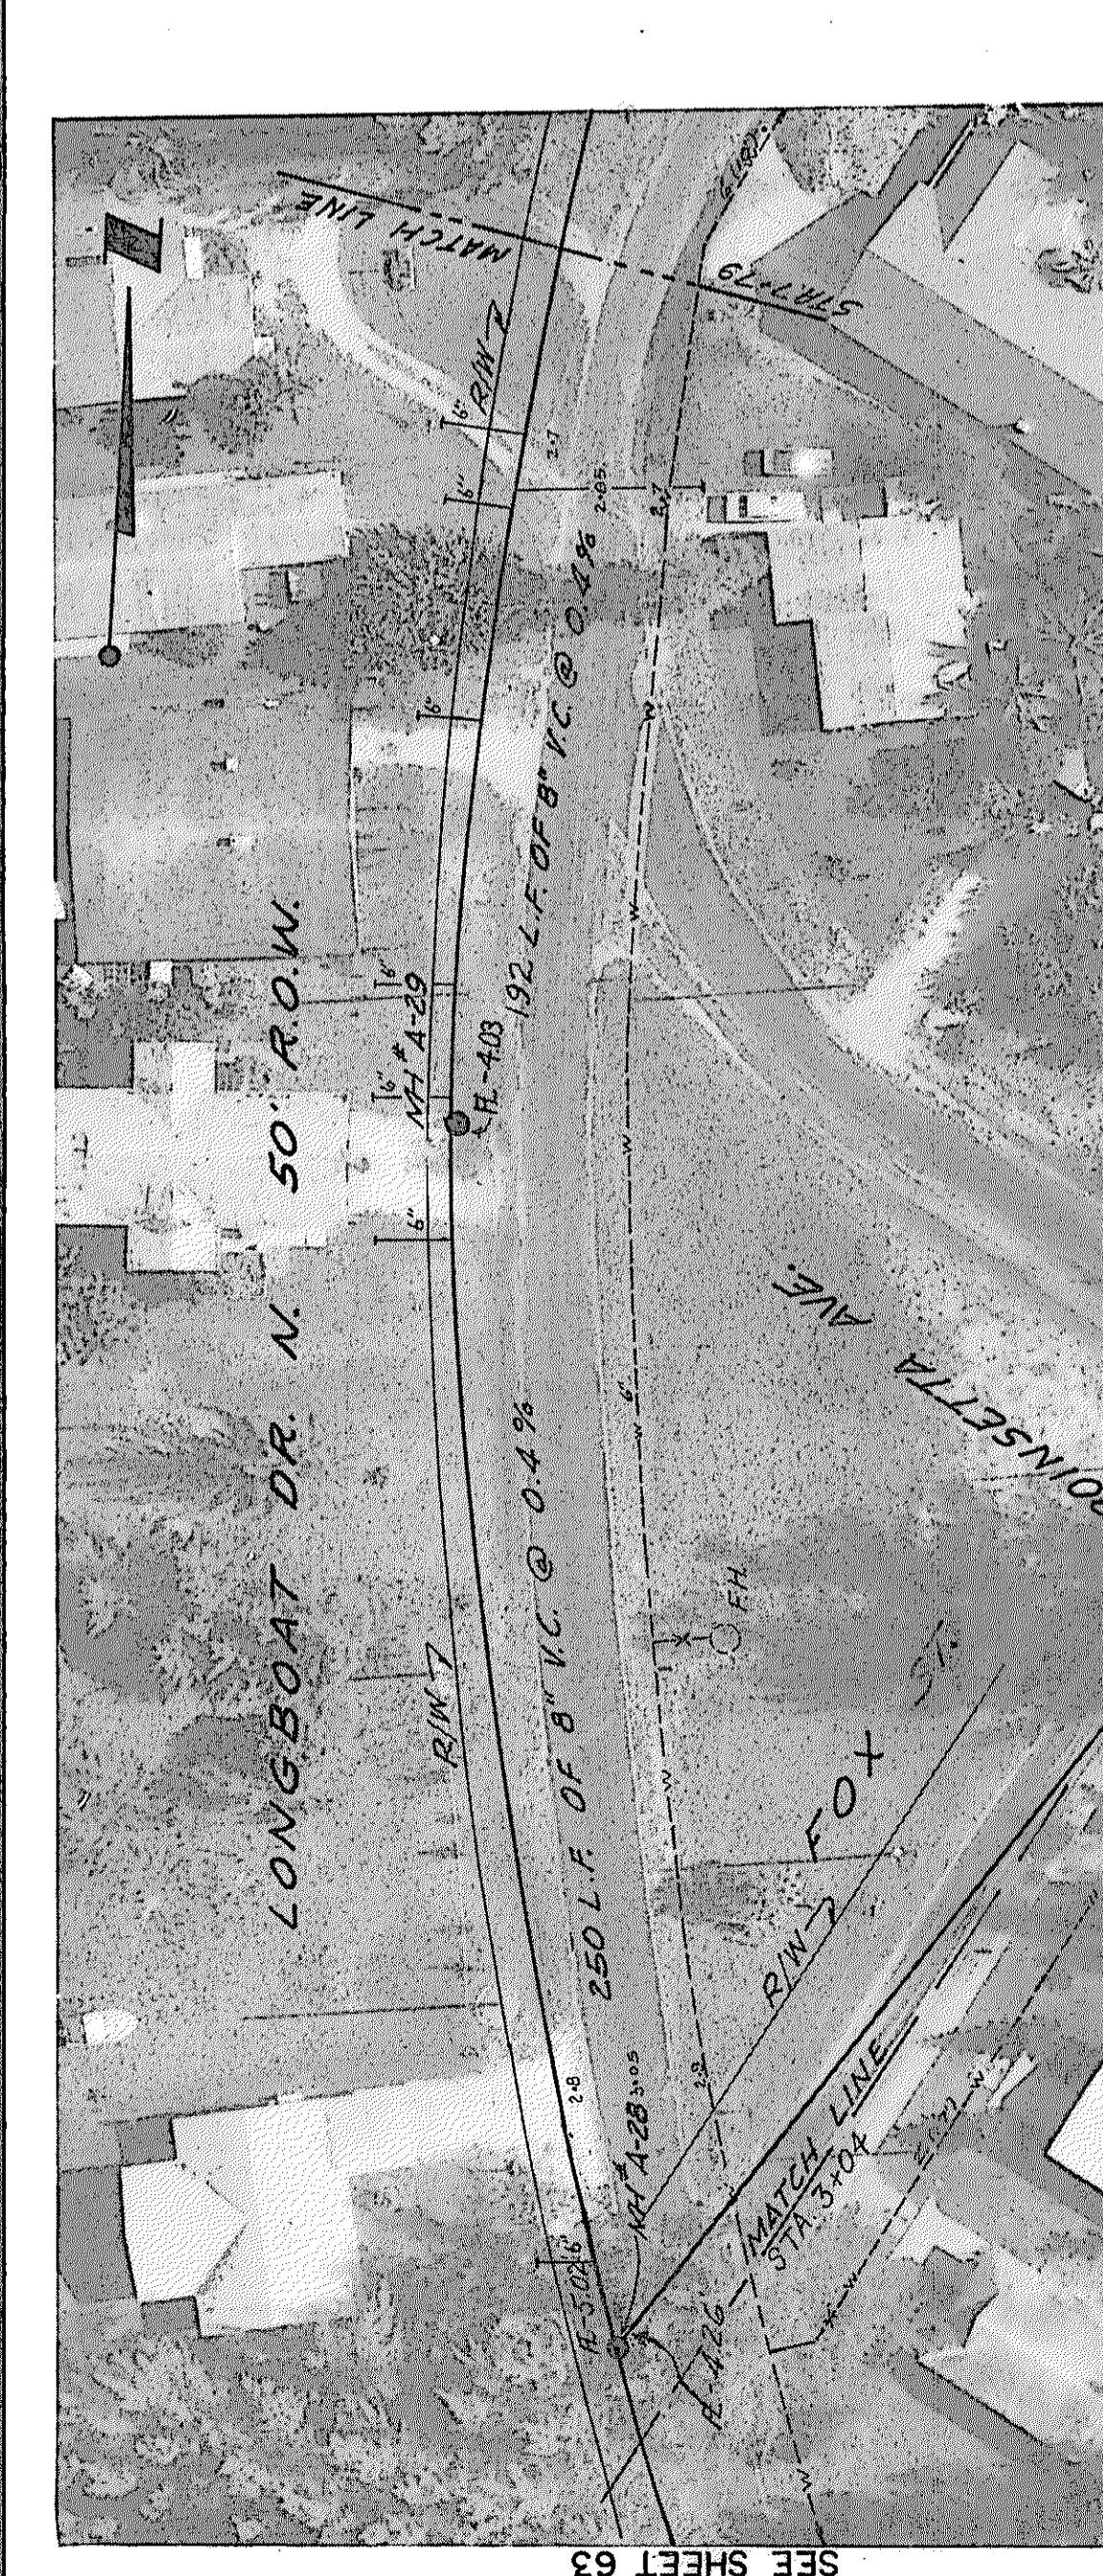
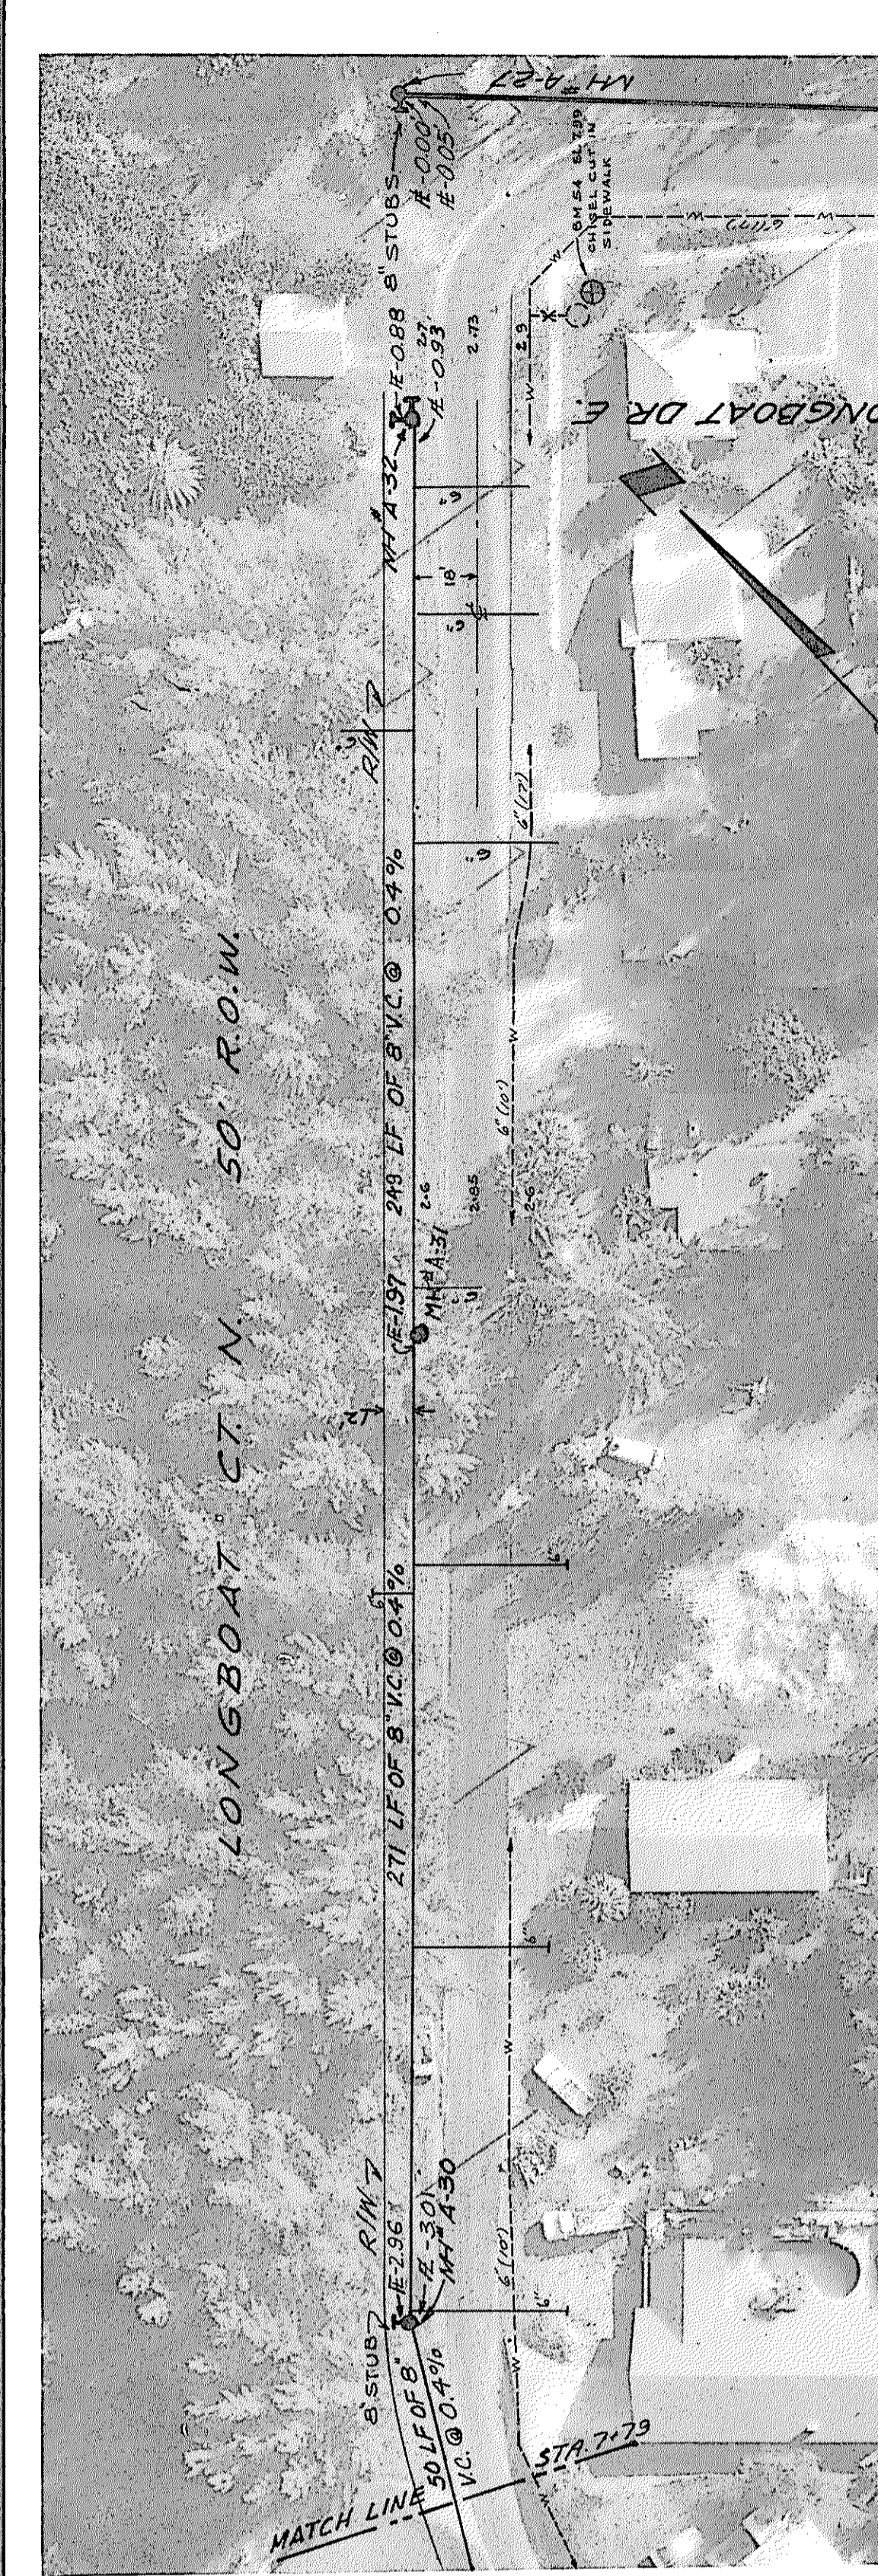
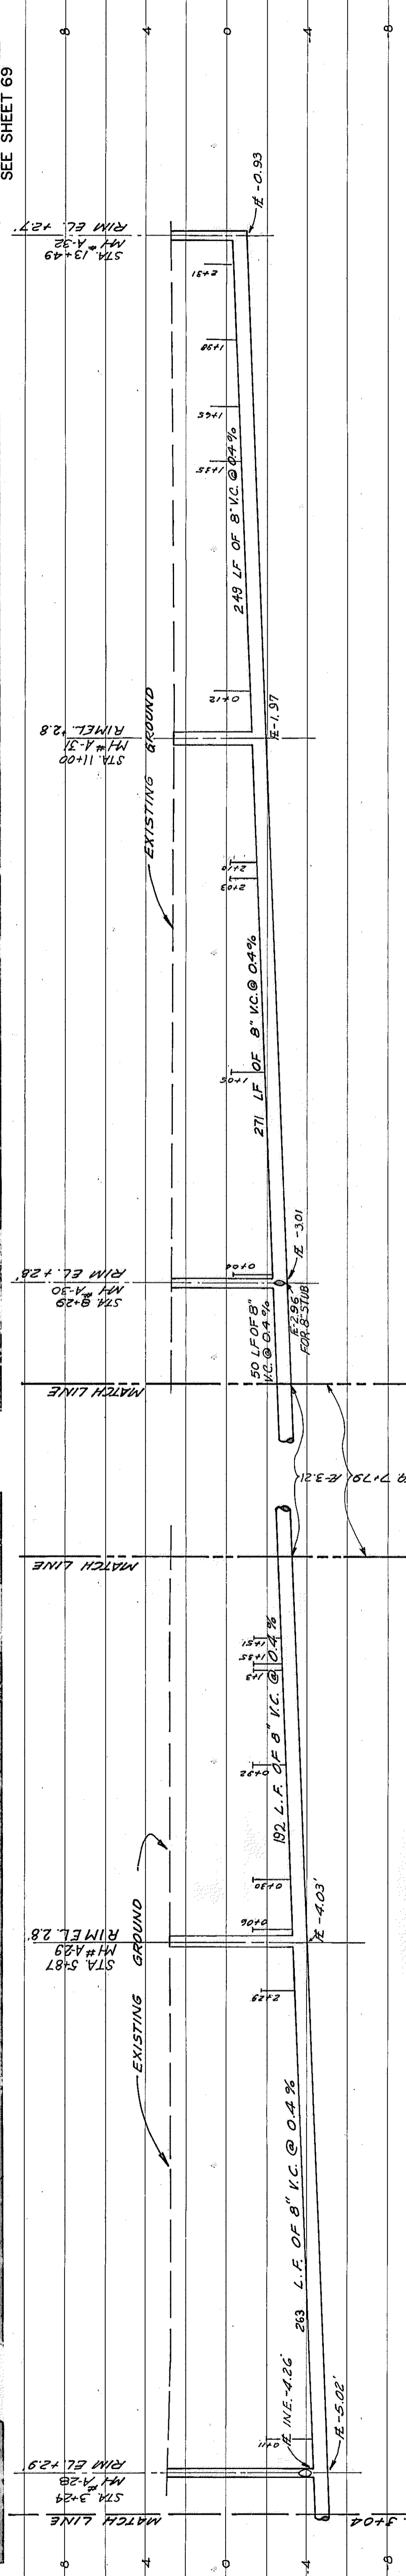
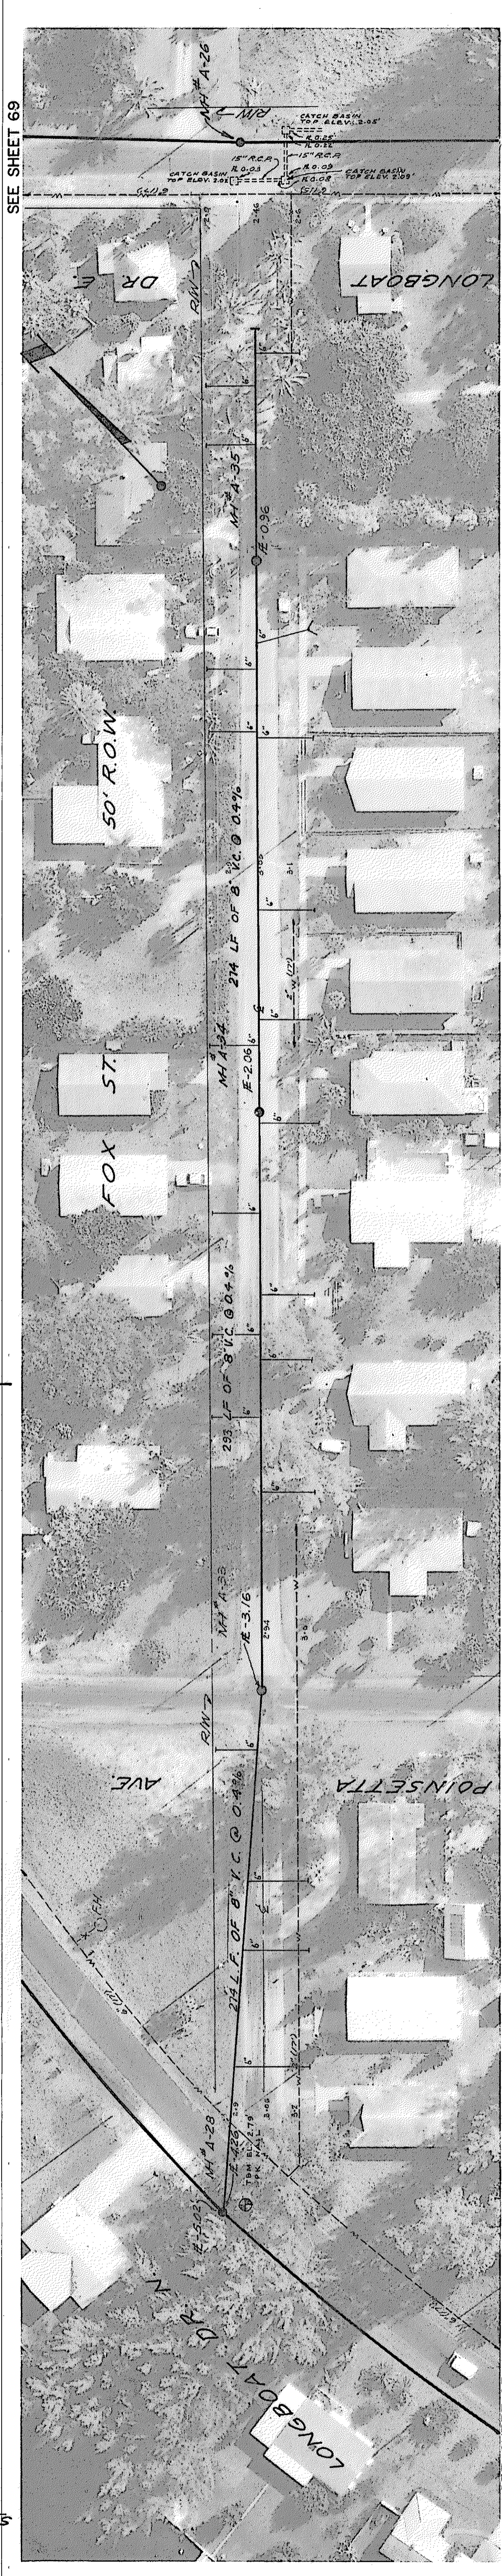


SMALLY, WELLFORD & NALVEN—CONSULTING ENGINEERS—SARASOTA, FLORIDA

WASTEWATER COLLECTION SYSTEM  
LONGBOAT DR. N, LONGBOAT CT N, FOX ST

TOWN OF LONGBOAT KEY, FLORIDA

BY: R.T.M.	DATE: 4-12-73	SCALE: HORIZ. 1"=40'	VERT. 1"=4'	DRAWN BY: P.C.W.	CHECKED BY: U.G./M.M.	PROJECT NO: 1217-S	DESIGNED BY: J.D.W./M.M./L.D.L.	APPROVED BY: [Signature]
REVISION		DATE		AS BUILT		9-30-77		STATION MAIN SIZE & FLOW LINES

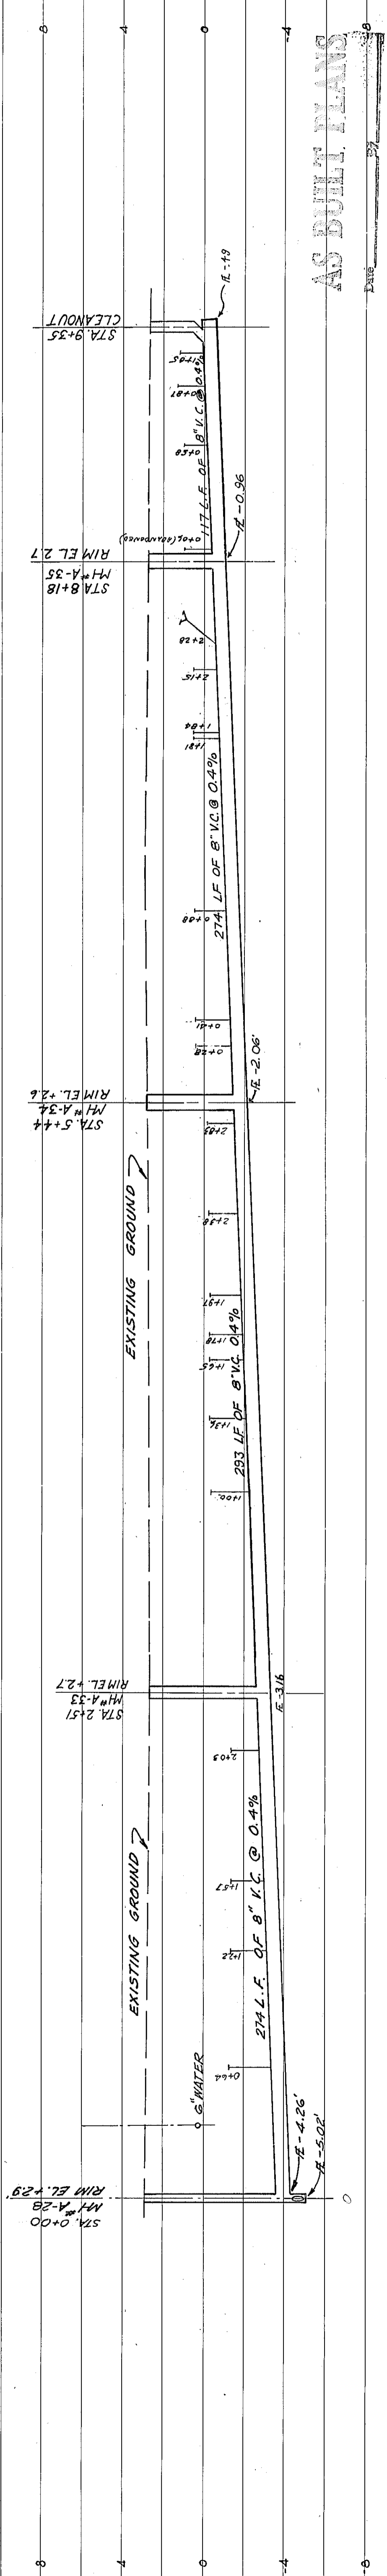

AS BUILT PLANS

SEE SHEET 69

SEE SHEET 63

SEE SHEET 69

SEE SHEET 63