


NO CONSTRUCTION



SEE SHEET 60

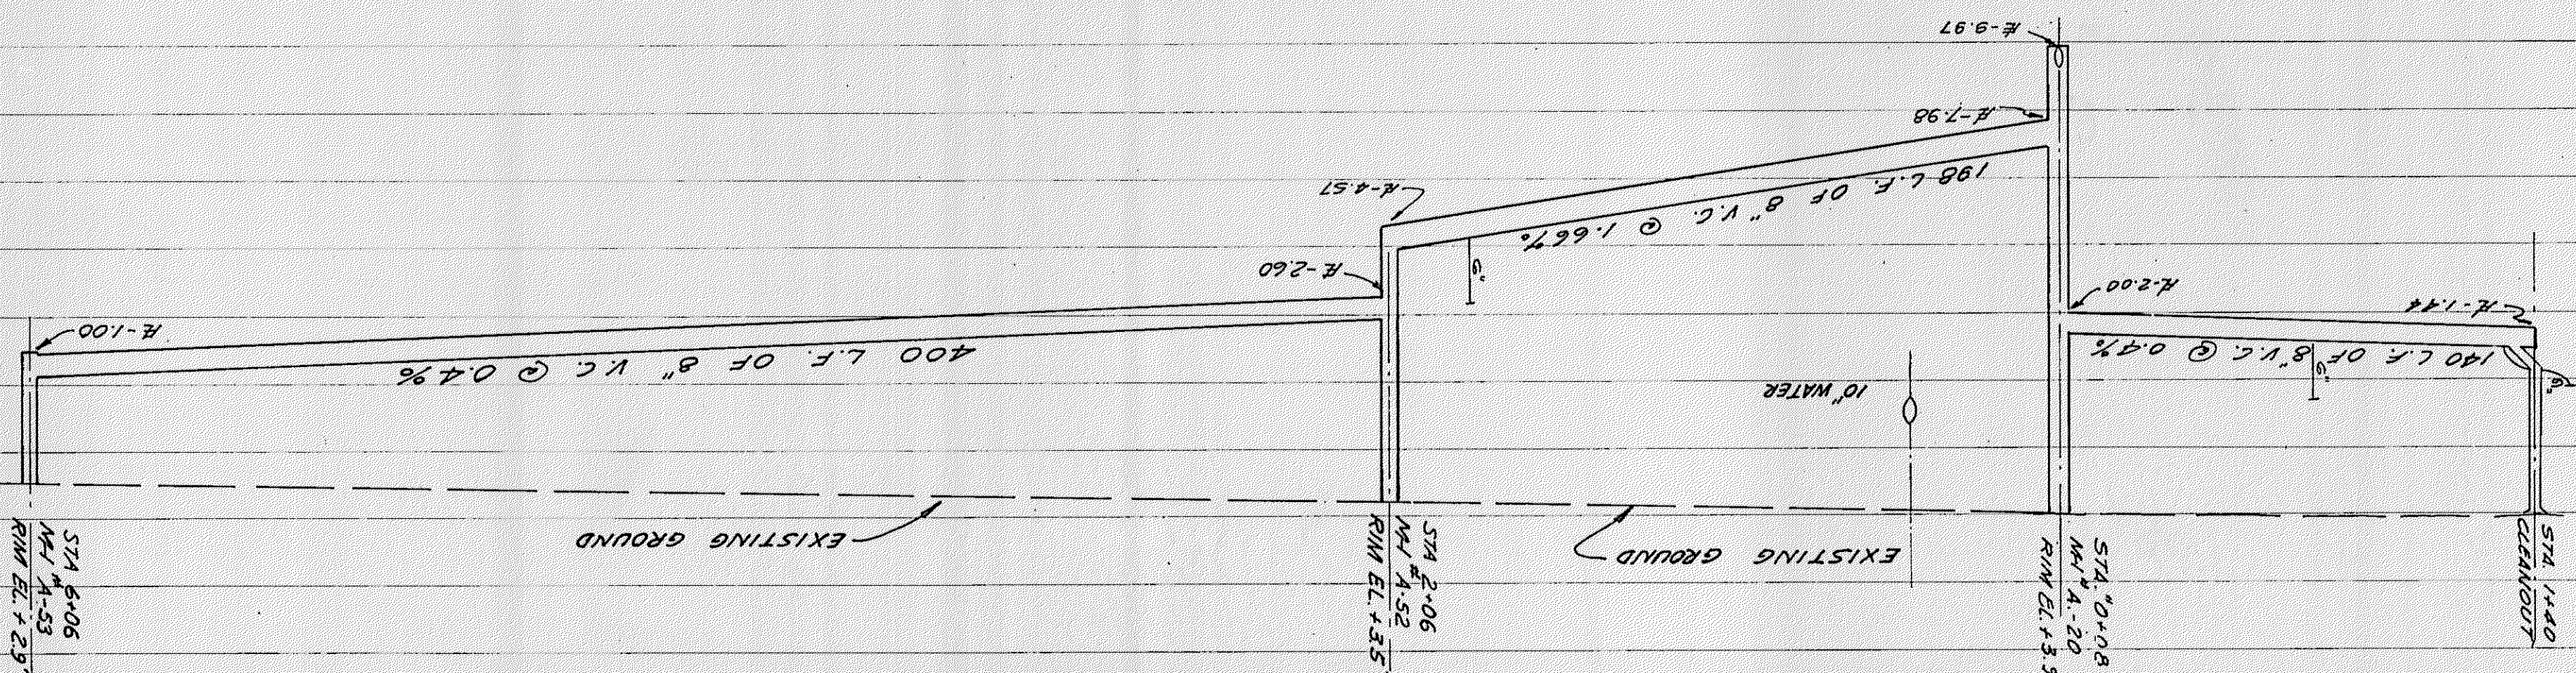

AS BUILT PLANS

REVISION	A	FOR:	TOWN OF LONGBOAT KEY, FLORIDA	LTR.	A	DATE	6/24/74	BY	P.C.W.	SCALE:	HORIZ. 1"=40'	DATE	4-13-73	DESIGNED BY	J.D.W., E.M.M.
SHEET NUMBER	70	PROJECT	PALM DR., CEDAR ST.	DATE	6/24/74	PROJECT	WASTEWATER COLLECTION SYSTEM	CHECKED BY	P.C.W.	VERT. 1"=4'	PROJECT NO.	1217-S	APPROVED BY	DAVID HENSE, P.E.	
		ENGINEER	SMALLY, WELLFORD & NALVEN—CONSULTING ENGINEERS—SARASOTA, FLORIDA			INDEX NO.	E-1217-274			APPROVED	1972				