
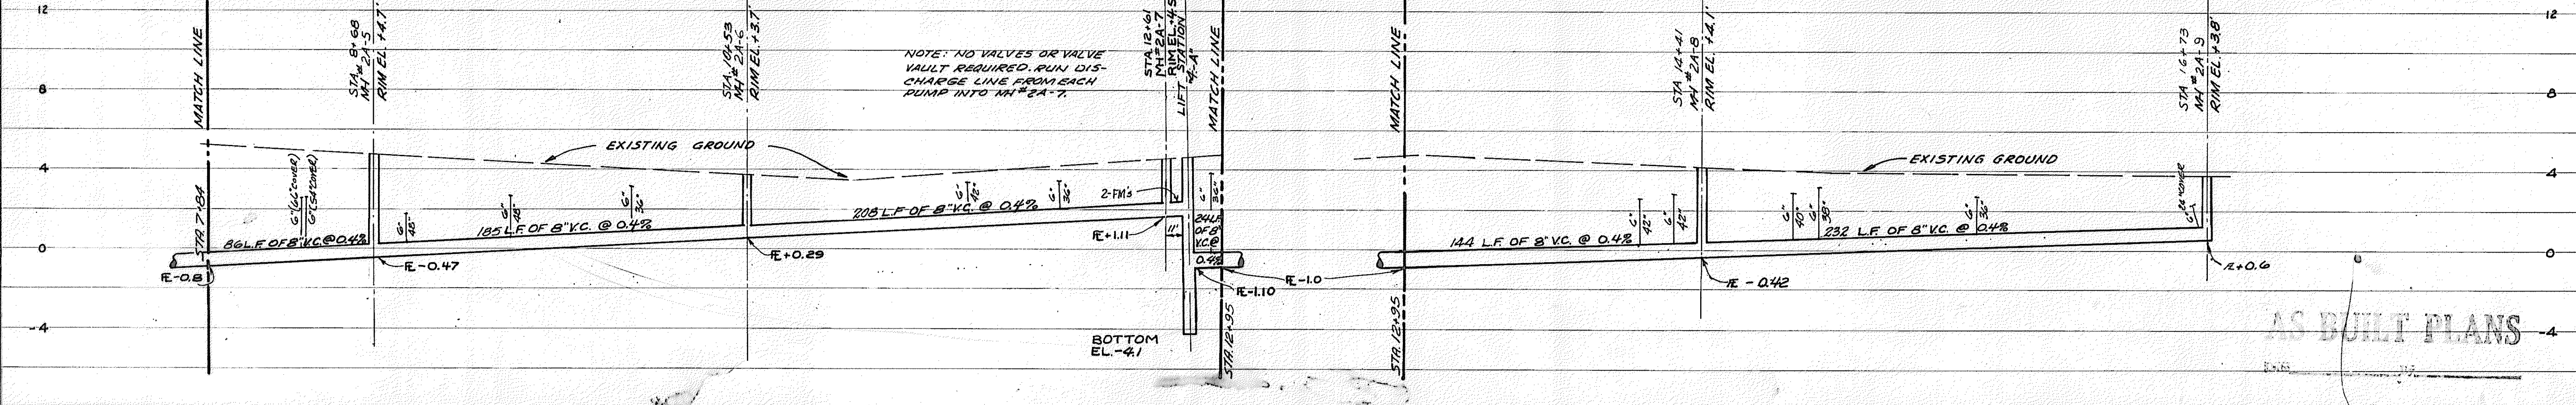
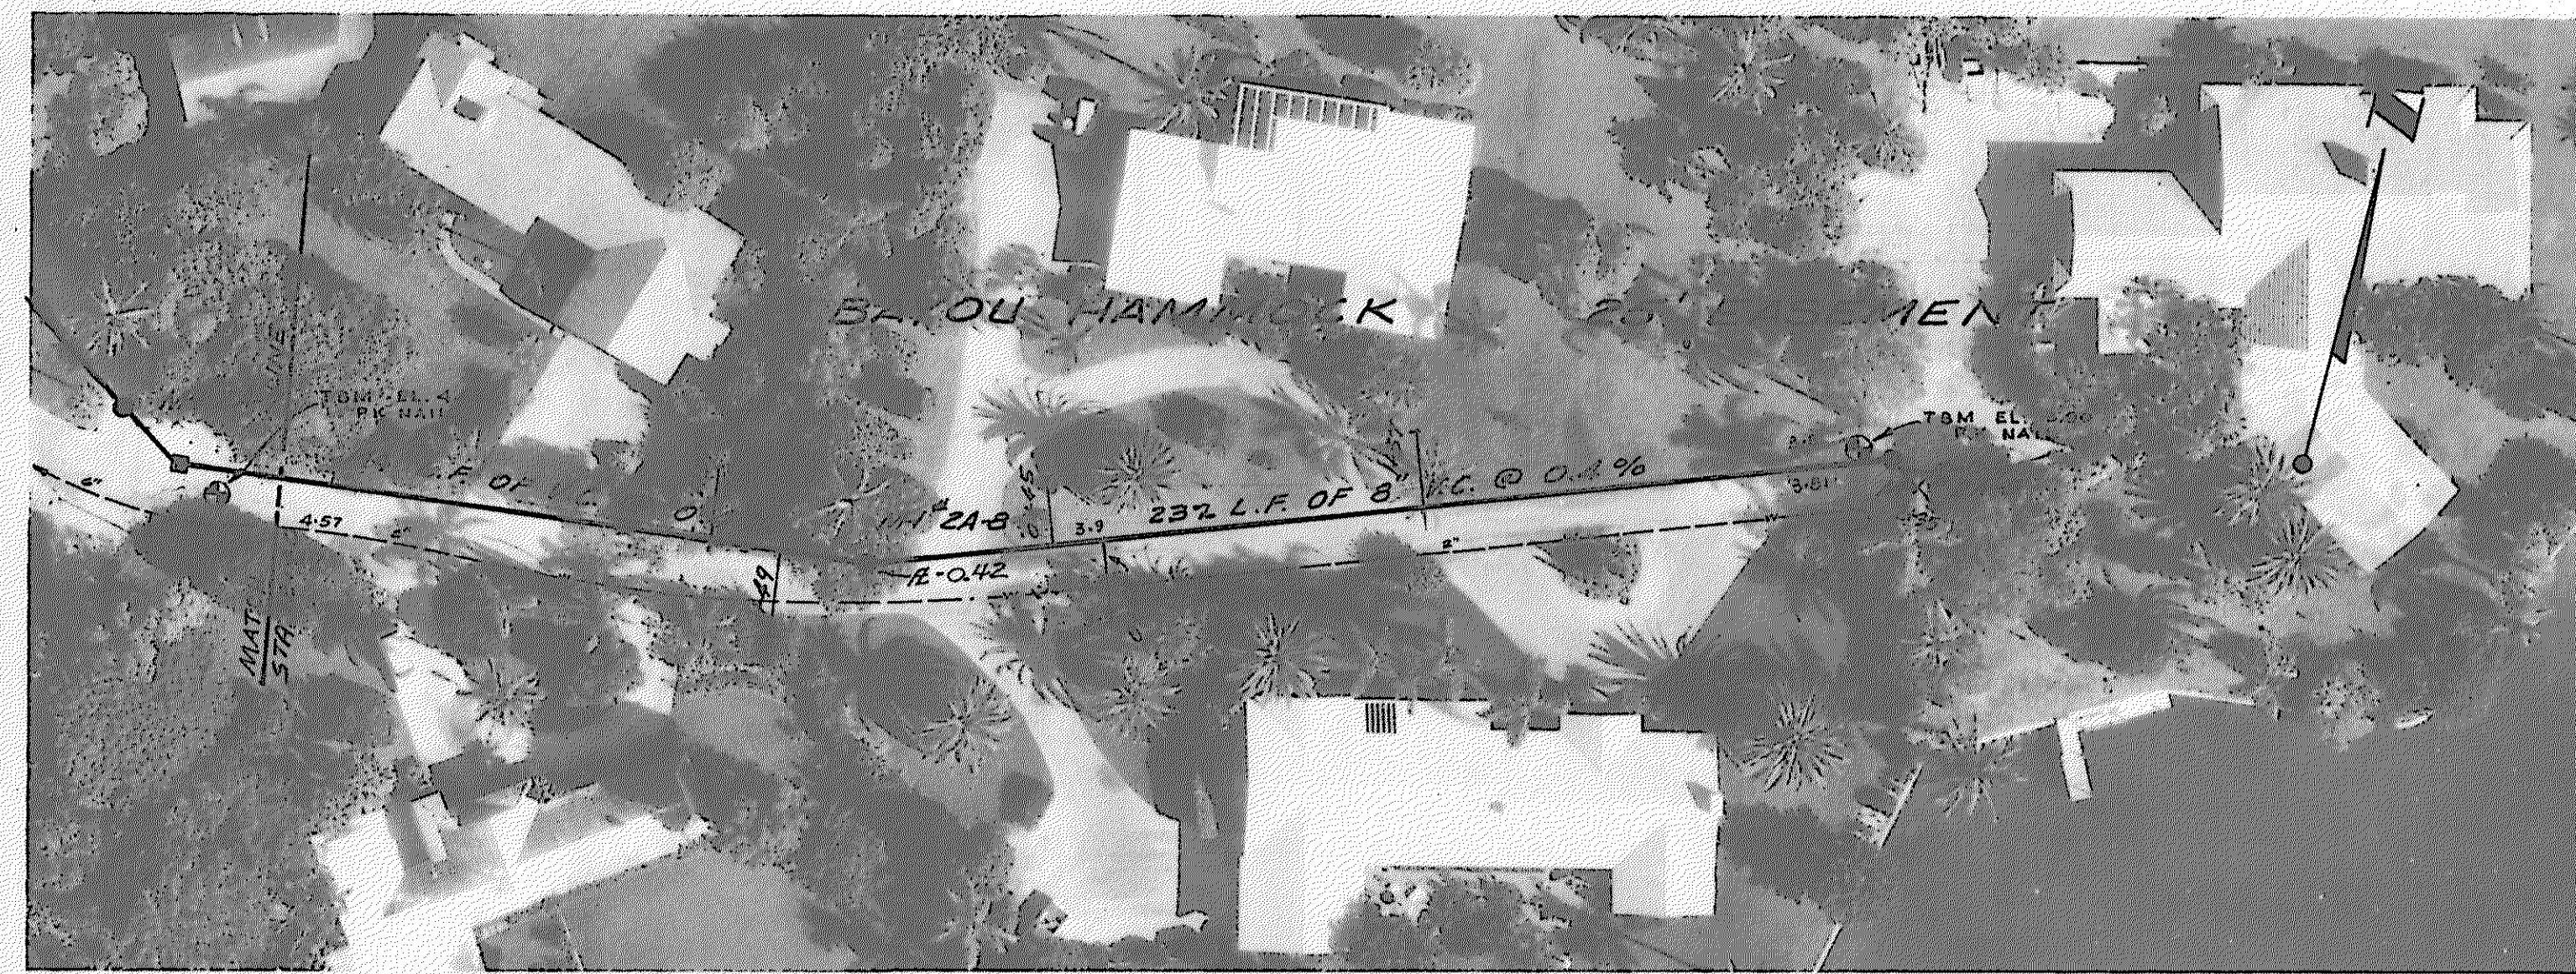


SEE SHEET 66

SEE SHEET 65

SEE SHEET 65

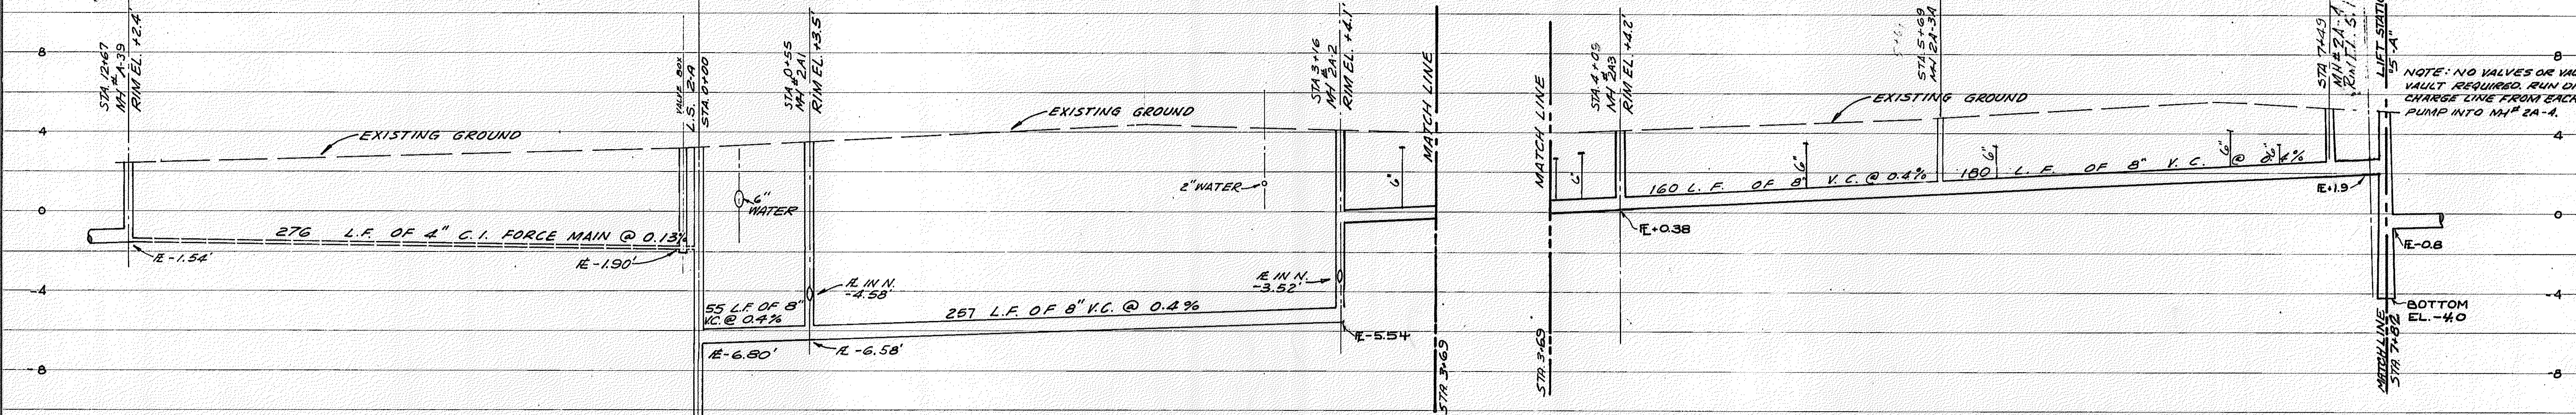

DESIGNED BY J.O.W./E.M.V. L.D.L.	DATE 4-13-73	SCALE HORIZ. 1"=40' VERT. 1"=4'	REVISION 1. S.S. 2A 2. SHALLOWER DEPTH OF BURY 3. REVISED MANHOLE NUMBERS & ADJACENT NOTES AS BUILT	APPROVED BY J.G. AMM E.C.	PROJECT NO. 1217-S
BY D.S.C. L.M.V.	CHECKED BY P.C.W.	DATE 10-27-75 10-27-75 2-7-75 9-8-75	L.T.R. A B C D	FOR: TOWN OF LONGBOAT KEY, FLORIDA JACKSON WAY, BAYOU HAMMOCK WASTEWATER COLLECTION SYSTEM	SHEET NUMBER 71
AS BUILT PLANS				SMALLY, WELLFORD & NALVEN — CONSULTING ENGINEERS — SARASOTA, FLORIDA	
				INDEX NO. E-1217-275	