

FOR: TOWN OF LONGBOAT KEY, FLORIDA	W.M.F-7 TO M.F-8 WASTEWATER COLLECTION SYSTEM	PROJECT NO. 1217-S
DATE: 4-13-73	DESIGNED BY: J.D.M., E.M.M.	CHECKED BY: U.G., M.M.
SCALE: HORIZ. 1" = 40'	VERT. 1" = 4'	DRAWN BY: P.C.M.
BY: [Signature]	REVISION: [Table]	APPROVED BY: [Signature]


AS BUILT PLANS

DATE: [Blank]

REVISION: 'A'

SHEET NUMBER 74

INDEX NO. E-1217-278

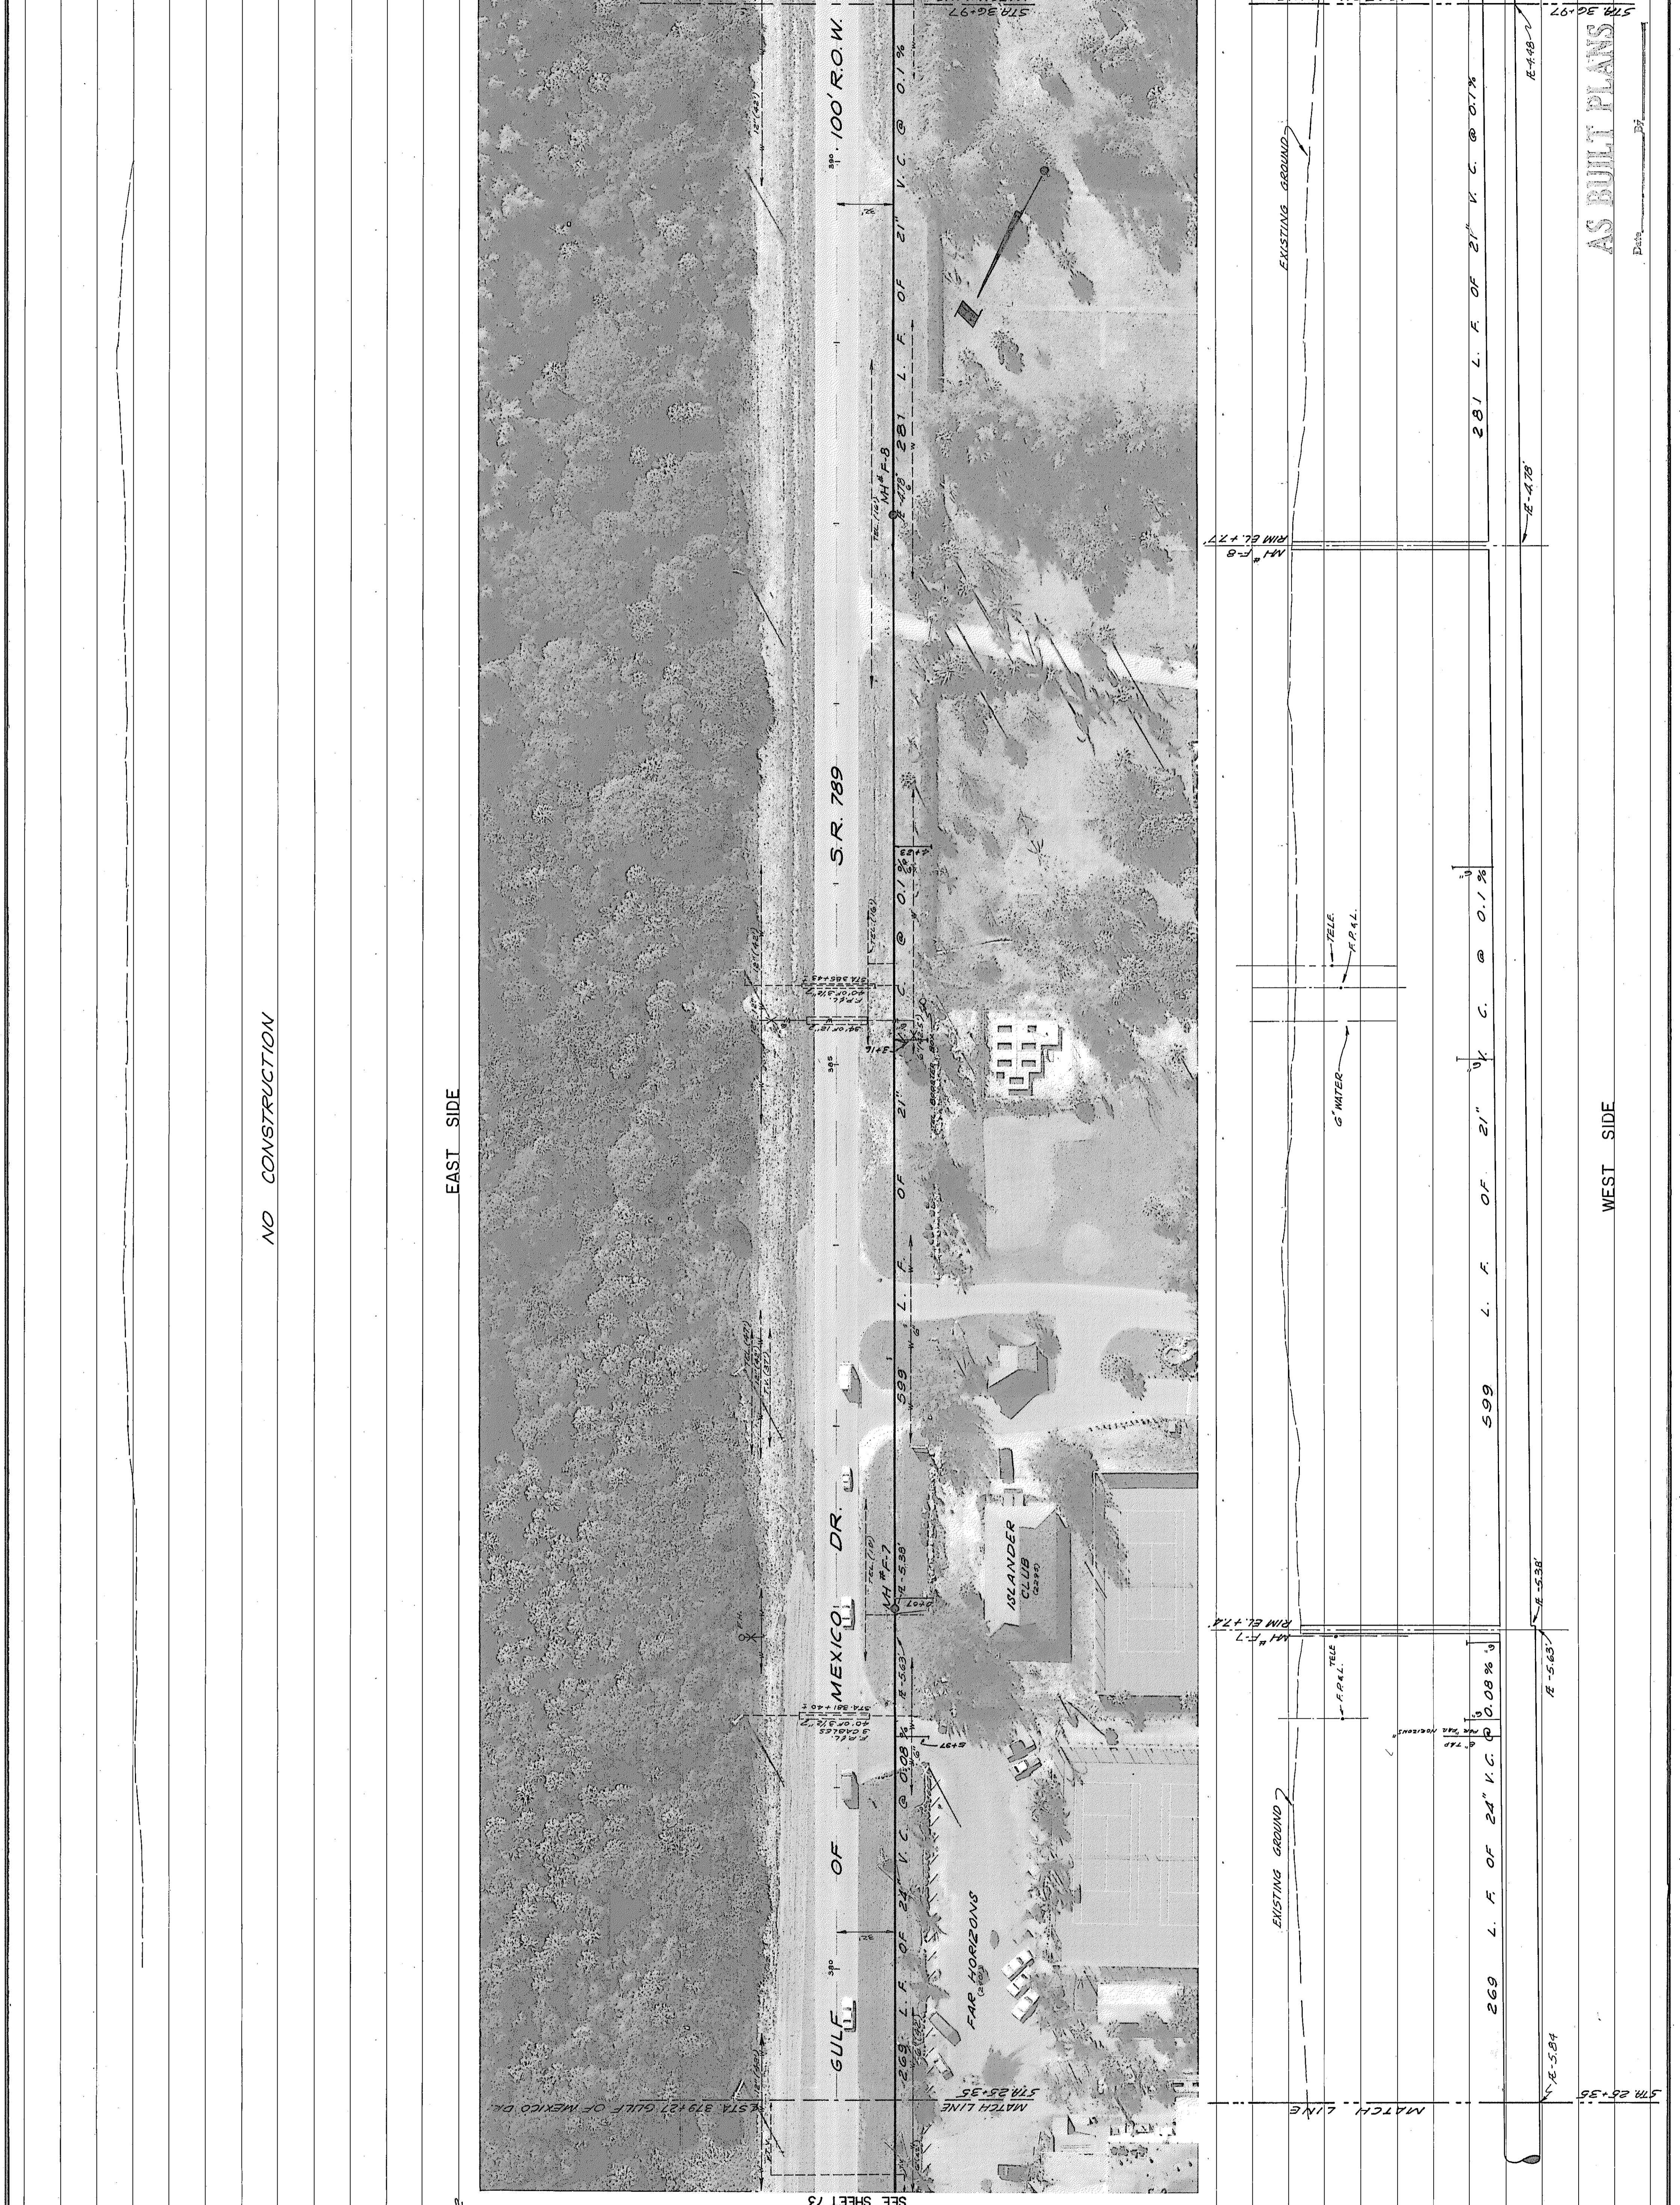

NO CONSTRUCTION

EAST SIDE

WEST SIDE