

SMALLY, WELLFORD & NALVEN—CONSULTING ENGINEERS—SARASOTA, FLORIDA

WASTEWATER COLLECTION SYSTEM  
W MH-F-13 TO MH-F-14  
GULF OF MEXICO DRIVE

TOWN OF LONGBOAT KEY, FLORIDA

FOR: REVISION

DESIGNED BY J.D.W./E.N.N.  
CHECKED BY U.S. M.W.  
PROJECT NO. 1217-S


DATE: 4-13-73  
SCALE: 1"=40'

APPROVED BY  
SEPT. 1972

NO.	DATE	DESCRIPTION
1	4-13-73	ISSUED FOR PERMIT
2		
3		
NO CONSTRUCTION

EAST SIDE

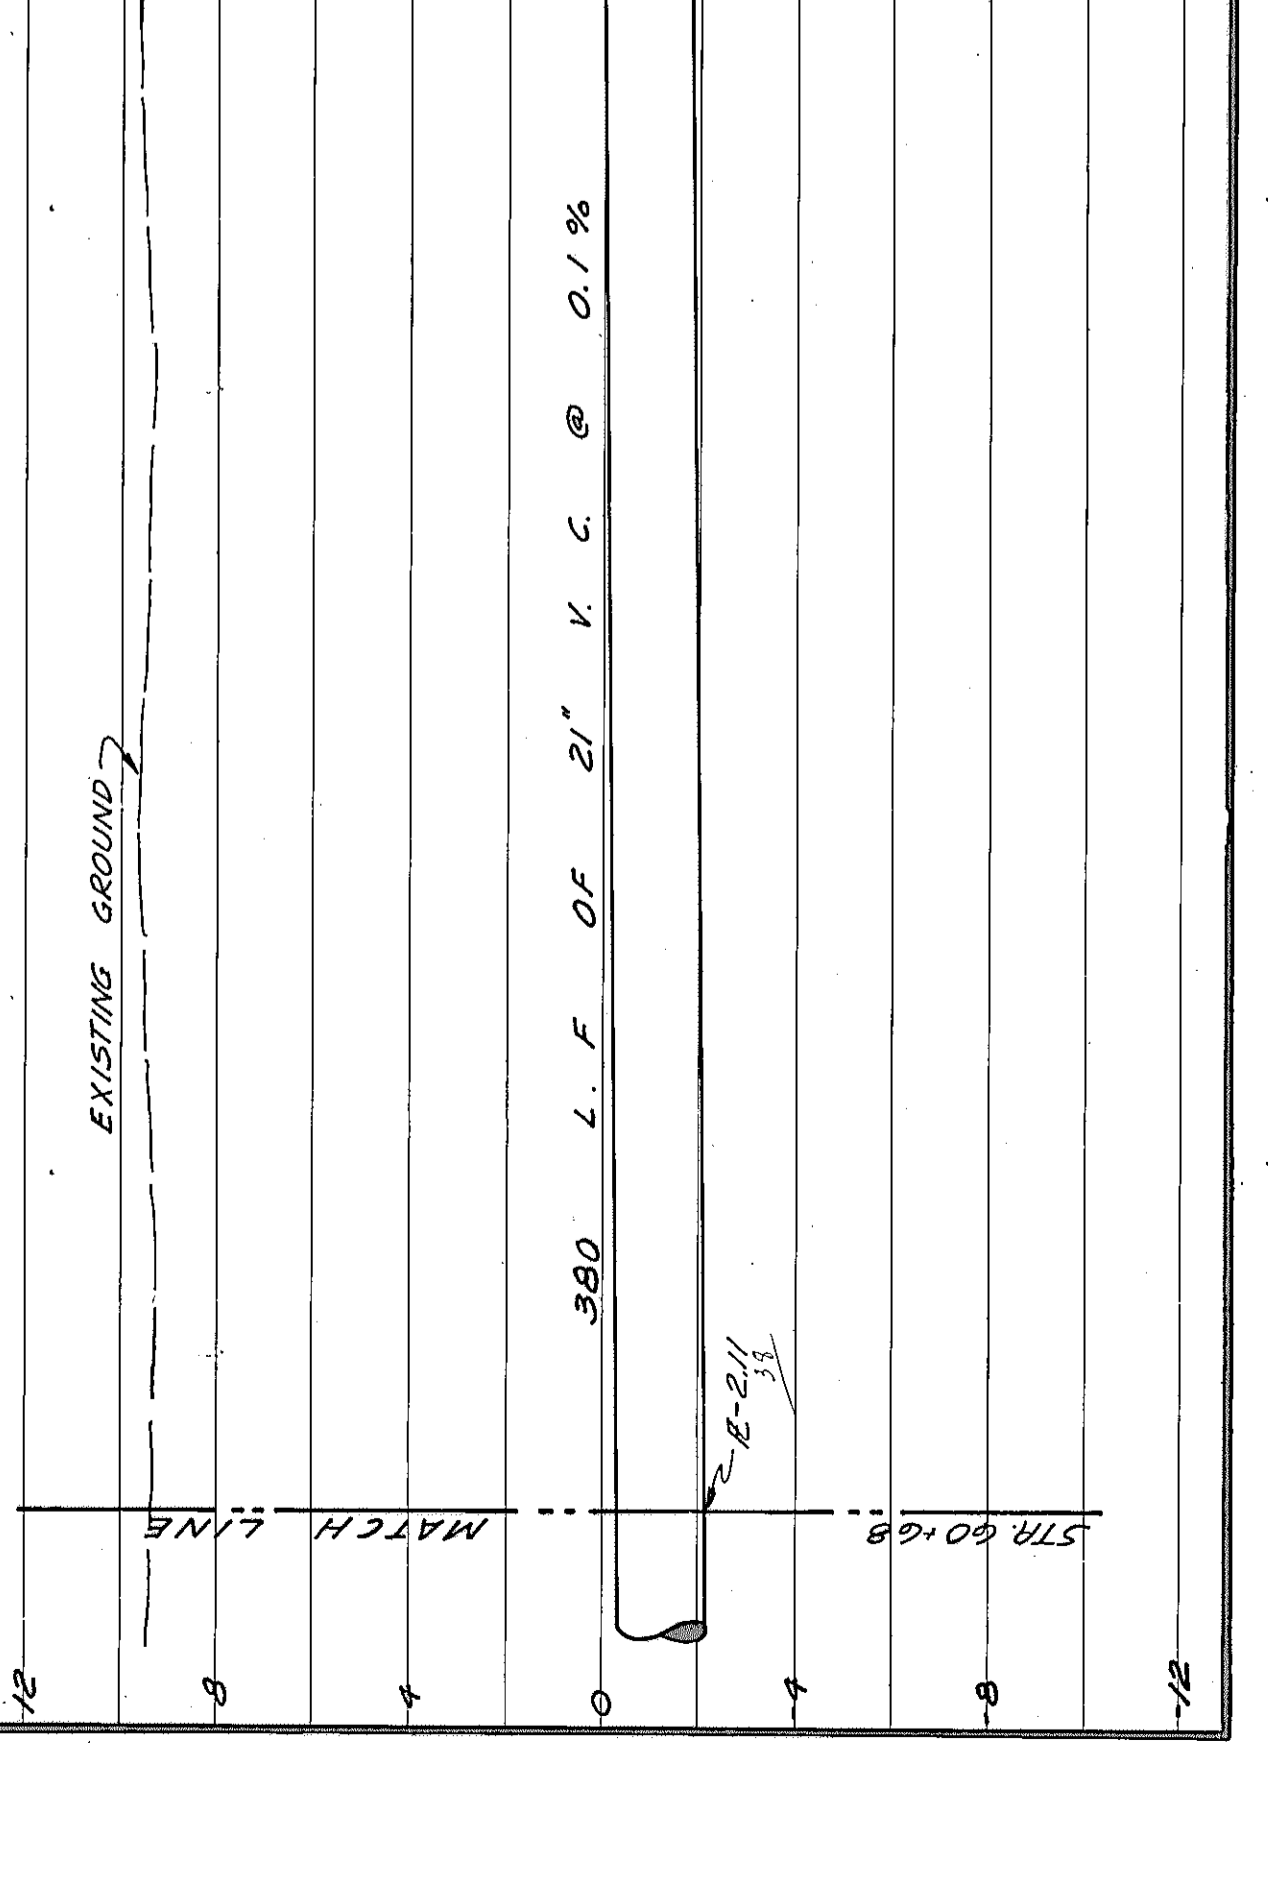

WEST SIDE

AS BUILT PLANS