


FOR: TOWN OF LONGBOAT KEY, FLORIDA	DATE: 7-2-74	REVISION	BY	SCALE: 1"=40'	DATE: 4-13-73	DESIGNED BY: J.D.W. E.M.M. L.O.T.	APPROVED BY: [Signature]	PROJECT NO. 1217-S	DRAWN BY: L.B. M.W.	CHECKED BY: [Signature]	DESIGNED BY: J.D.W. E.M.M. L.O.T.	APPROVED BY: [Signature]	PROJECT NO. 1217-S	DESIGNED BY: J.D.W. E.M.M. L.O.T.	APPROVED BY: [Signature]
------------------------------------	--------------	----------	----	---------------	---------------	-----------------------------------	--------------------------	--------------------	---------------------	-------------------------	-----------------------------------	--------------------------	--------------------	-----------------------------------	--------------------------

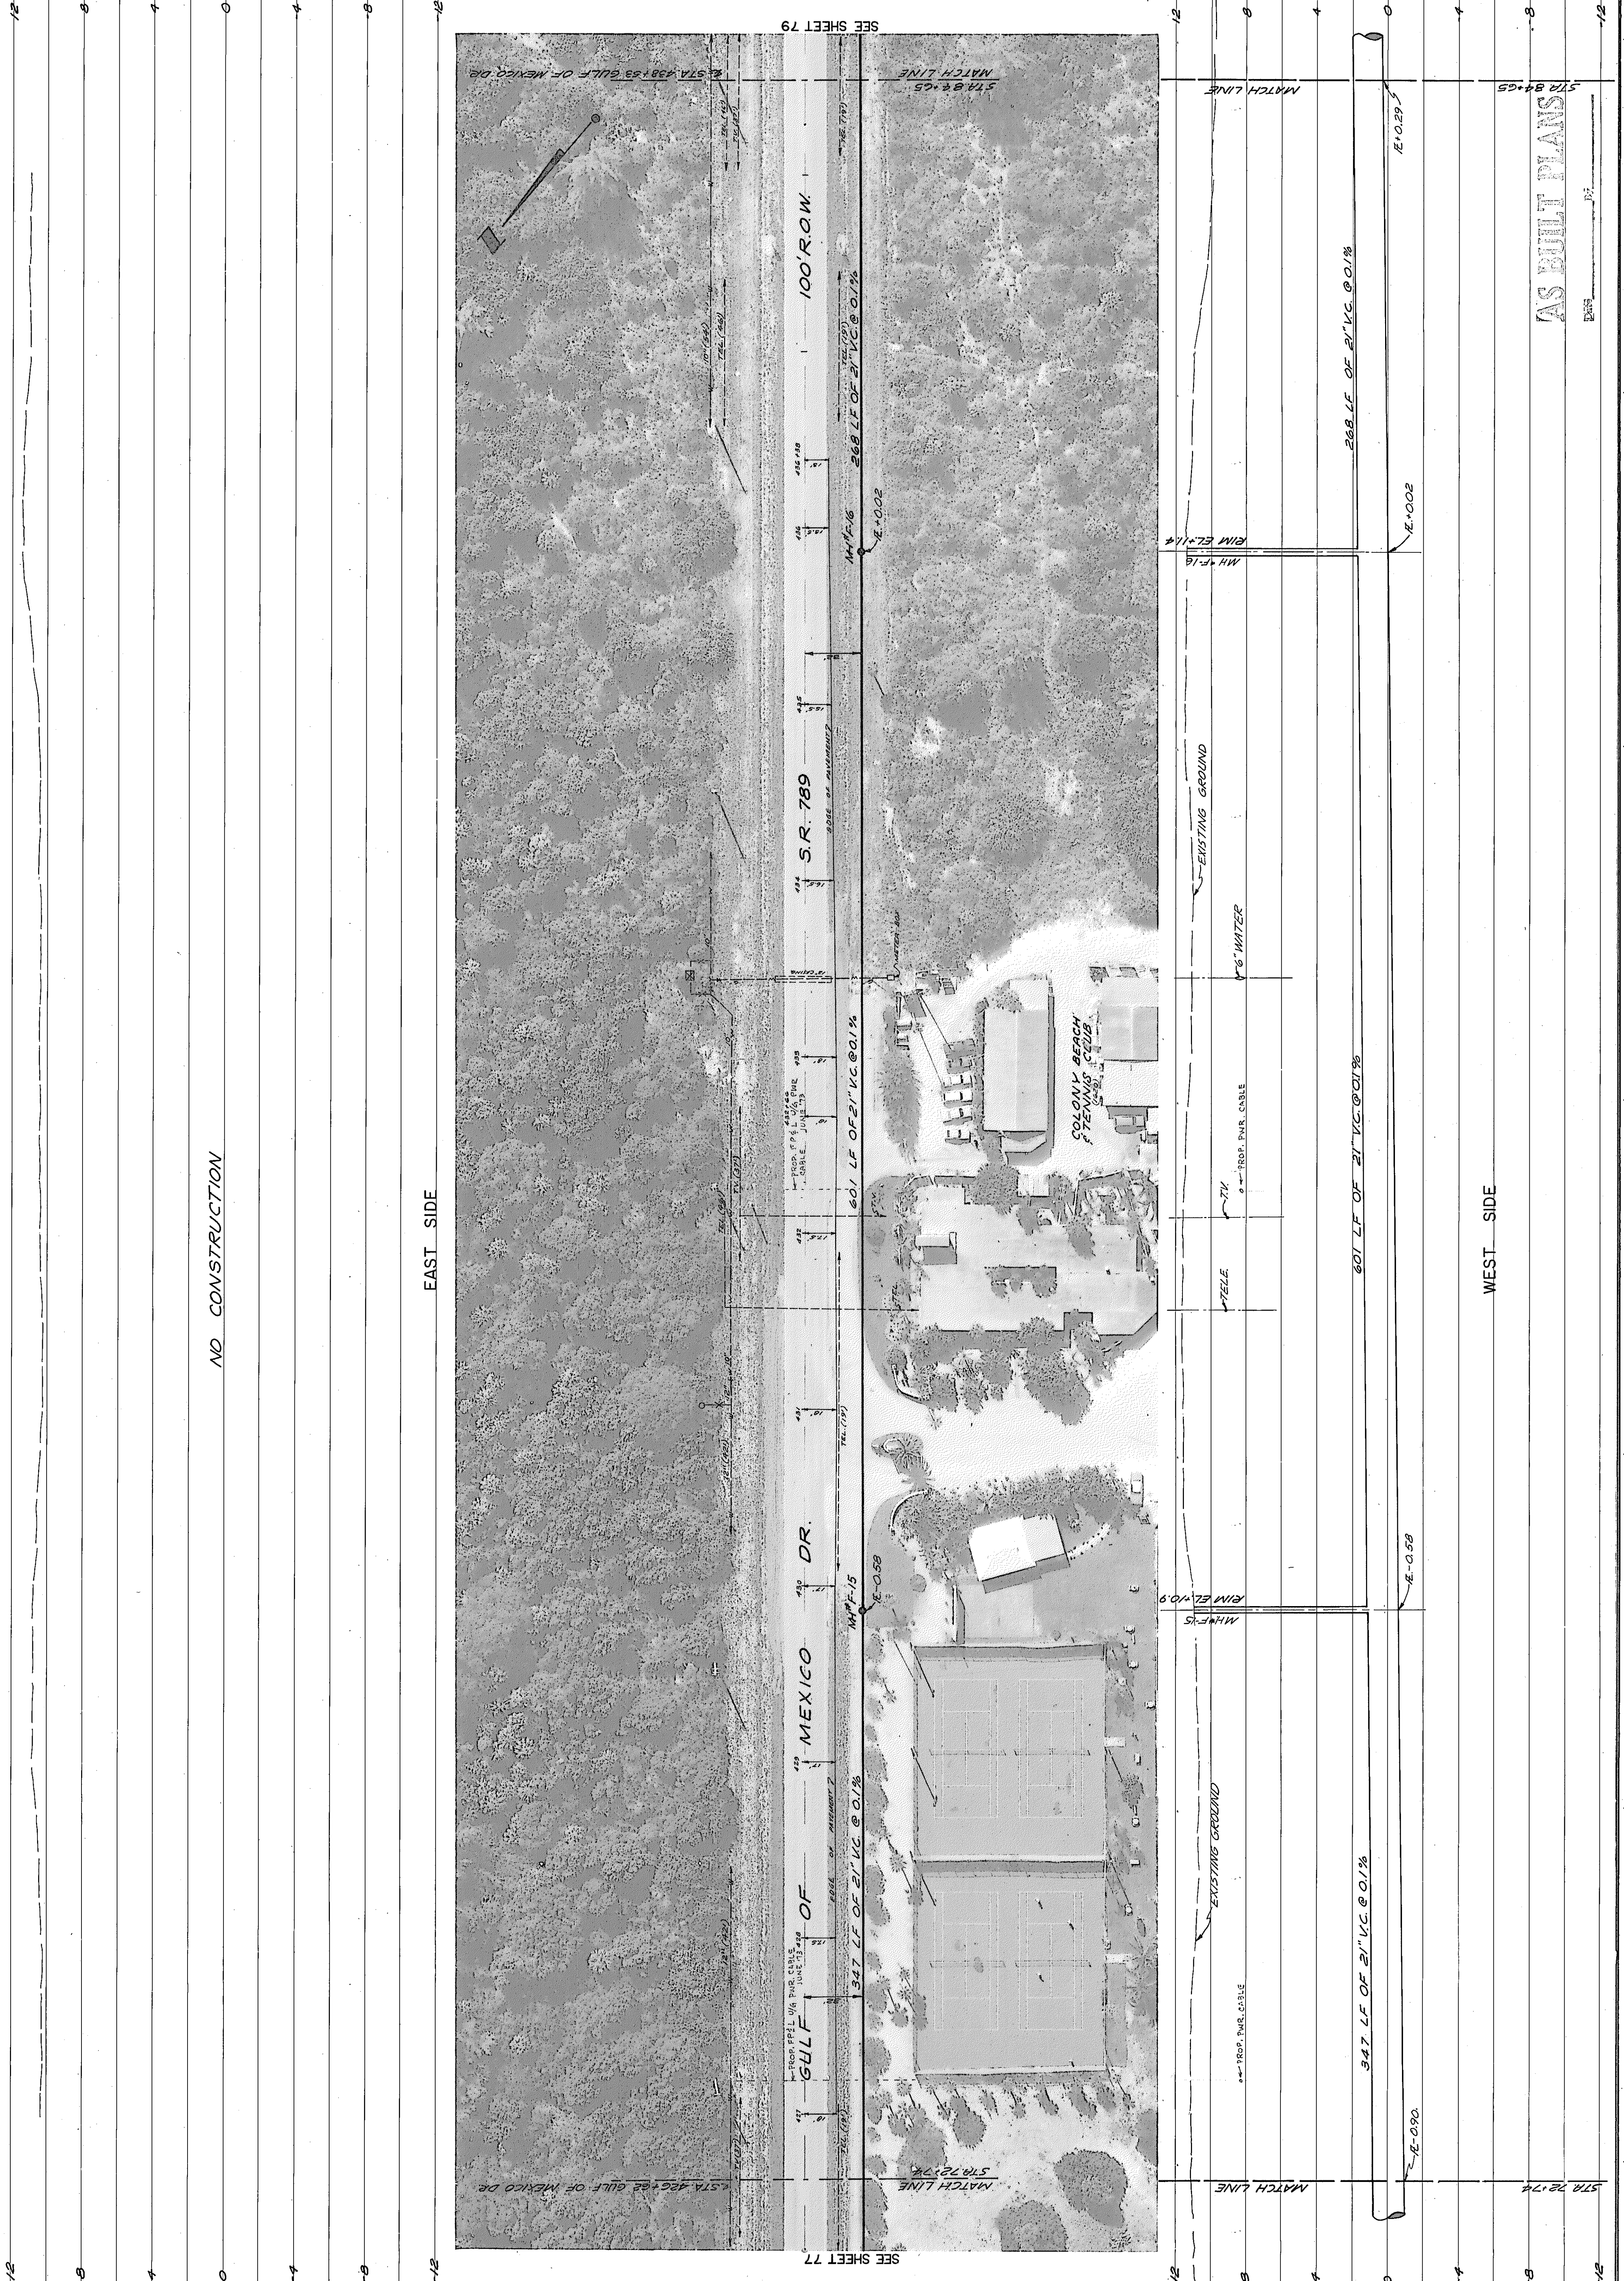

NO CONSTRUCTION

EAST SIDE

WEST SIDE

AS BUILT PLANS