


BIRDIE LANE, PUTTING GREEN LANE  
 WASTEWATER COLLECTION SYSTEM  
 TOWN OF LONGBOAT KEY, FLORIDA

FOR: DATE: 9-19-75	REVISION	RELOCATED SEWER ALIGNMENT & ADDED SEWERS
L.T.R. DATE: 9-19-75	BY: P.C.W.	SCALE: HORIZ. 1"=40'
DESIGNED BY: L.D.W. E.M.L.	CHECKED BY: J.C.C.	DRAWN BY: J.C.C.
APPROVED BY:	PROJECT NO. 1217-S	1 DAVID WEAVER, R.E.

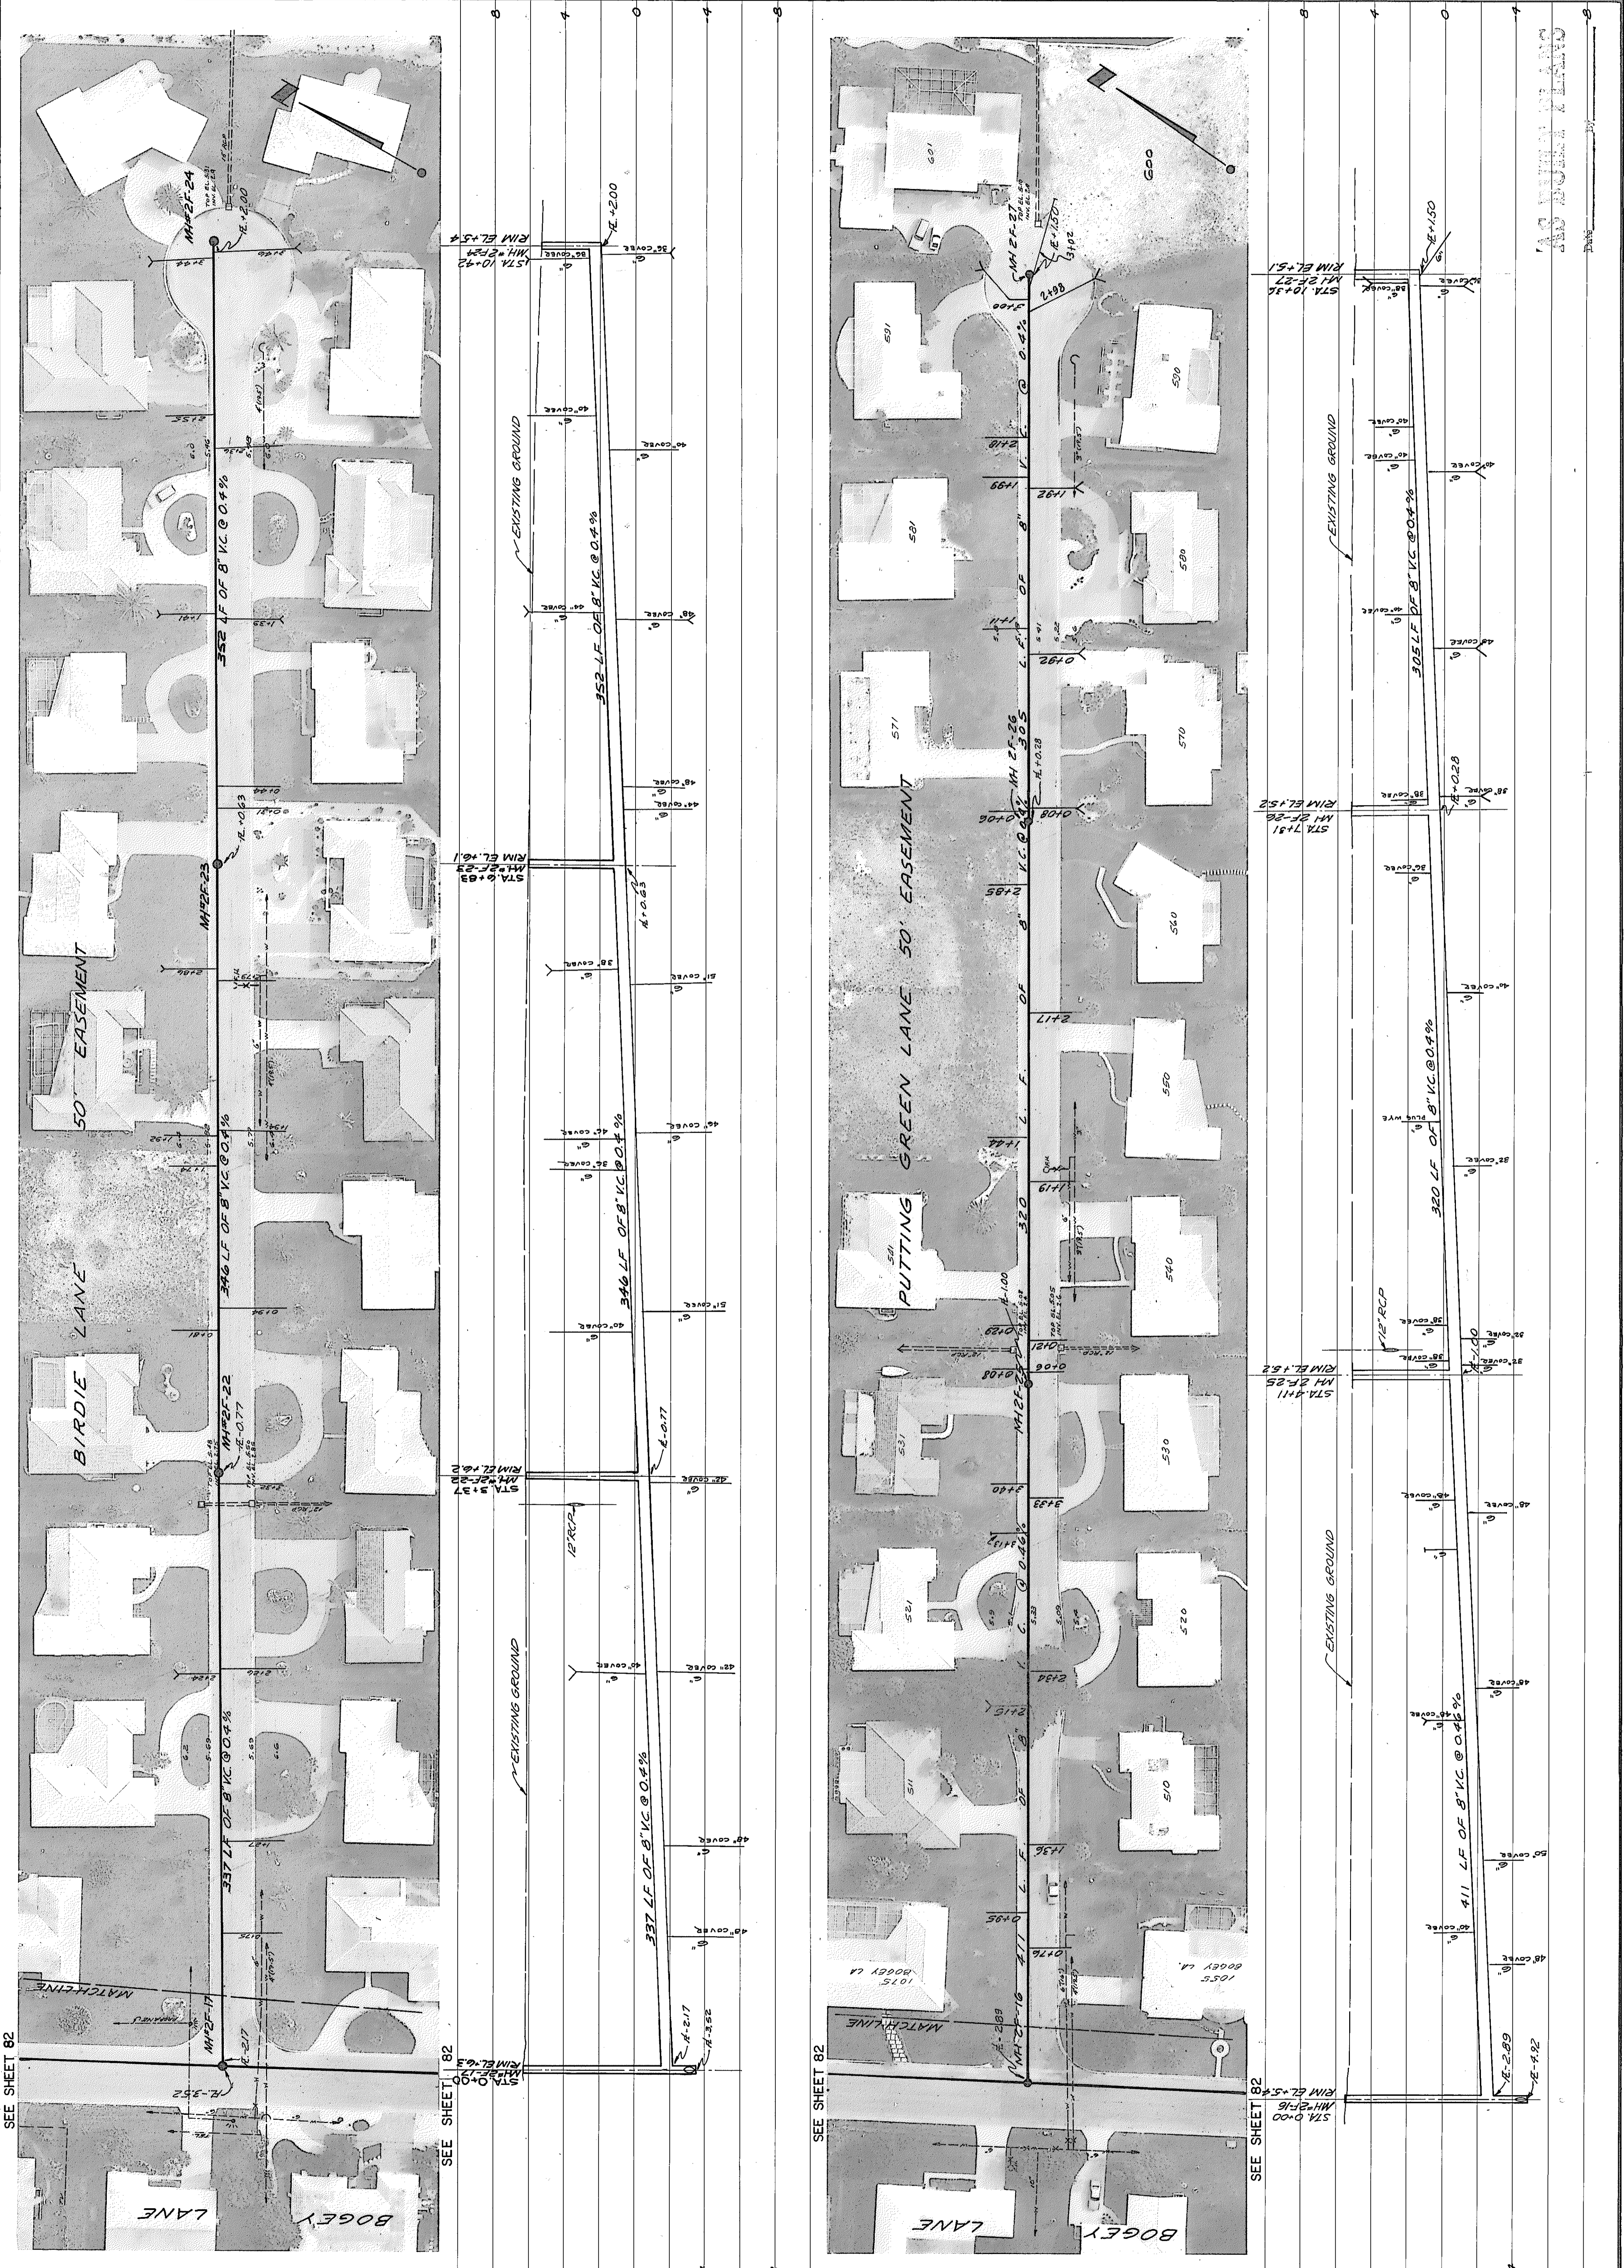

SEE SHEET 82

SEE SHEET 82

SEE SHEET 82

SEE SHEET 82