


SMALLY, WELLFORD & NALVEN - CONSULTING ENGINEERS - SARASOTA, FLORIDA
 WASTEWATER COLLECTION SYSTEM
 E. M-G-3 TO M-G-5
 GULF OF MEXICO DRIVE
 TOWN OF LONGBOAT KEY, FLORIDA

FOR: DATE: AS BUILT: LTR. DATE: REVISION: BY: SCALE: 1"=40'
 HORIZ. 1"=40' VERT. 1"=4'
 DATE: 4-13-73
 DESIGNED BY: J.D.M., E.M.K., L.O.L.
 CHECKED BY: P.C.M.
 DRAWN BY: U.G./M.W.
 PROJECT NO.: 1217-S
 APPROVED BY: PHOTO: ROSSWORTH AERIAL SURVEYS SEPT. 1972

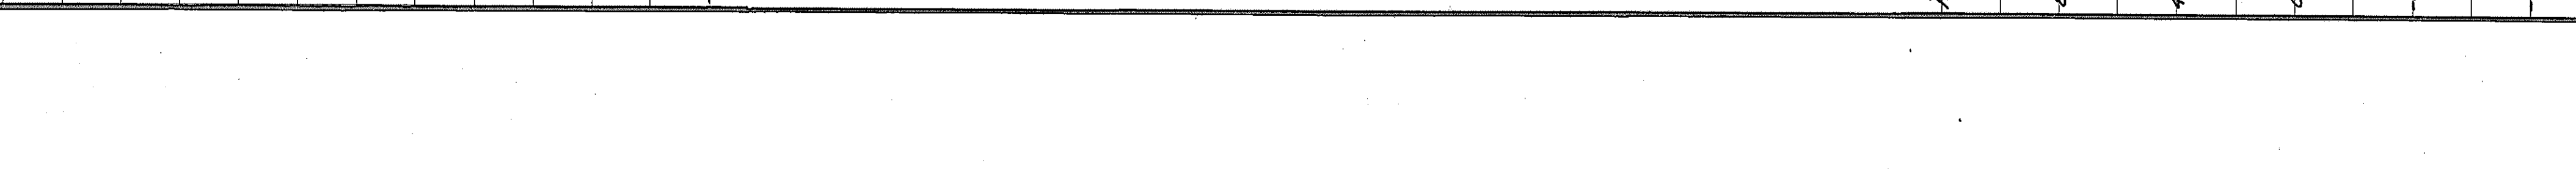

NO CONSTRUCTION

WEST SIDE

EAST SIDE

AS BUILT PLANS