
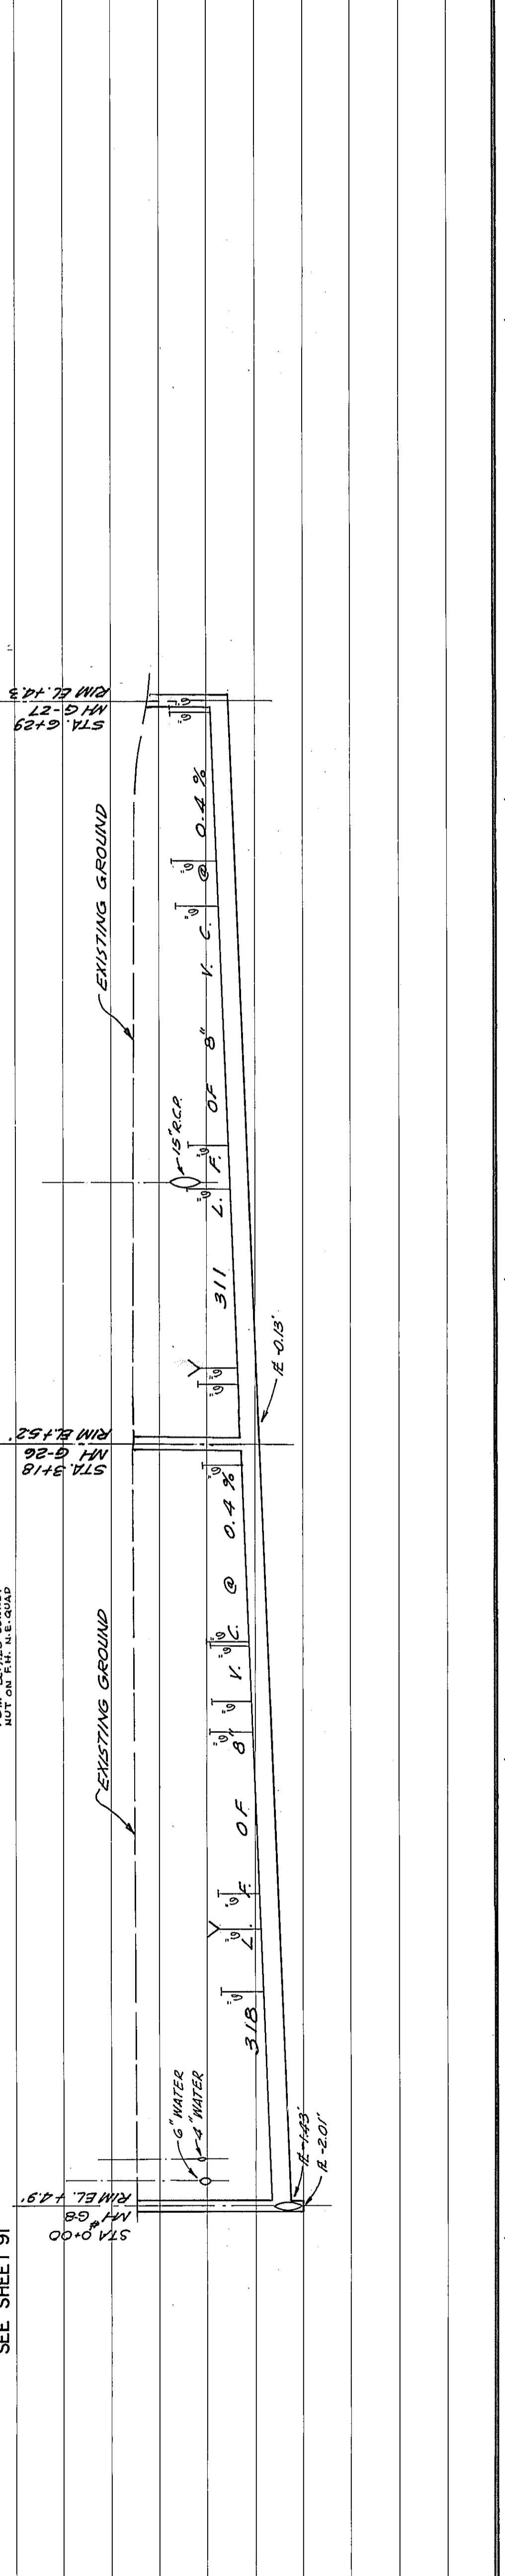
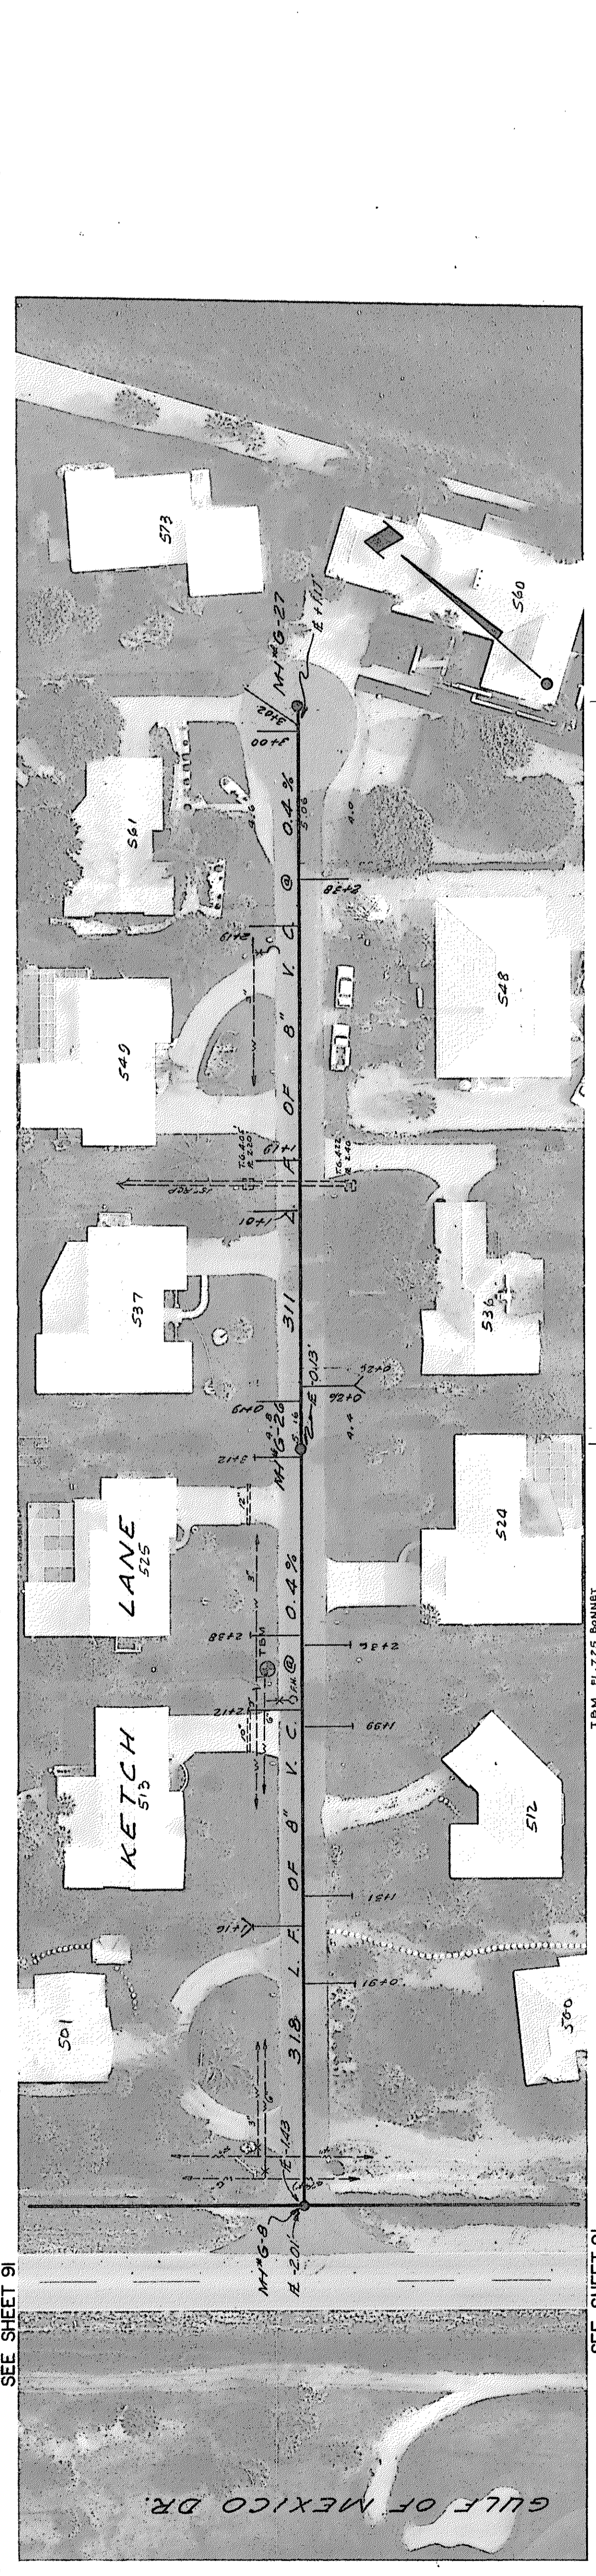
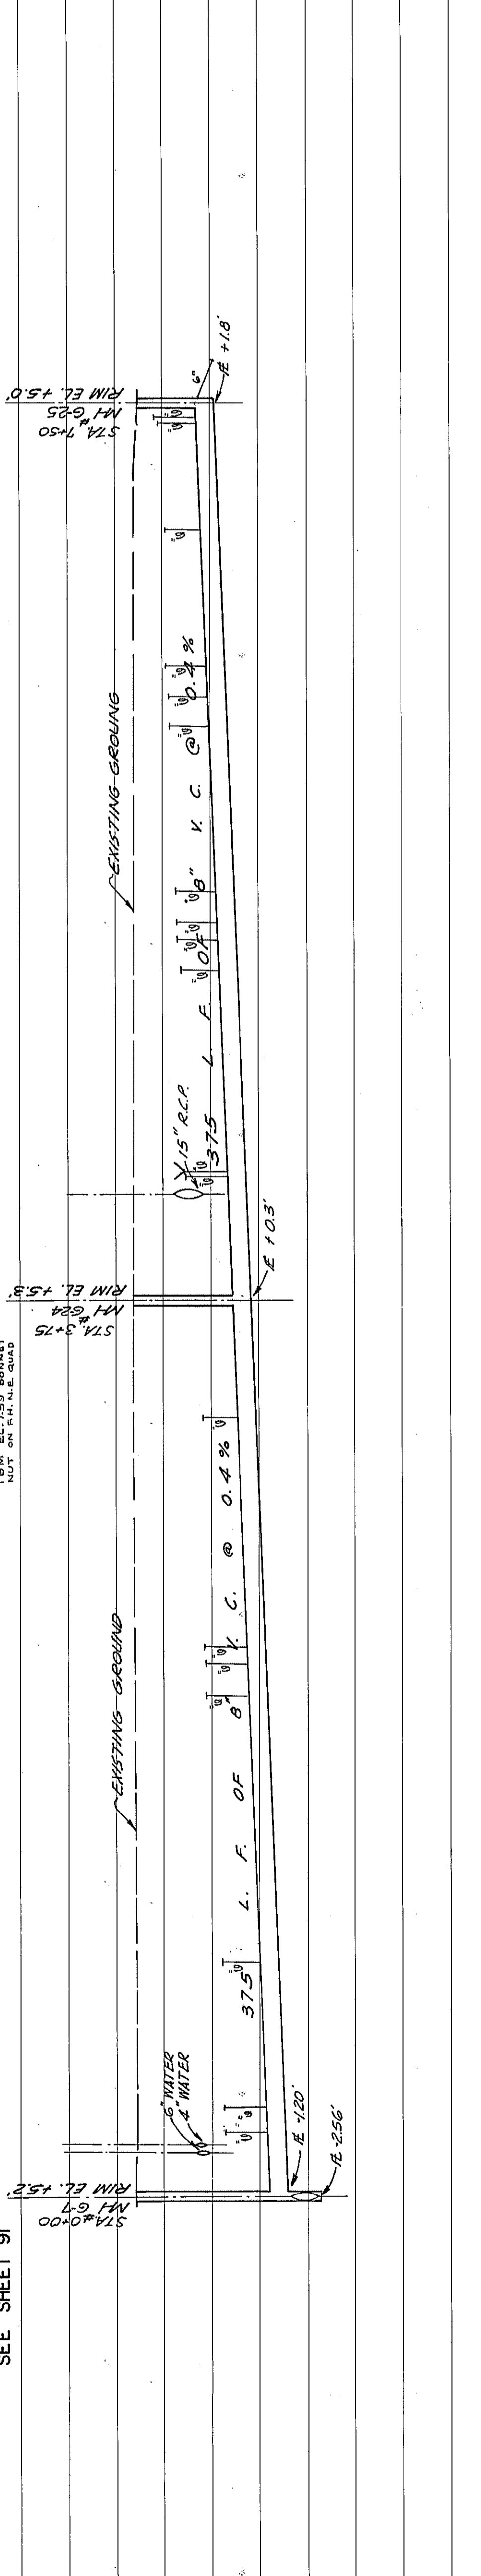


TOWN OF LONGBOAT KEY, FLORIDA  
 SCHOONER LANE, KETCH LANE  
 WASTEWATER COLLECTION SYSTEM

FOR: A	L.T.R. DATE	1/27/75	AS BUILT
BY: SCALE	HORIZ. 1"=40'	DATE: 4-13-73	DESIGNED BY: J.D.W., E.M.N.
APPROVED BY: J. DAVID WEAKE	PROJECT NO. 1217-S	CHECKED BY: U.G. MM	PHOTO: BOGARTH AERIAL SURVEY

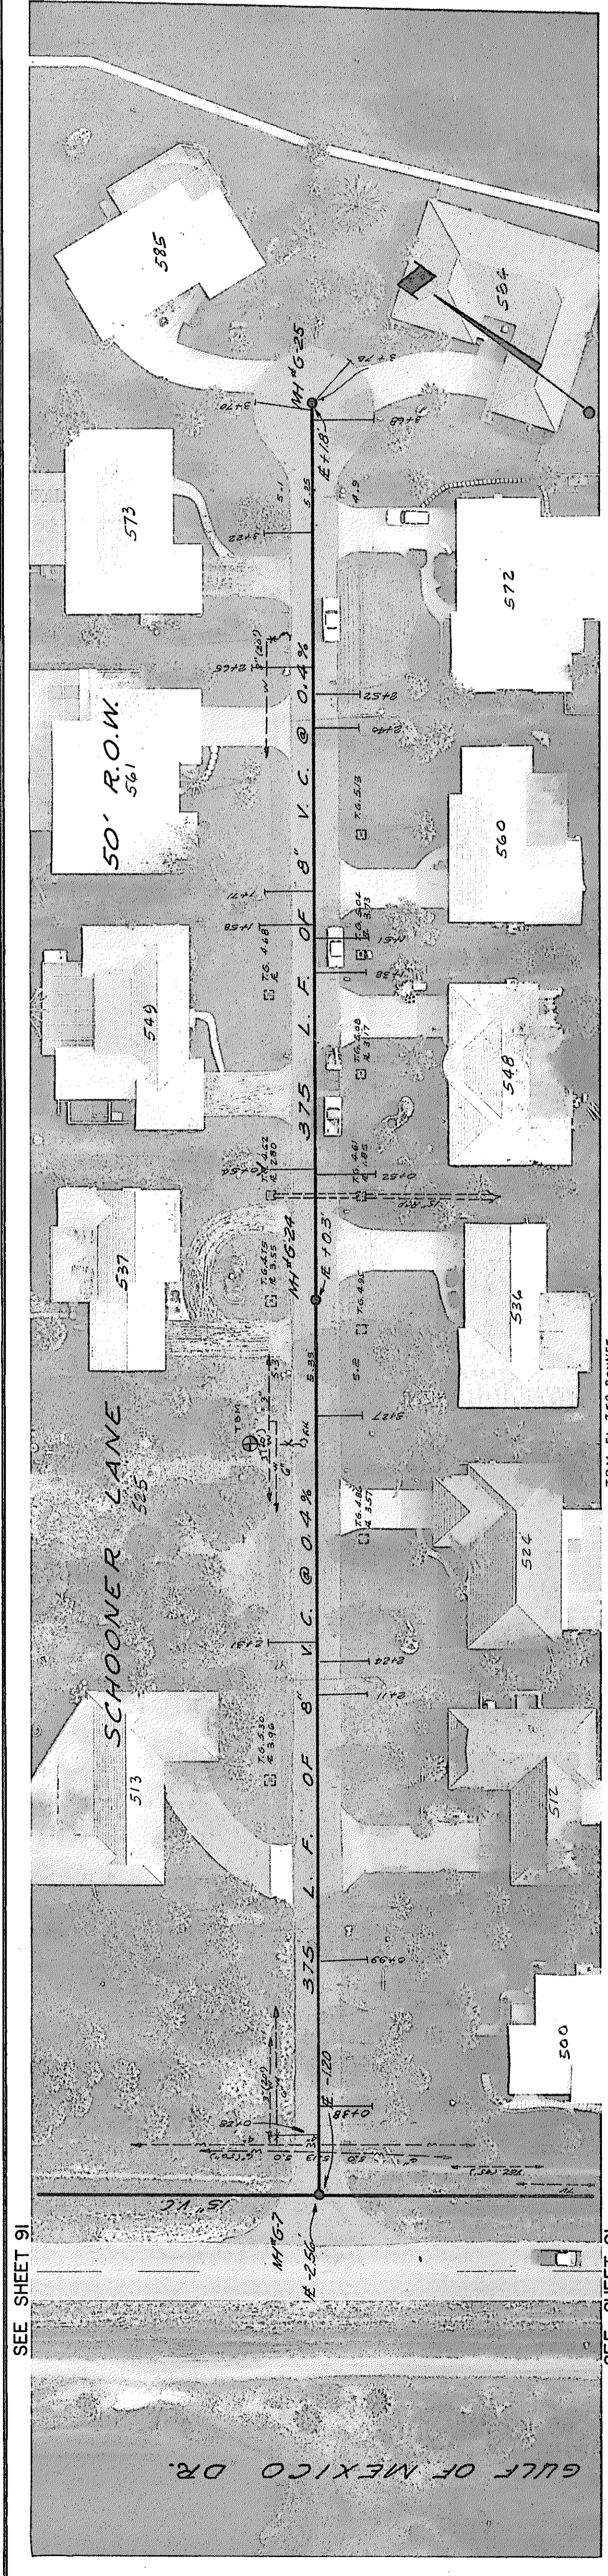

SEE SHEET 91

SEE SHEET 91

SEE SHEET 91

SEE SHEET 91

GULF OF MEXICO DR.

GULF OF MEXICO DR.