
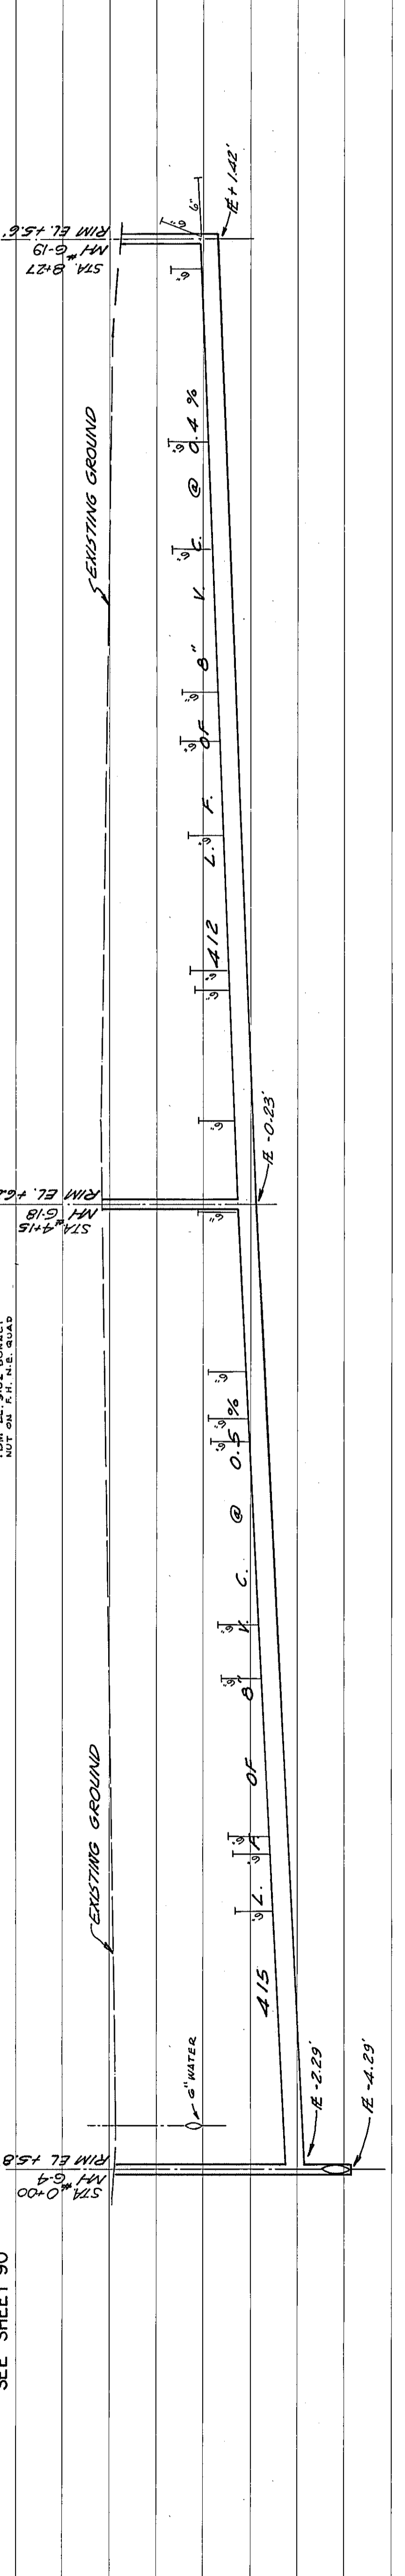
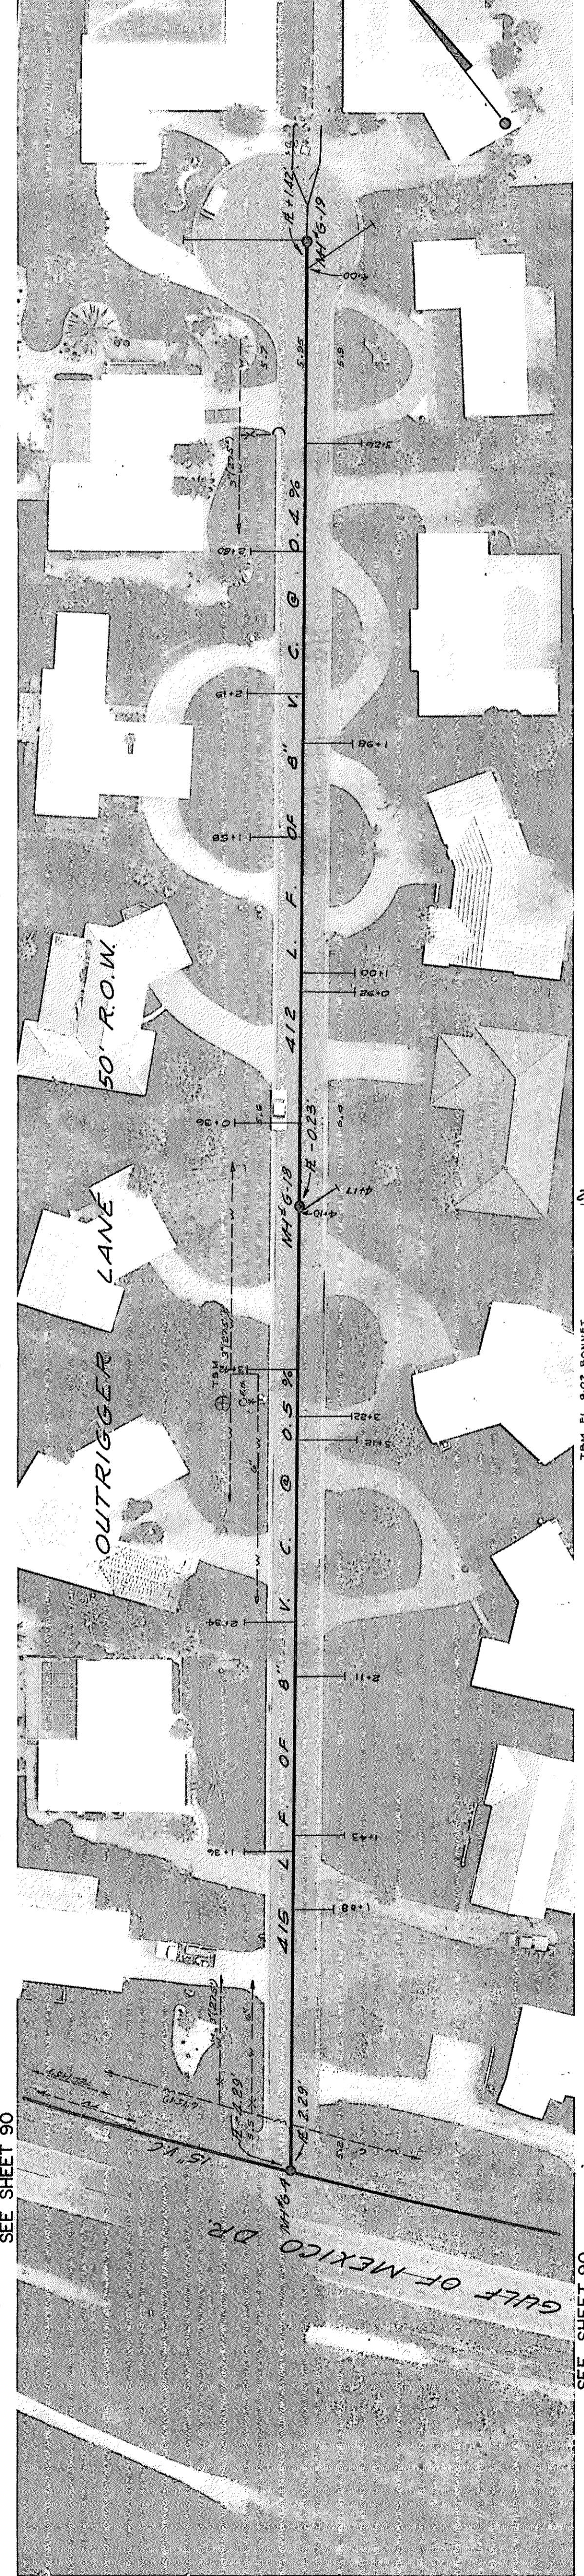
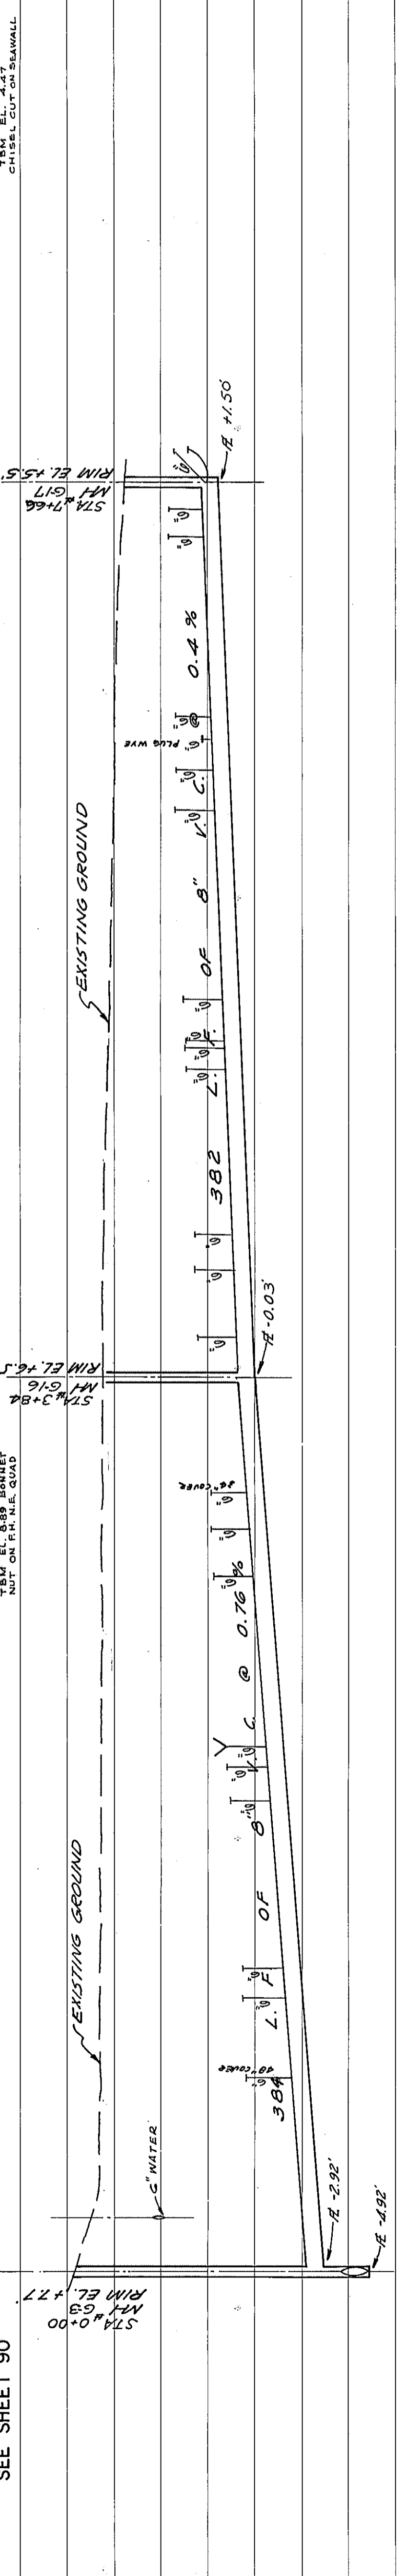


DESIGNED BY JDM, EWN SEPT. 1972	CHECKED BY JCS, MMK 7.0.7	PROJECT NO. 1217-S	DATE 4-13-73	SCALE HORIZ. 1"=40' VERT. 1"=4'	BY P.C.W.	REVISION	L.T.R. DATE	AS BUILT
---------------------------------------	---------------------------------	-----------------------	-----------------	---------------------------------------	--------------	----------	-------------	----------

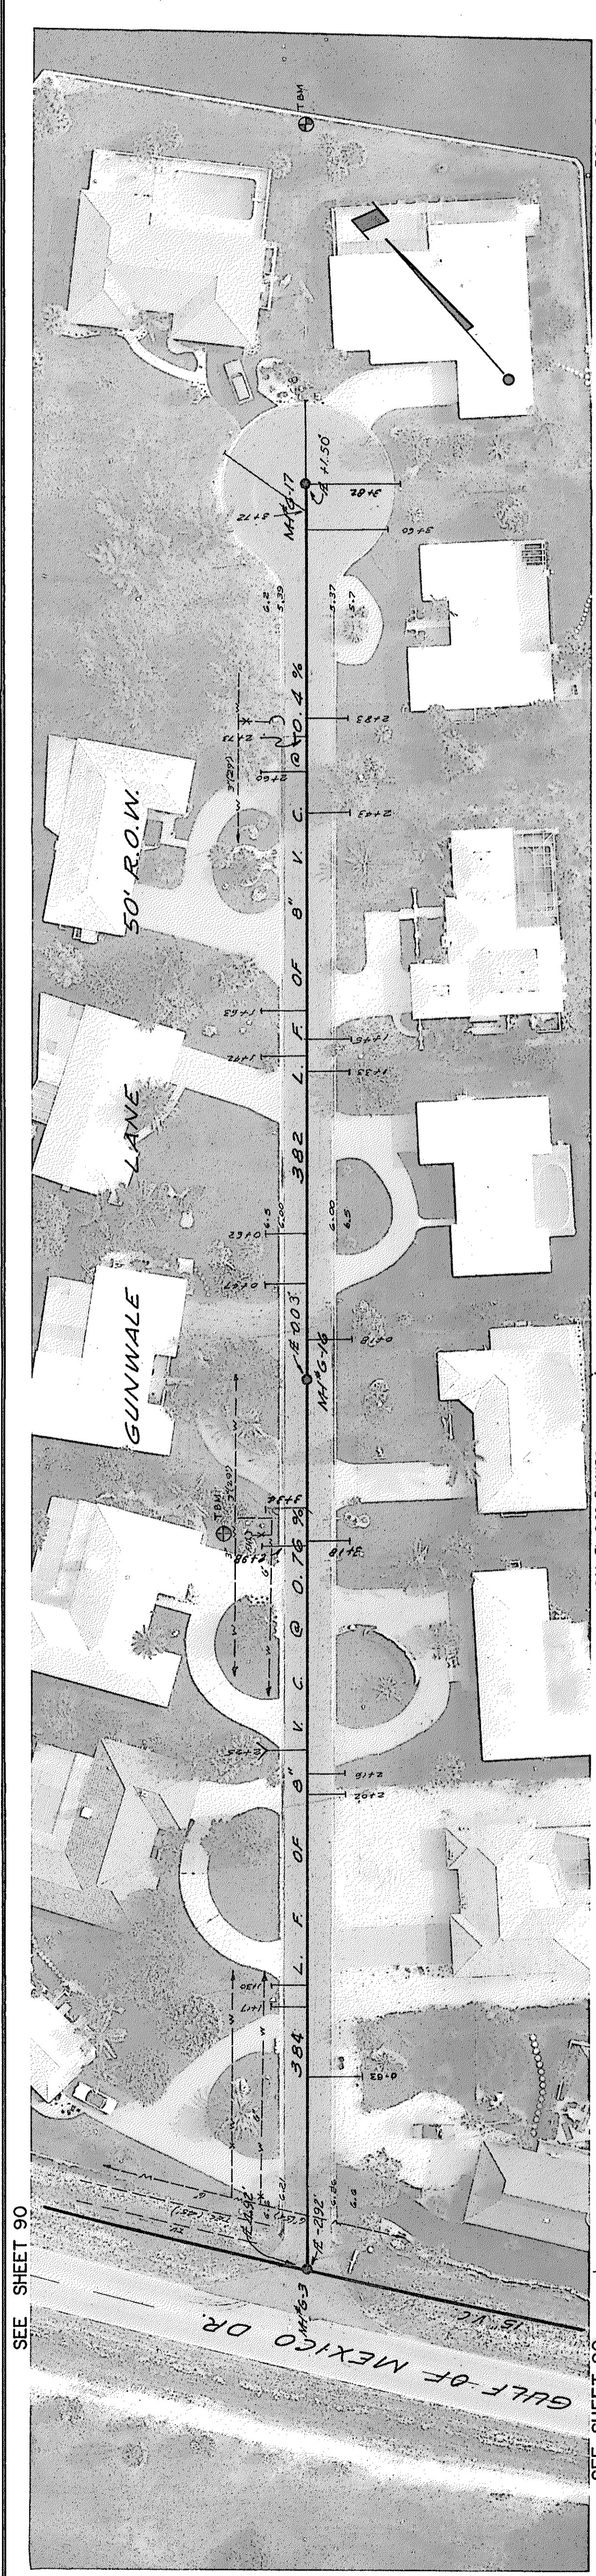

AS BUILT PLANS

Date: _____ By: _____

SEE SHEET 90

SEE SHEET 90

SEE SHEET 90

SEE SHEET 90