


RECORD DRAWING

THIS RECORD DRAWING IS NOT WARRANTED BUT IS BELIEVED REPRESENT CONDITIONS UPON COMPLETION OF CONSTRUCTION WITHIN REASONABLE TOLERANCES, BASED UPON THE INFORMATION FURNISHED TO THE ENGINEER PERTAINING TO CHANGES MADE DURING CONSTRUCTION.

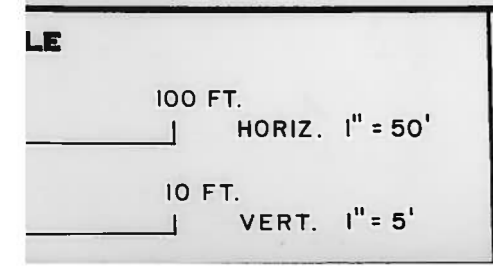

TOWN OF LONGBOAT KEY, FLORIDA
 IMPROVEMENTS TO WATER SUPPLY SYSTEM
 LONGBOAT PASS WATER MAIN
 CROSSING REPLACEMENT

PLAN AND PROFILE
 STA. 12+09.0 TO STA. 23+98.9

PROJ. NO. 5230-100-00
 SHEET 3 OF
 DATE MARCH 1983 REV.