


SEE SHEET 50

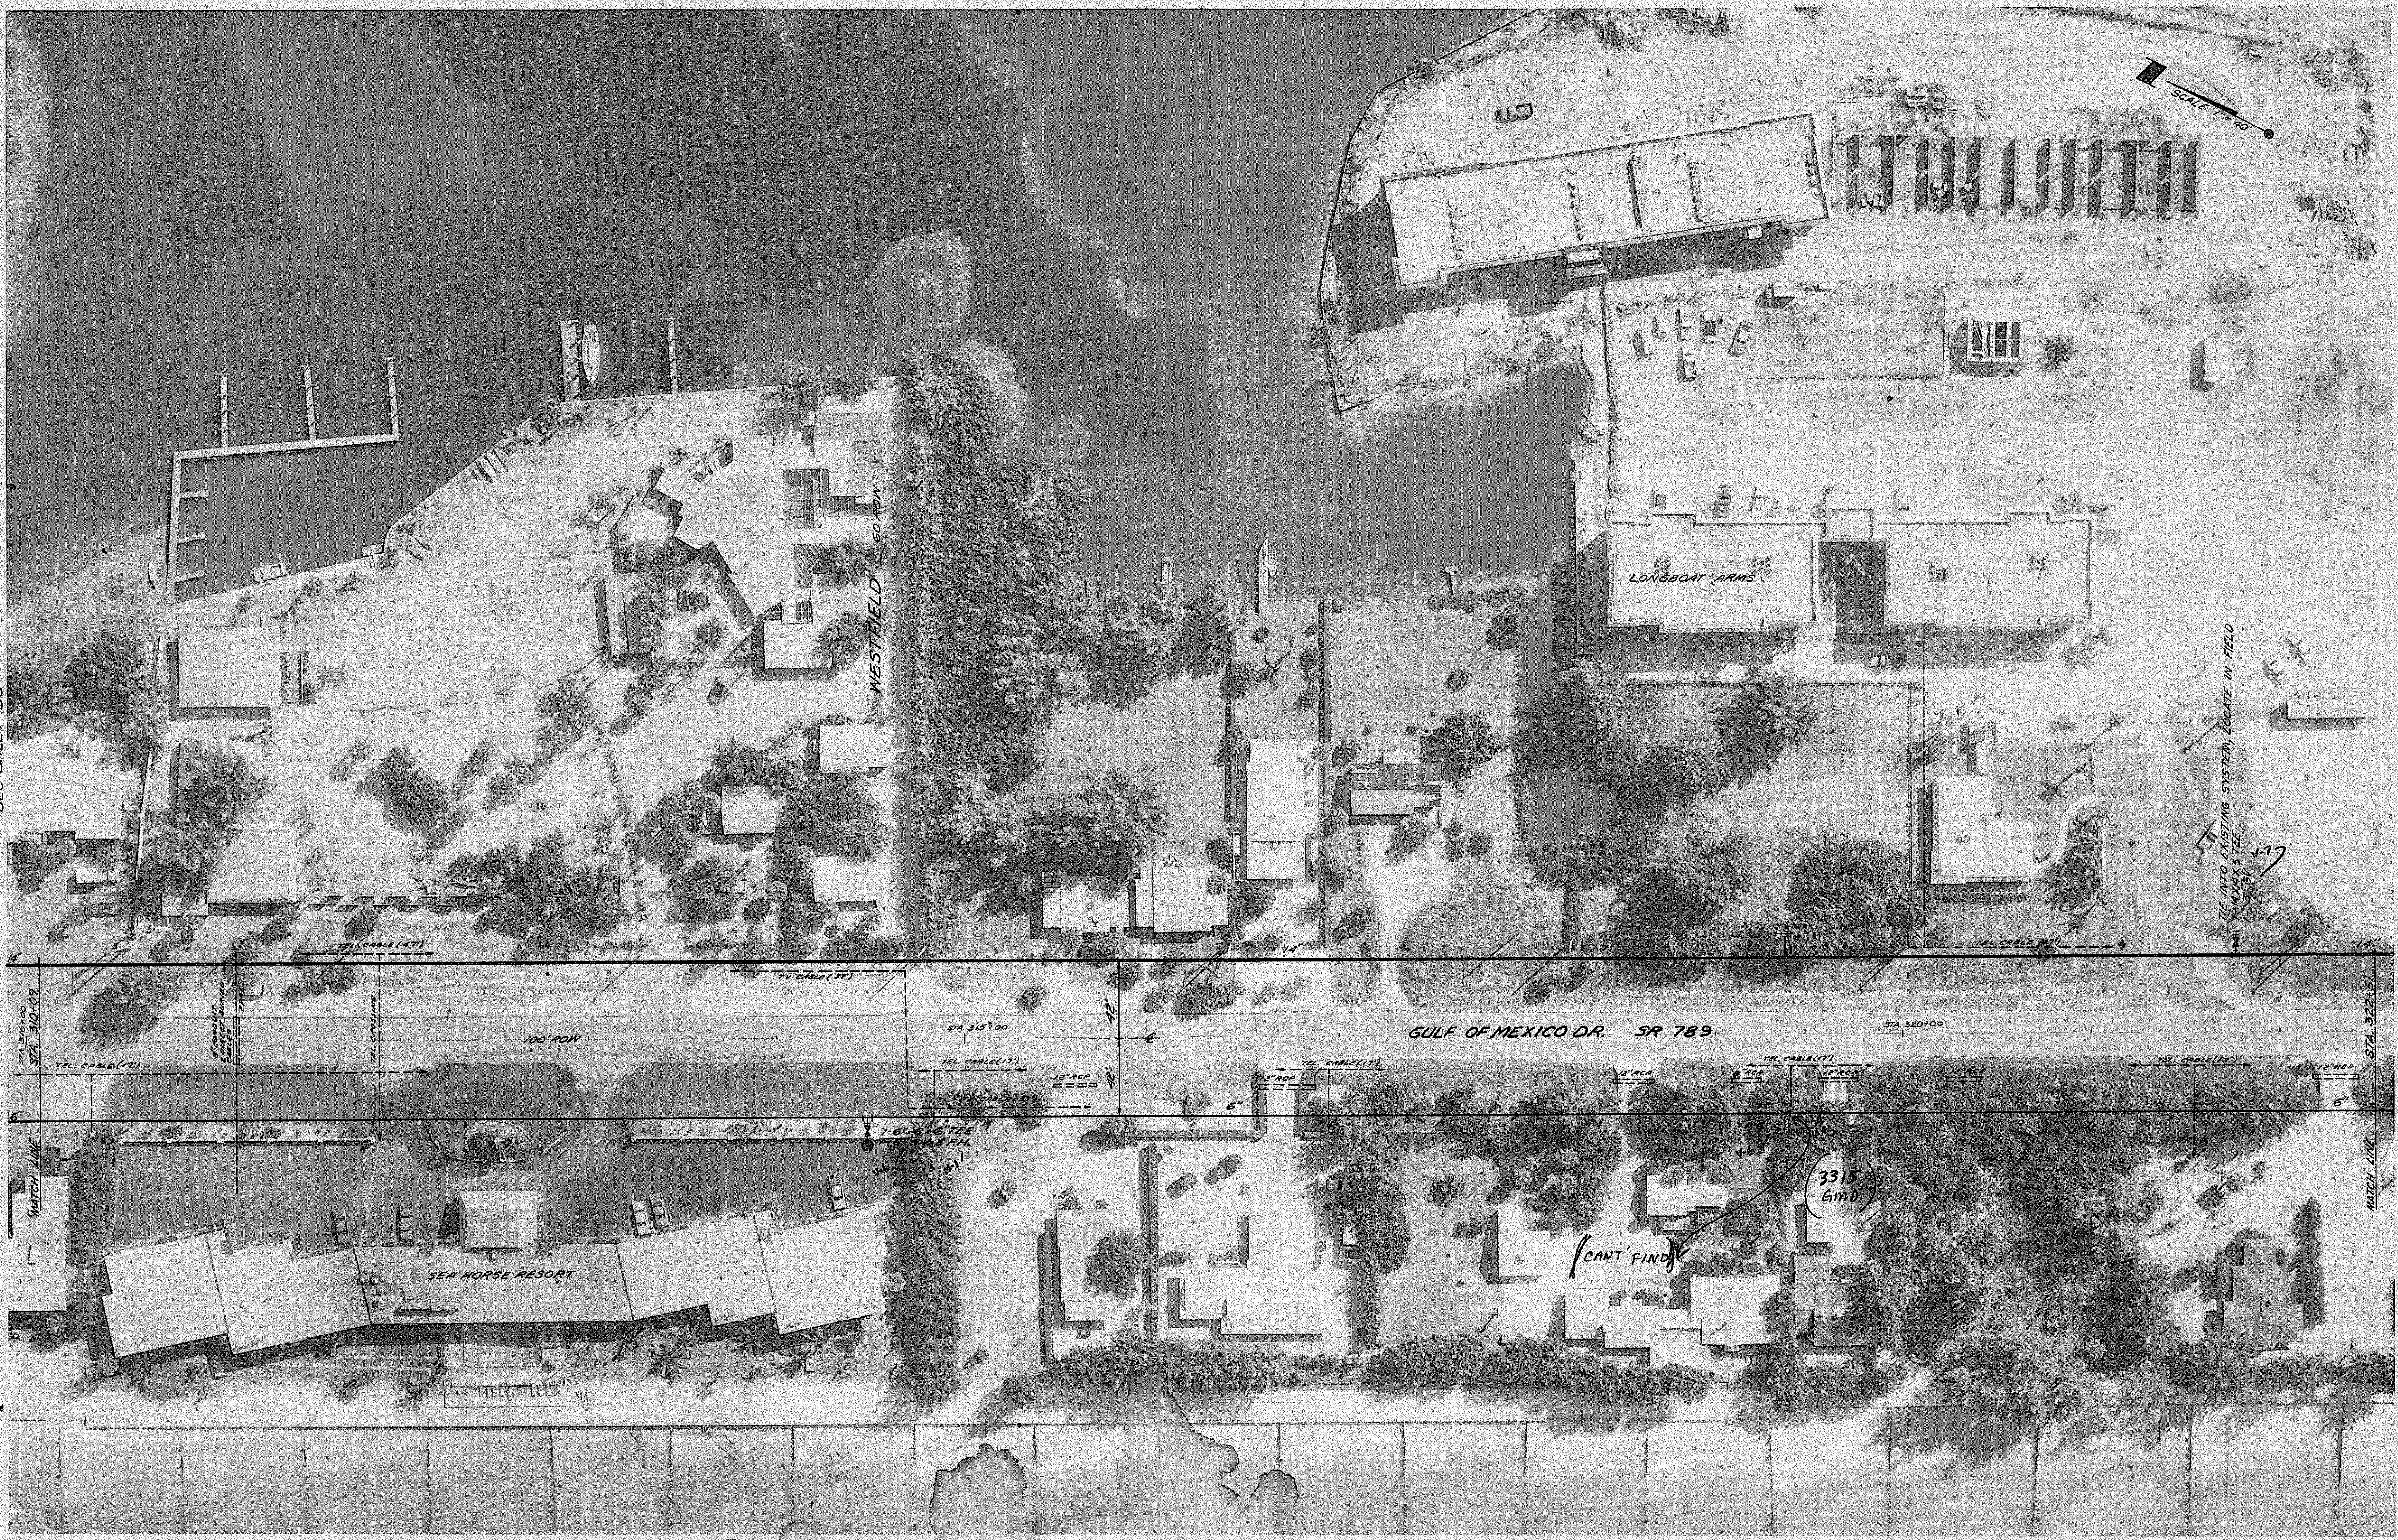

SCALE 1" = 40'

SEE SHEET 52

FOR: TOWN OF LONGBOAT KEY, FLORIDA	L.T.R. DATE	REVISION	BY	SCALE	DATES	DESIGNED BY	APPROVED BY	
WATER DISTRIBUTION SYSTEM LONGBOAT KEY, FLORIDA	"A" 12-14-70	ADDED 3" TEE AND VALVE	L.D.L.	1" = 40'	FLOW SEPT. 1970 12-10-70	E.W.N.	Manitell	
	SHEET NUMBER	51	REVISION	"A"	CHECKED BY	PROJECT NO.	MARION WELLFORD, P.E. FLA. CERT. NO. 5367	
SMALLY, WELLFORD & NALVEN - CONSULTING ENGINEERS - SARASOTA, FLA.							1217	

INDEX NO. E-1217-69