


SEE SHEET 58

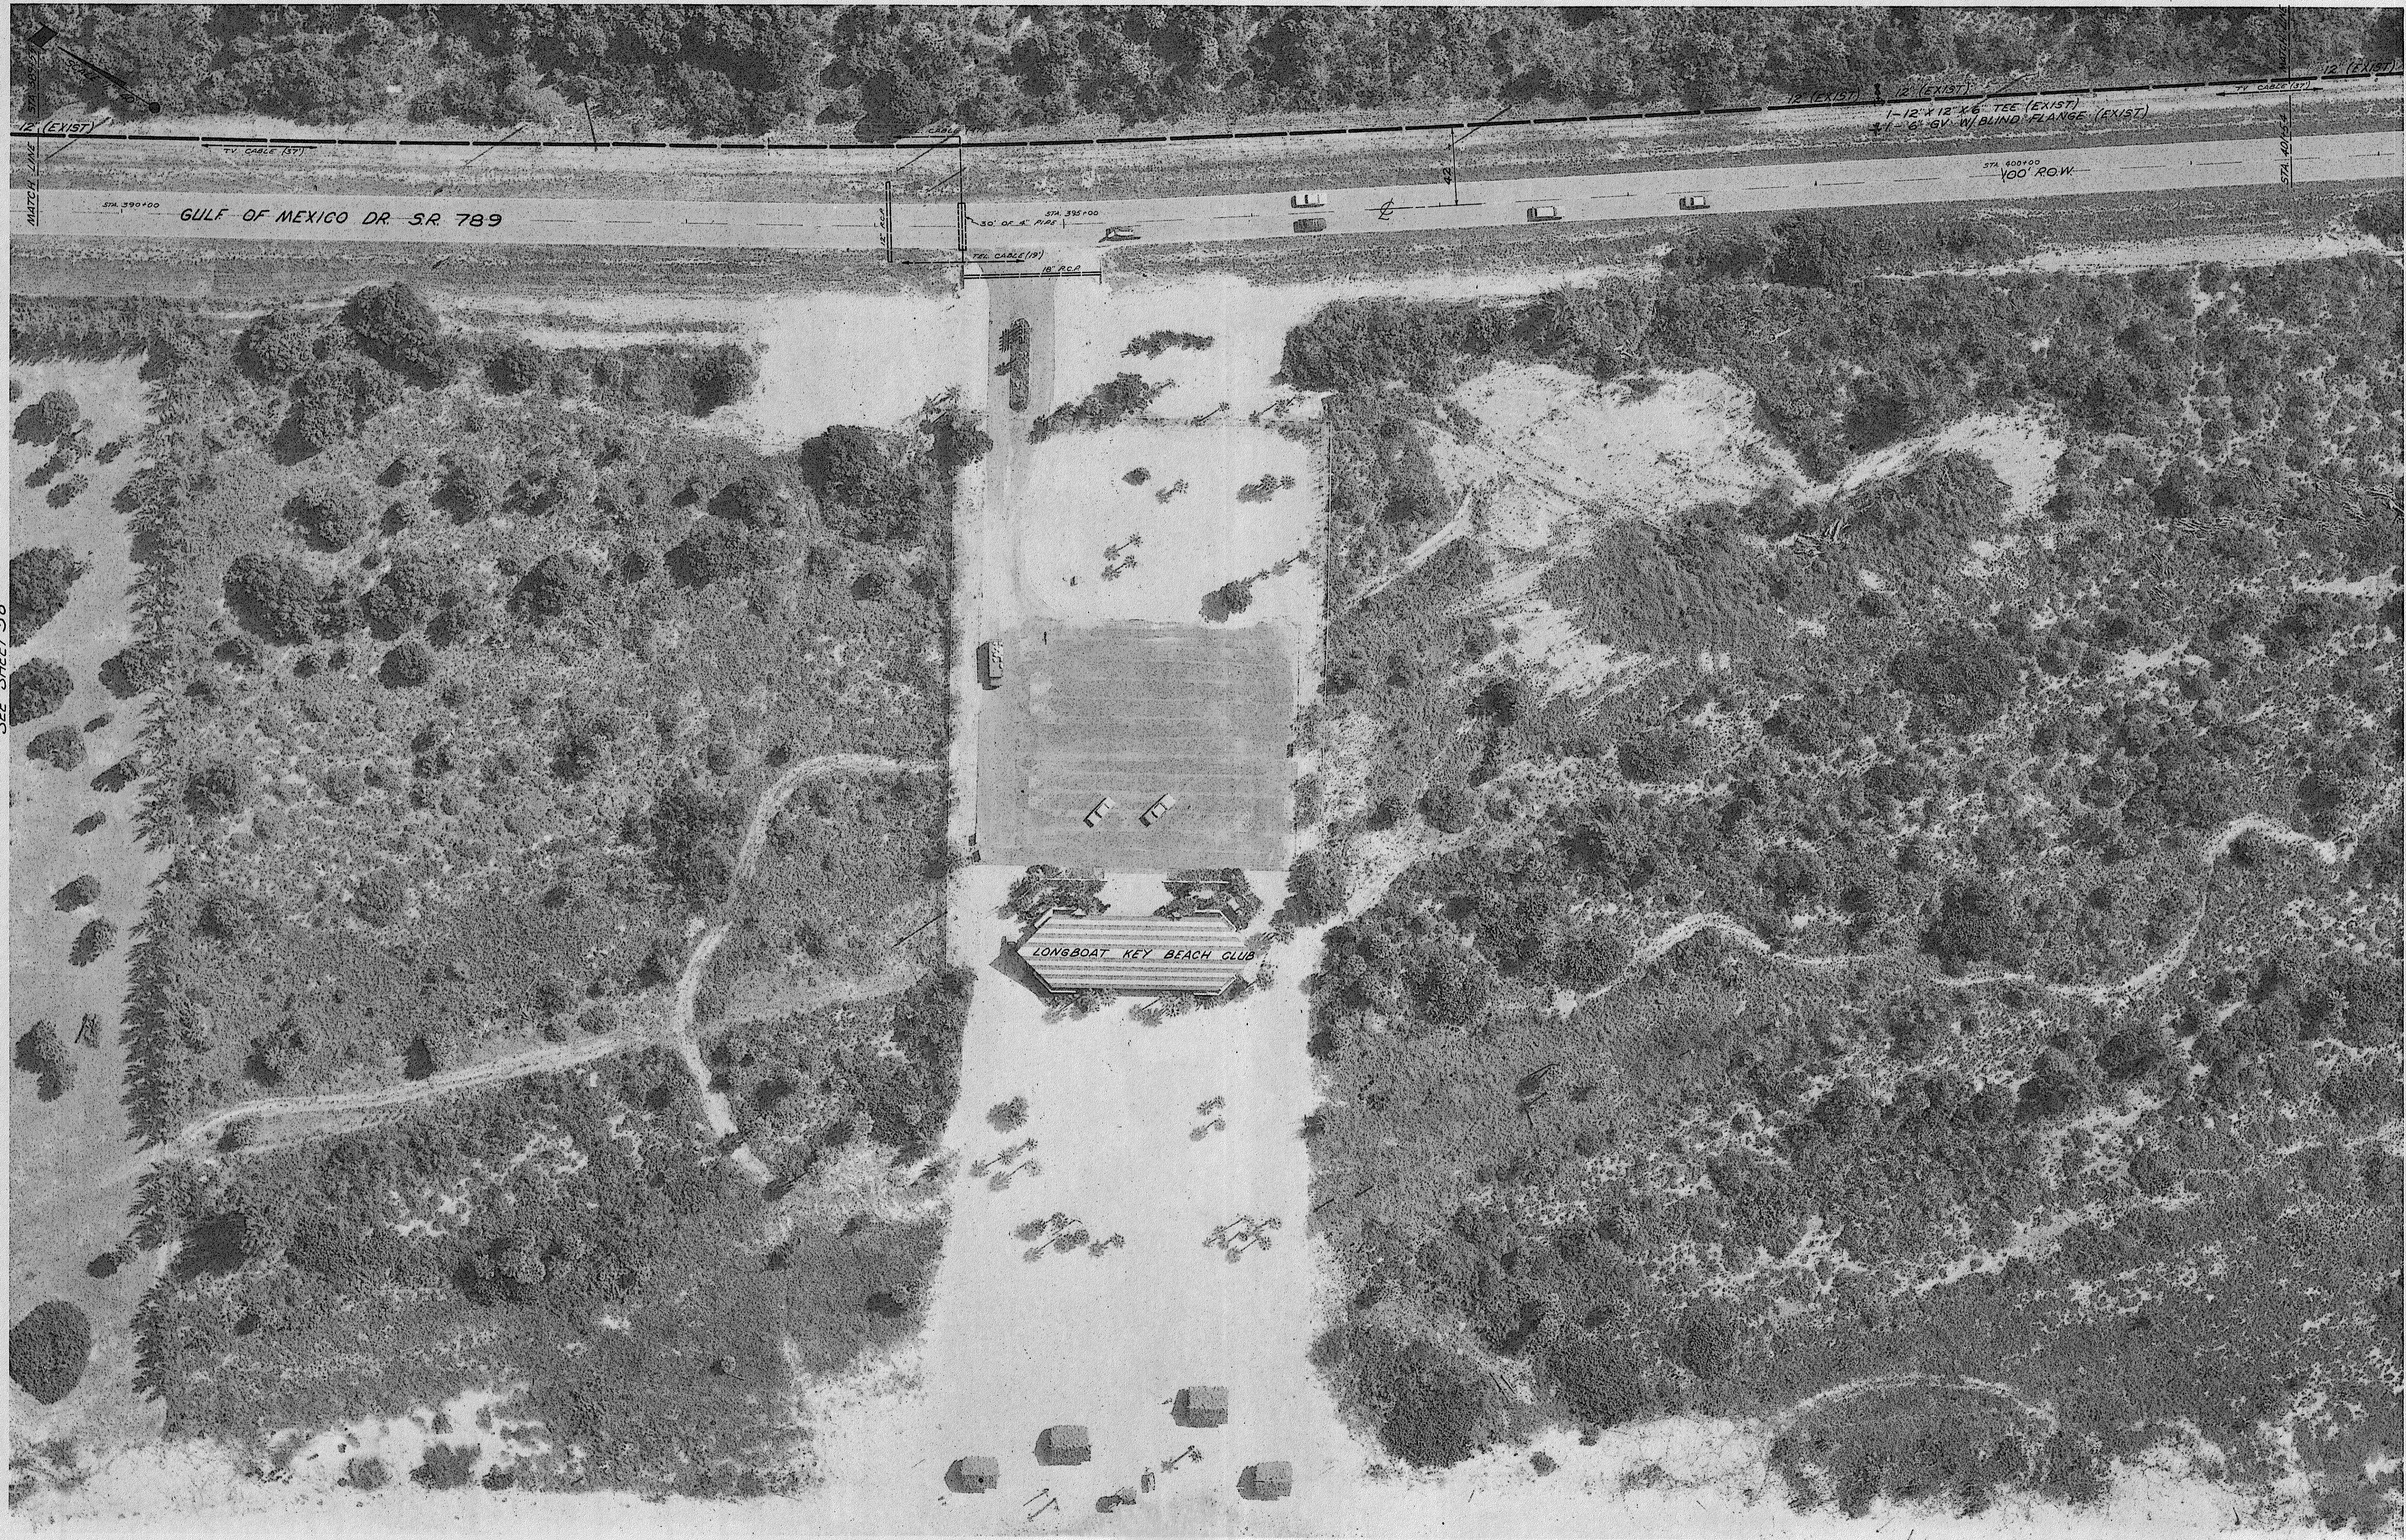

SEE SHEET 60

FOR: TOWN OF LONGBOAT KEY, FLORIDA	L.T.R. DATE	REVISION	BY	SCALE	DATES	DESIGNED BY	APPROVED BY:
WATER DISTRIBUTION SYSTEM LONGBOAT KEY, FLORIDA	1/11/12	ADDED EXISTING 12" G.I.	L.D.L.	1" = 40'	FLOWY SECT. 8, 1870 12-10-79	E.W.N.	<i>Marion Wellford</i>
						CHECKED BY	PROJECT NO.
							1217
							MARION WELLFORD, PE FLA. CERT. NO. 5367
SMALLY · WELLFORD & NALVEN — CONSULTING ENGINEERS — SARASOTA, FLA.							
SHEET NUMBER	INDEX NO. E-1217-77						
59							
REVISION							
1/11							