




TAP #7 DETAIL
SEE SHEET C-105
FOR TAP LOCATION

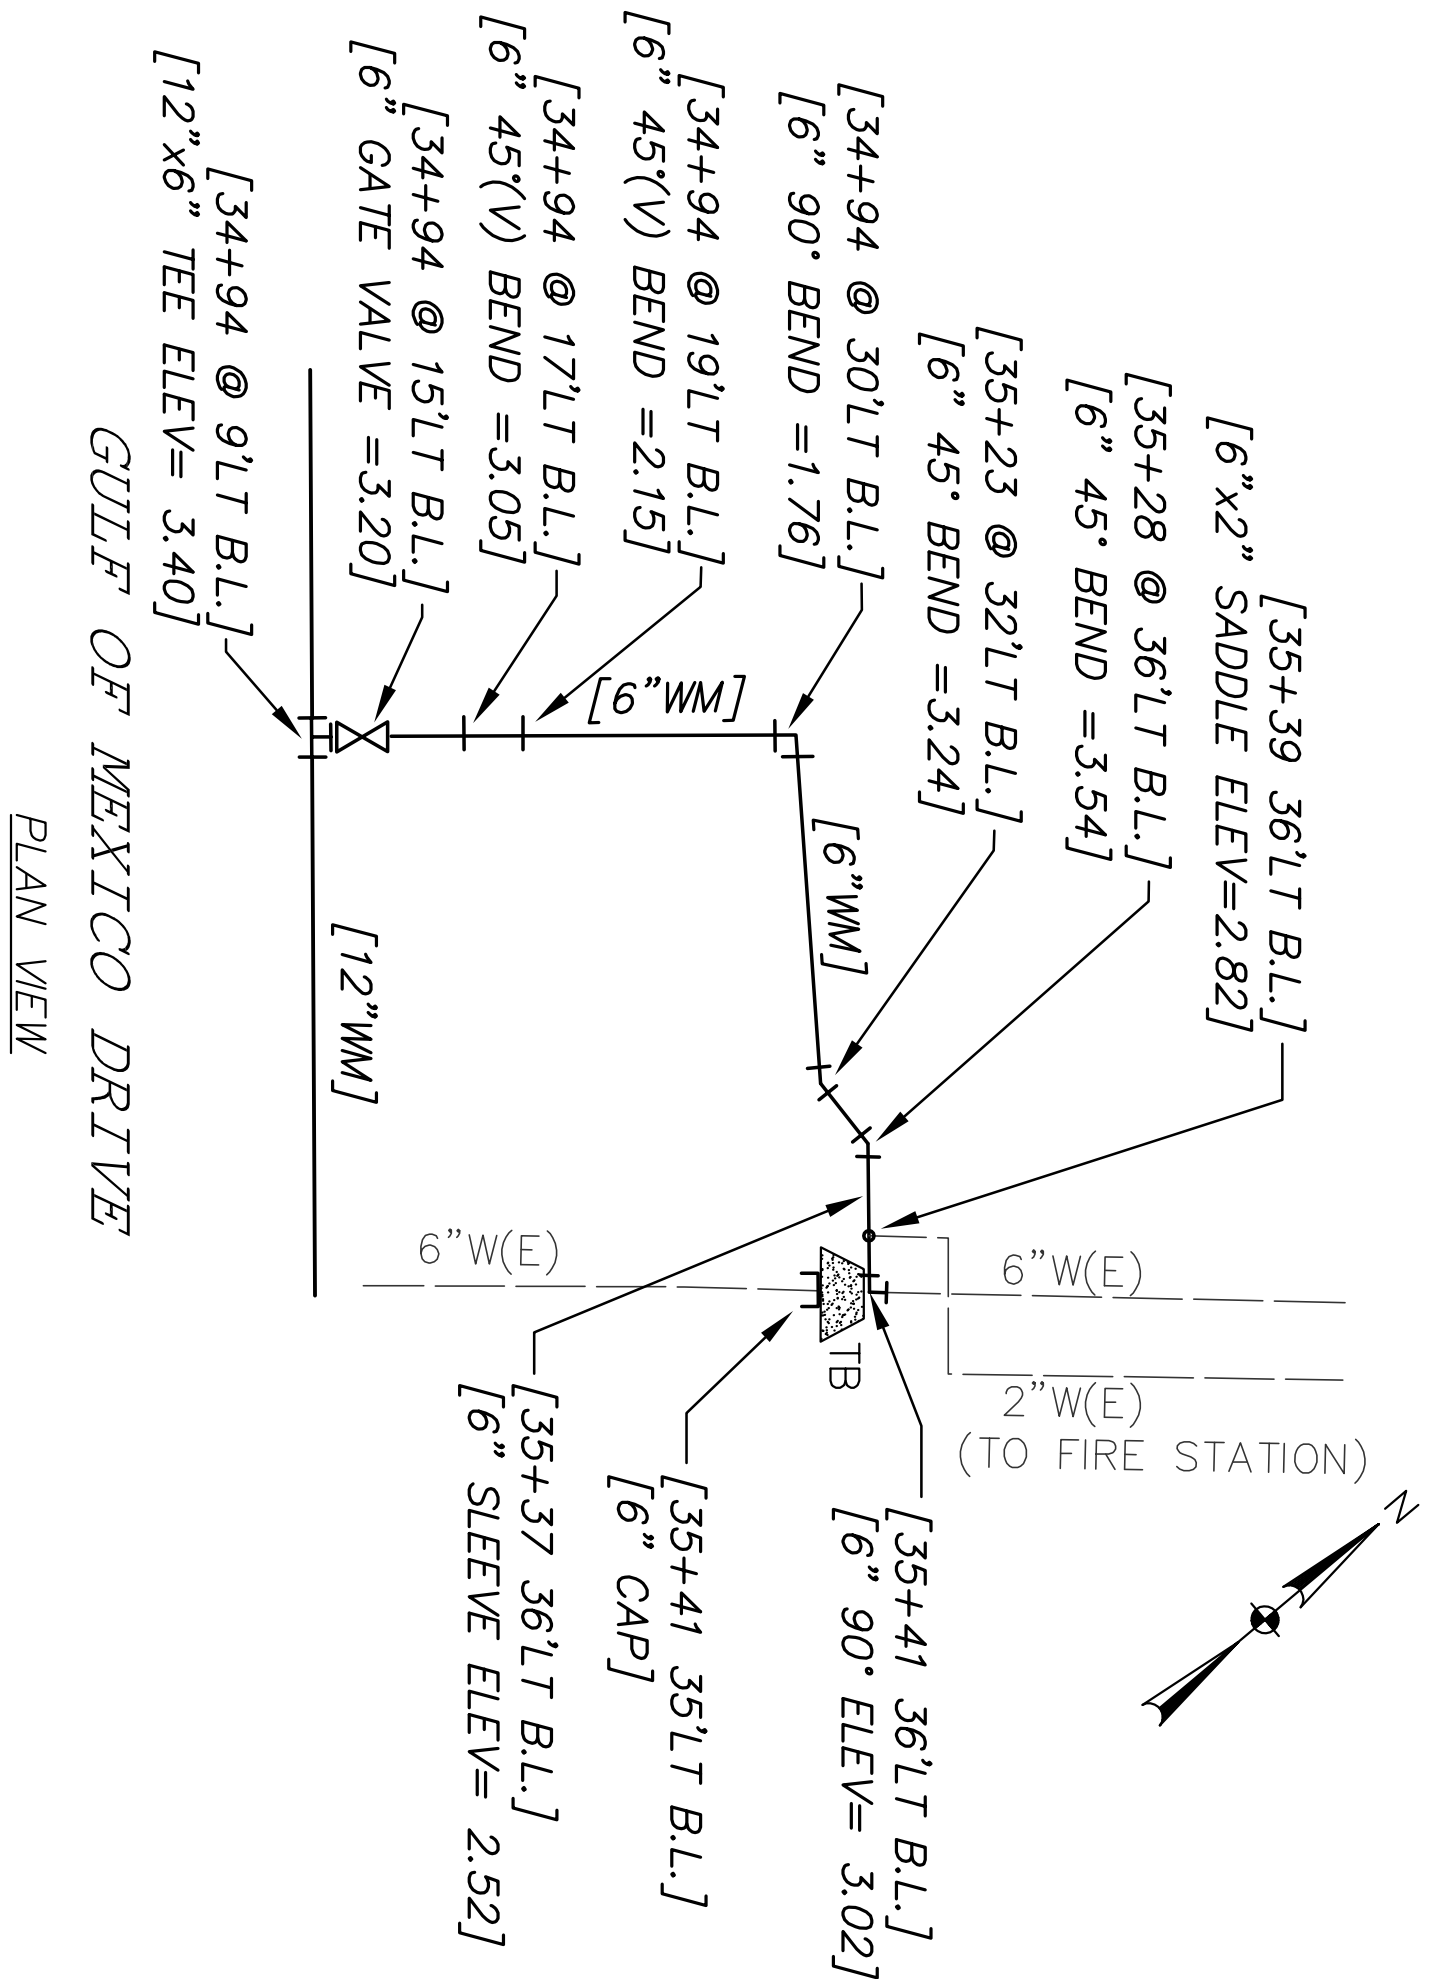


TAP #10 DETAIL
SEE SHEET C-106
FOR TAP LOCATION

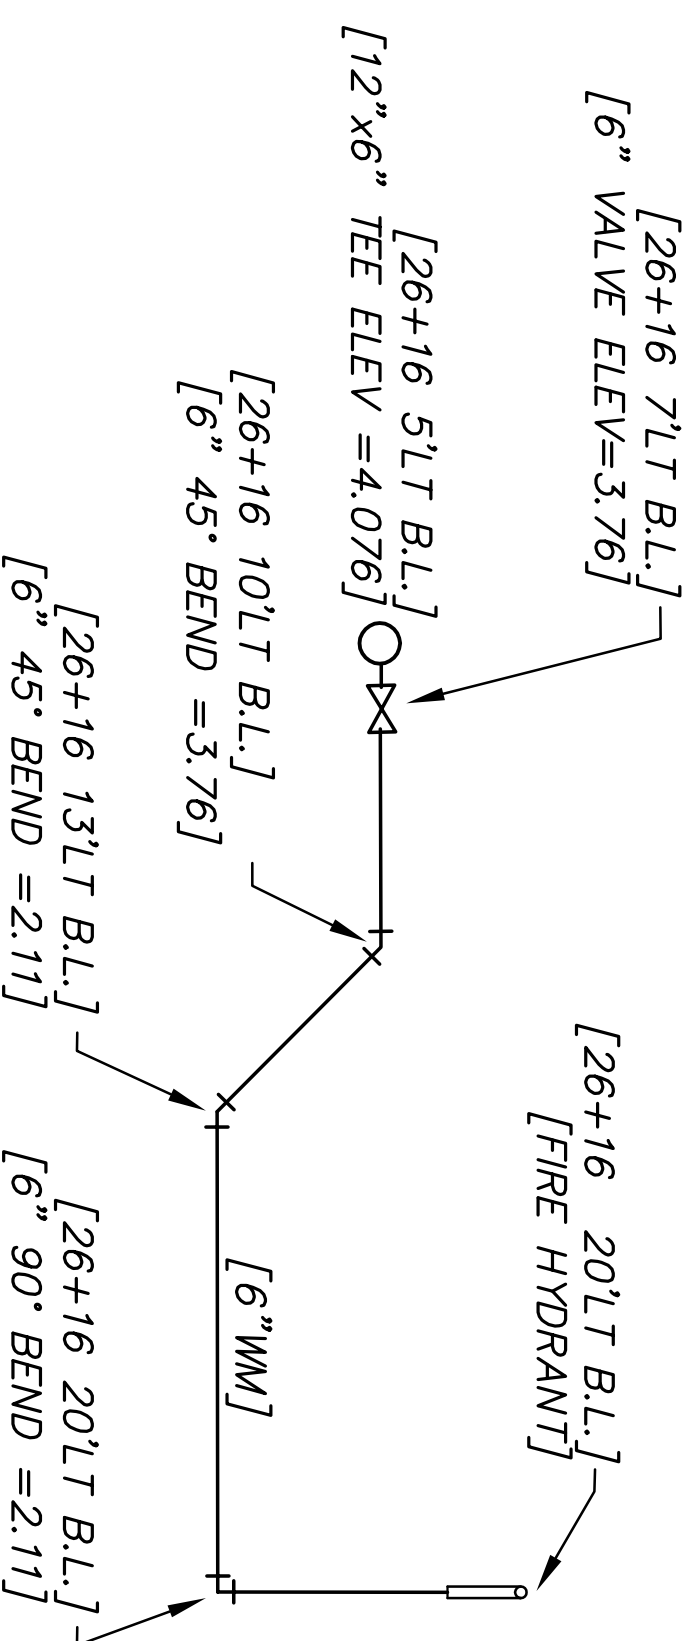


TAP #8 DETAIL
HYDRANT SERVICE
LINE DETAIL
SEE SHEET C-105
FOR TAP LOCATION

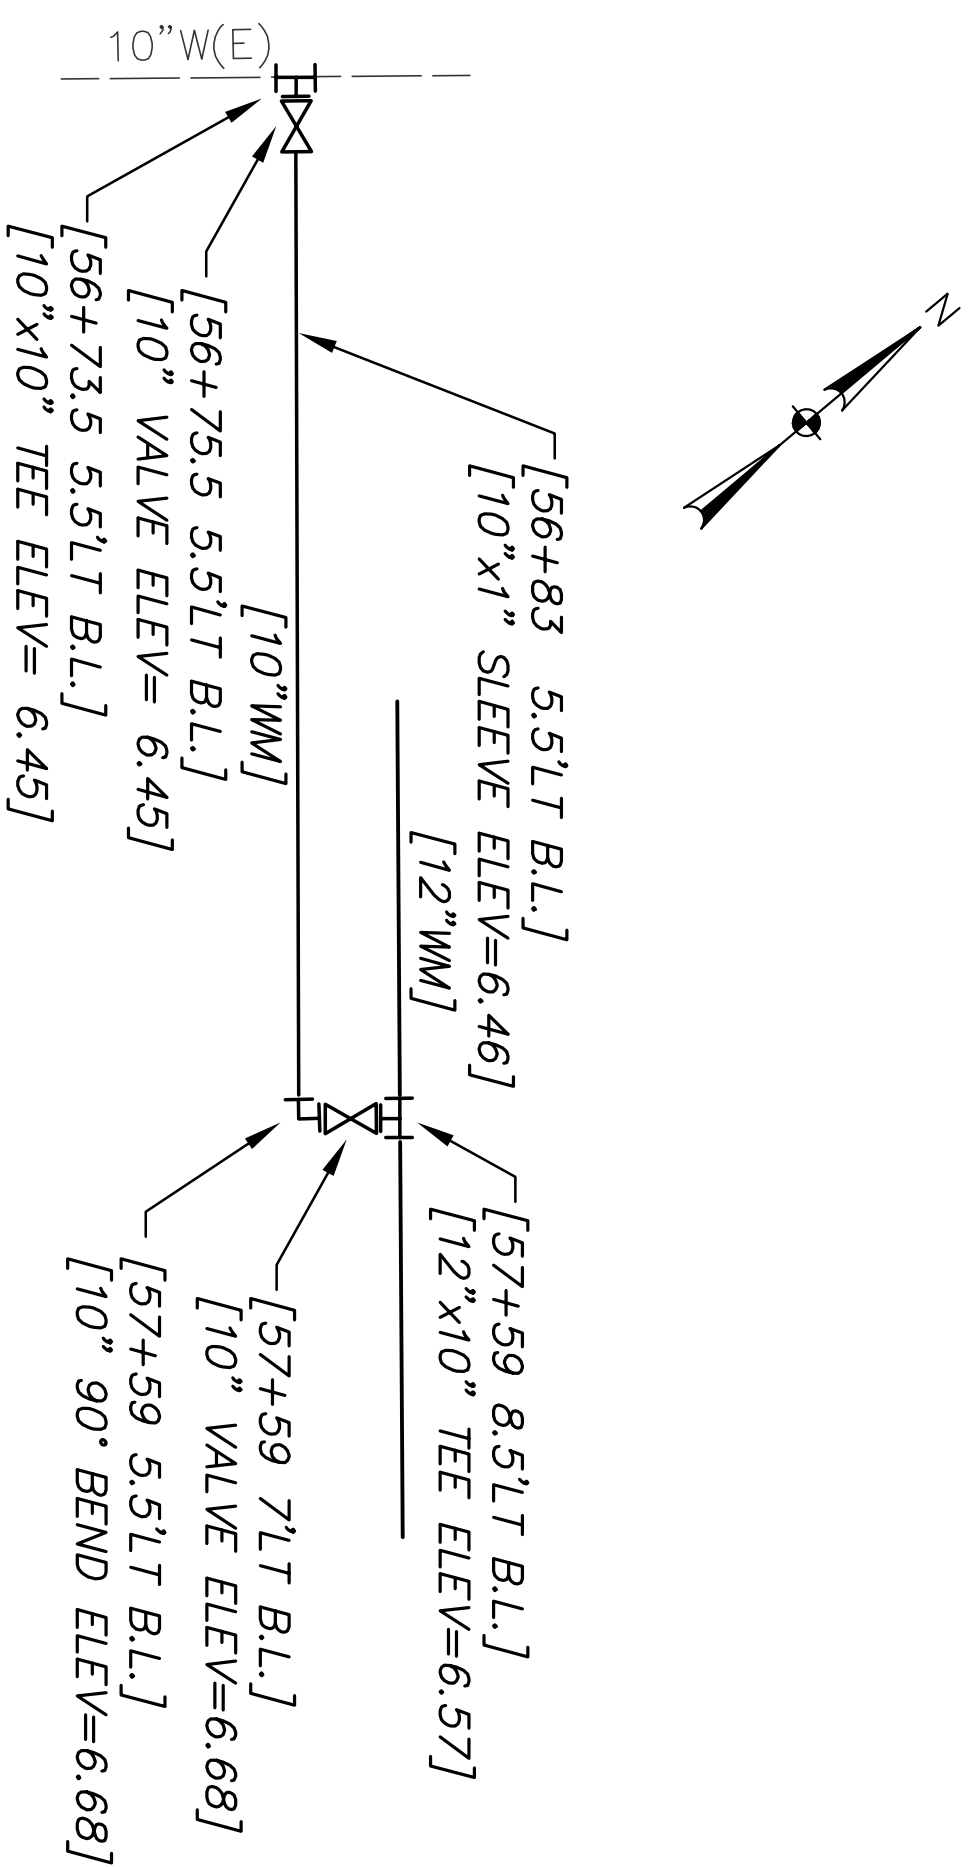

TAP #11 DETAIL
SEE SHEET C-110
FOR TAP LOCATION

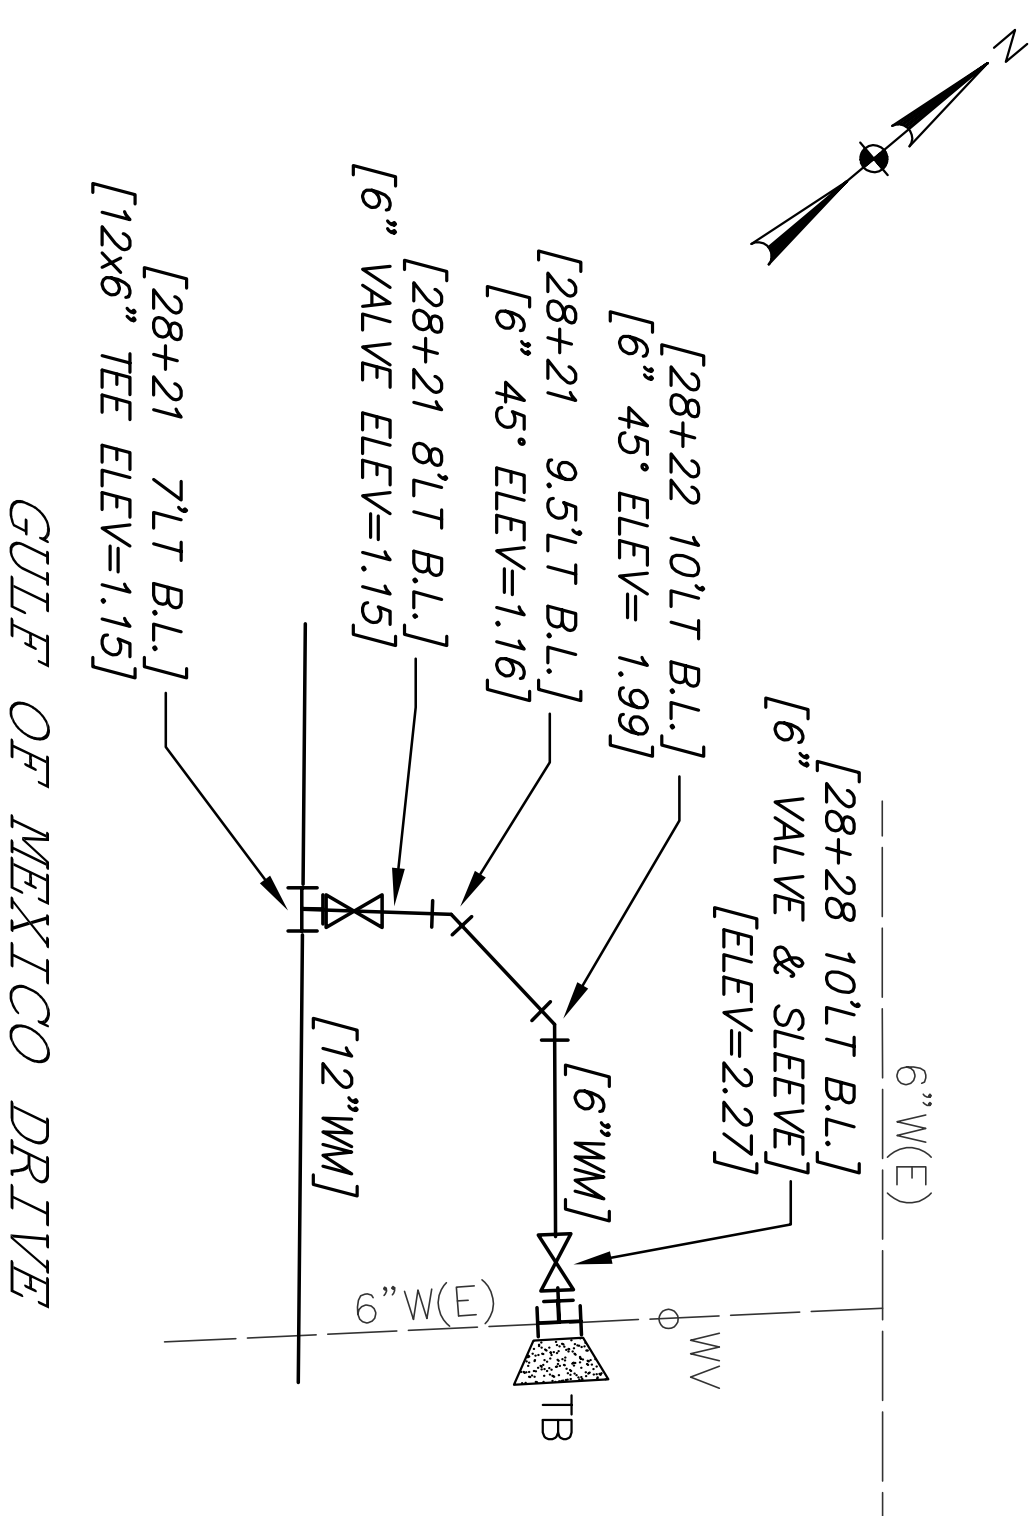

TAP #9 DETAIL
SEE SHEET C-105
FOR TAP LOCATION

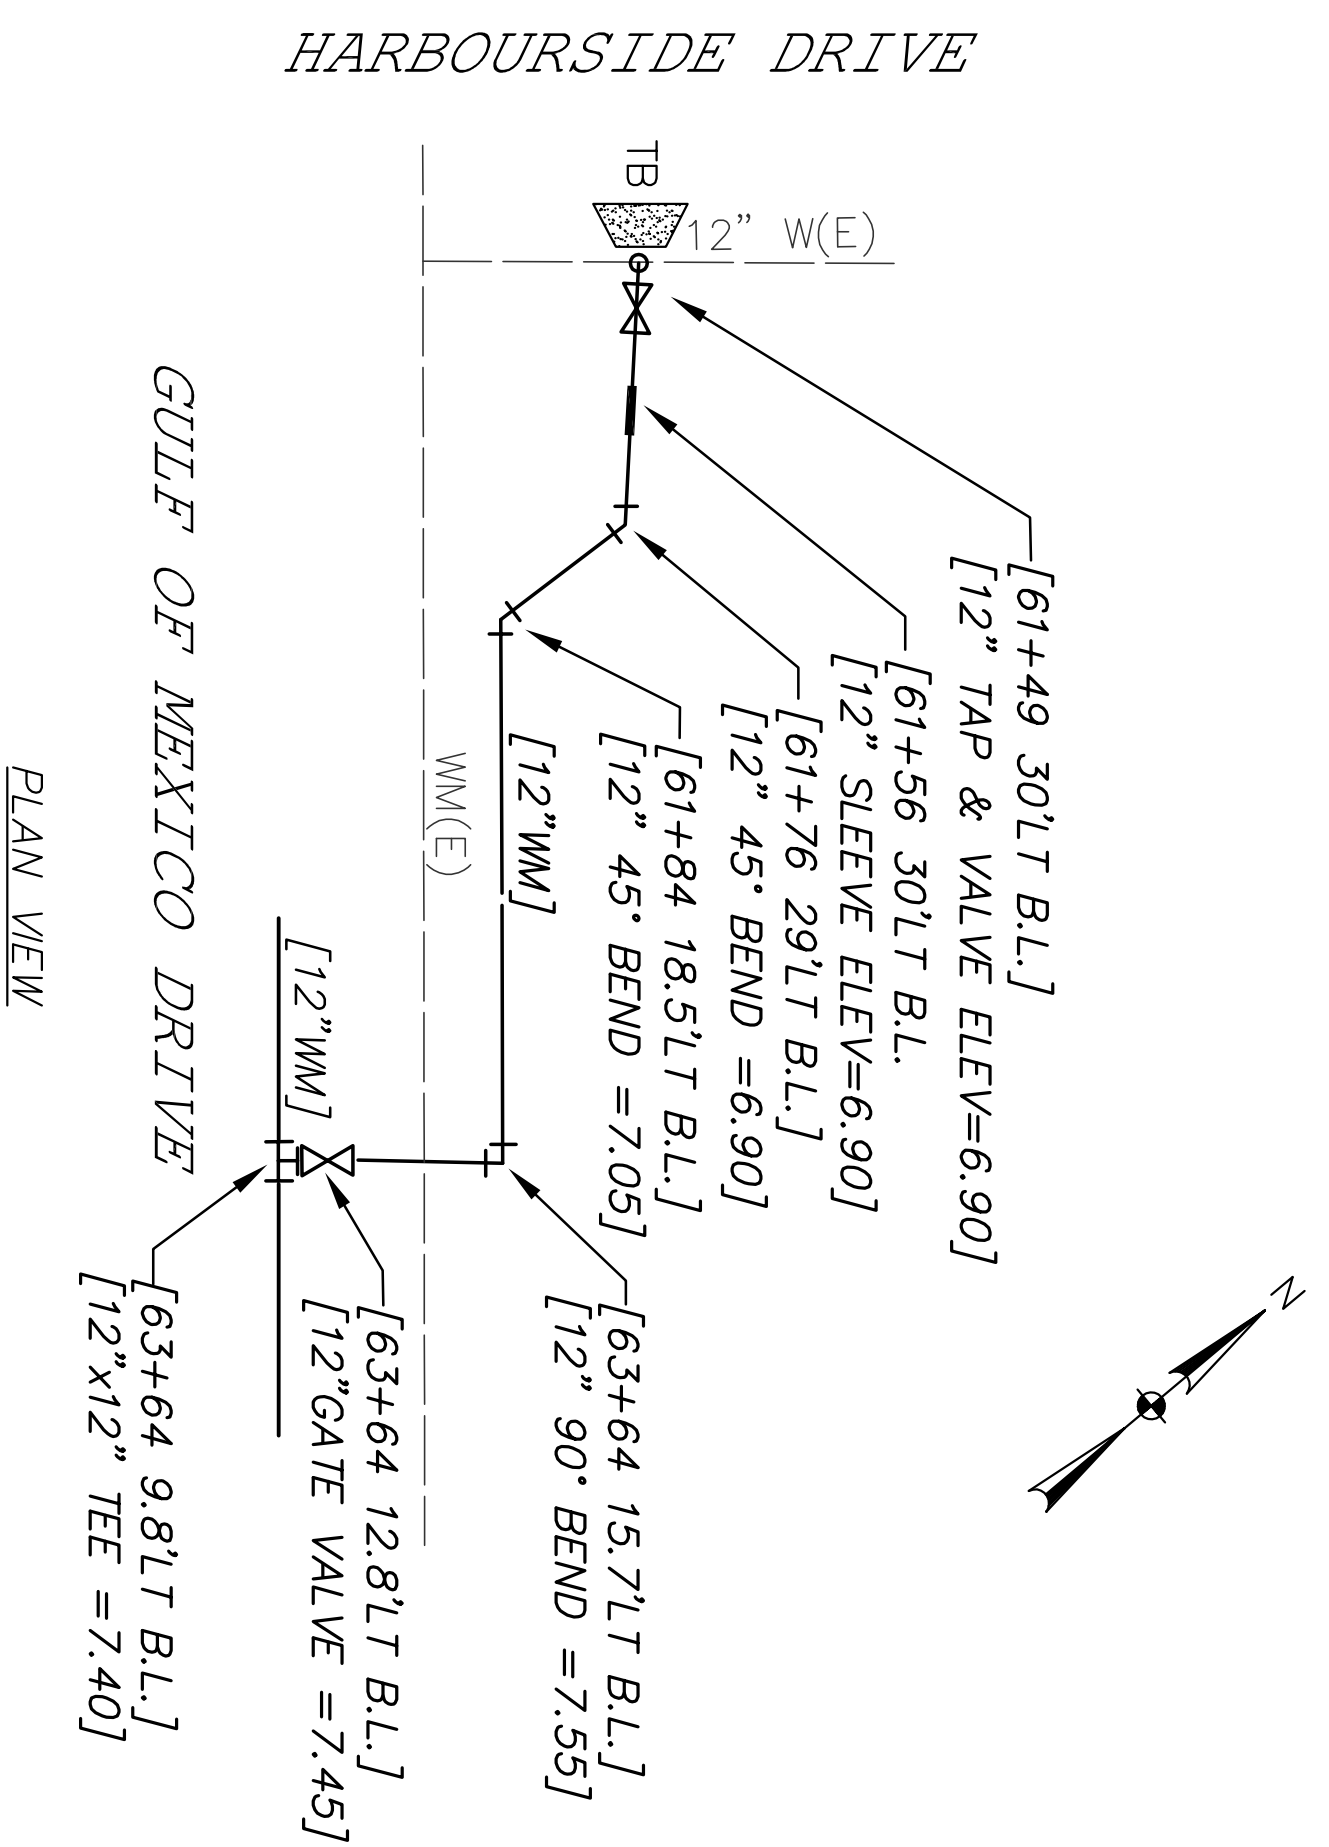

TAP #12 DETAIL
SEE SHEET C-111
FOR TAP LOCATION

TAP DETAILS

UPSIZE POTABLE WATER TRANSMISSION MAIN
TOWN OF LONGBOAT KEY, SARASOTA COUNTY, FLORIDA

ENGINEERING VISIONS, INC.
FL COA# 27192
3056 UNIVERSITY PARKWAY
SARASOTA, FLORIDA 34243
PH:(941) 355-0000, FAX:(941) 355-0006

ENGINEERING, INC.
FL COA# 26755
3056 UNIVERSITY PARKWAY
SARASOTA, FLORIDA 34243
PH:(941) 355-0000, FAX:(941) 355-0006

PROJECT MANAGER:
LAURA S. ANDREWS, PE
FILE NAME:
LBK_WMA_T-100.DWG
ACCOUNT:

DESIGNED BY:
LSA/TGW
DRAWN BY:
KP
DATE
10/17/08

NO.	REVISIONS	DATE
1	CONFORMED DRAWING	11/04/09
2	ASBUILT DRAWINGS	6/13/11

DRWG. NO.:
T-101
SHT. 57

DRAWING SIZE 24" x 36" - USE GRAPHIC SCALE OTHERWISE

Thomas G. Healy, P.E.
Florida PE 31403
Date: