




TAP #19-A DETAIL
SEE SHEET C-116
FOR TAP LOCATION

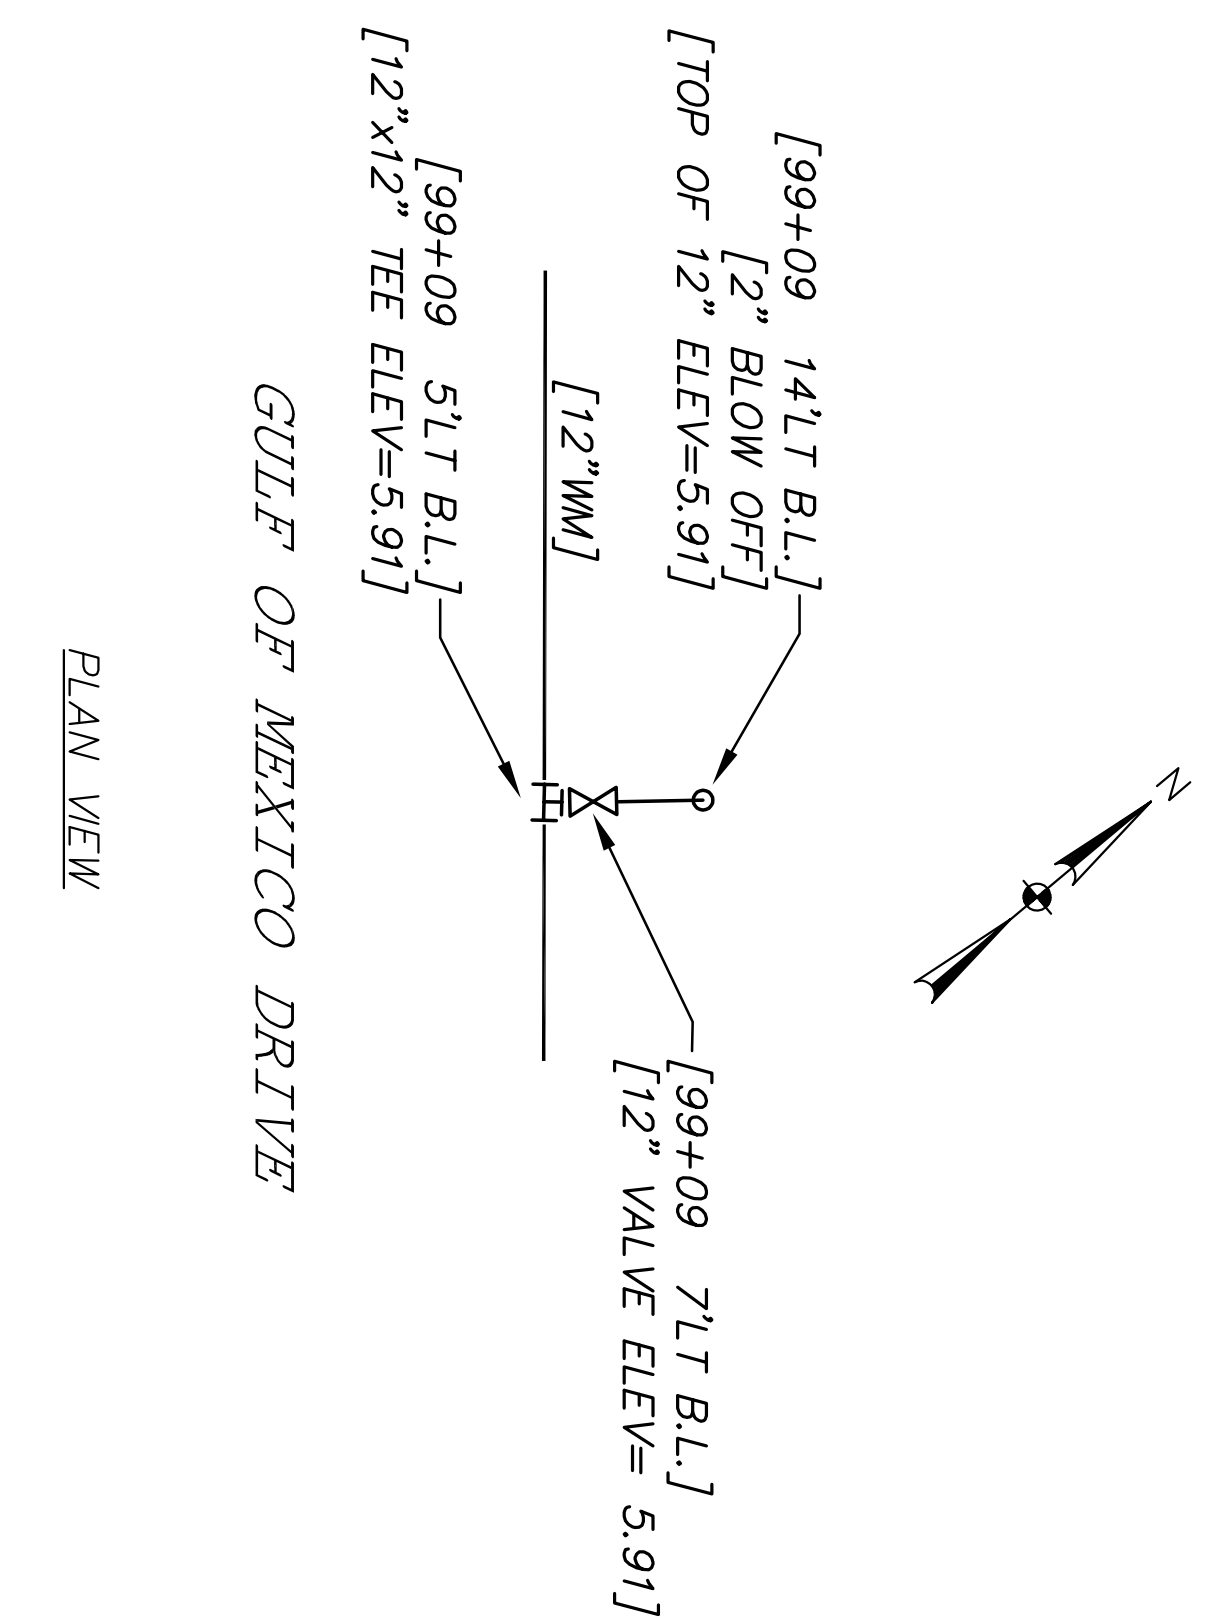


TAP #20-A DETAIL
PERMANENT BLOW OFF
SEE SHEET C-117
FOR TAP LOCATION

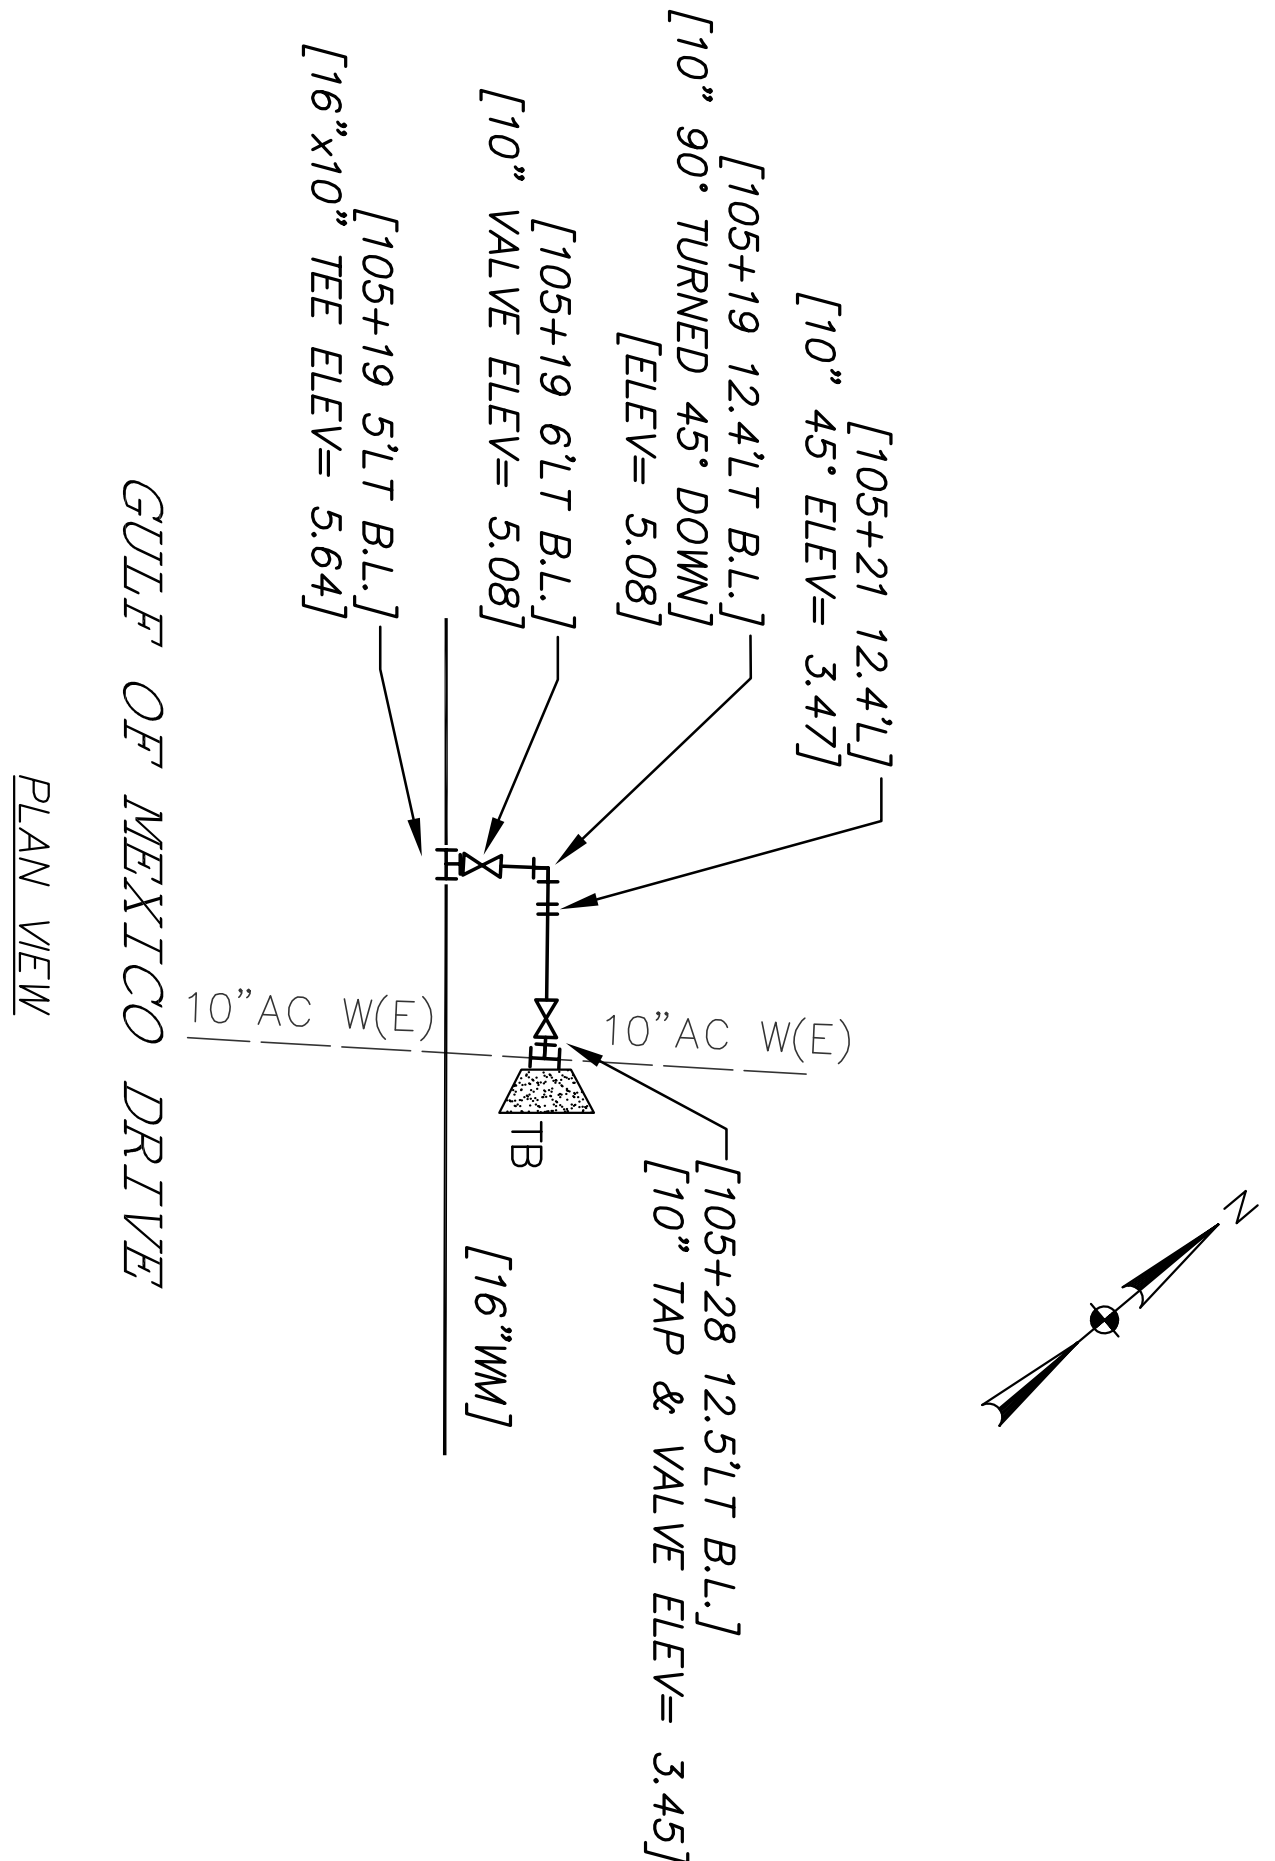


TAP #21-A DETAIL
SEE SHEET C-118
FOR TAP LOCATION

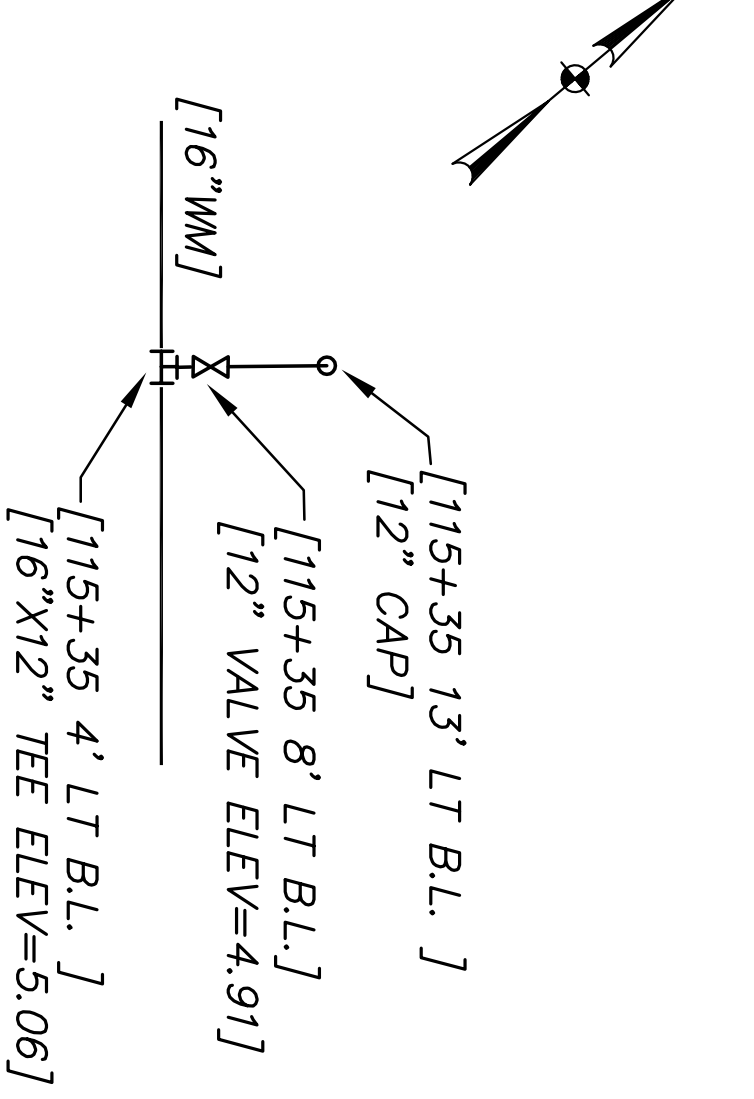

TAP #22 DETAIL
SEE SHEET C-1200
FOR TAP LOCATION

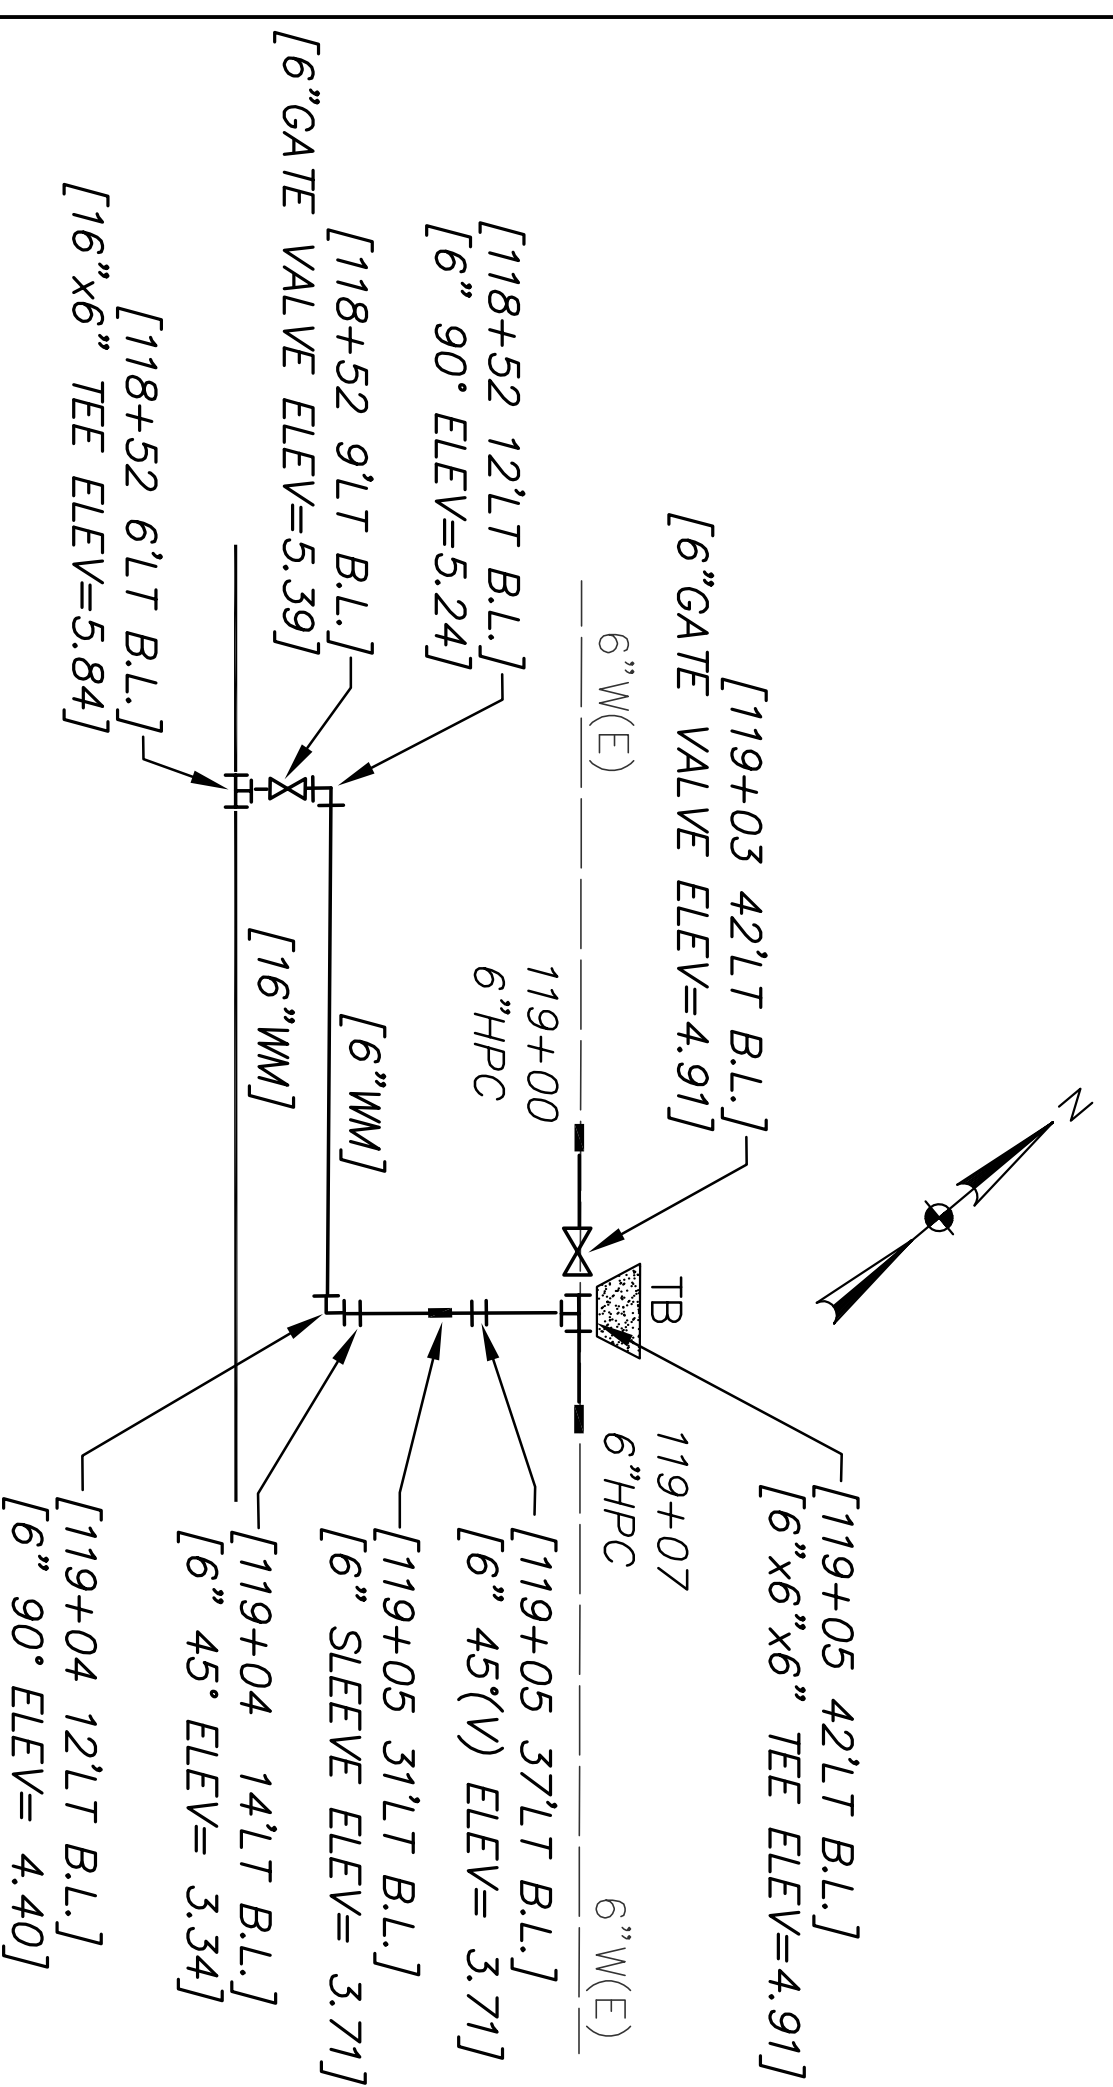

TAP #23 DETAIL
SEE SHEET C-1200
FOR TAP LOCATION

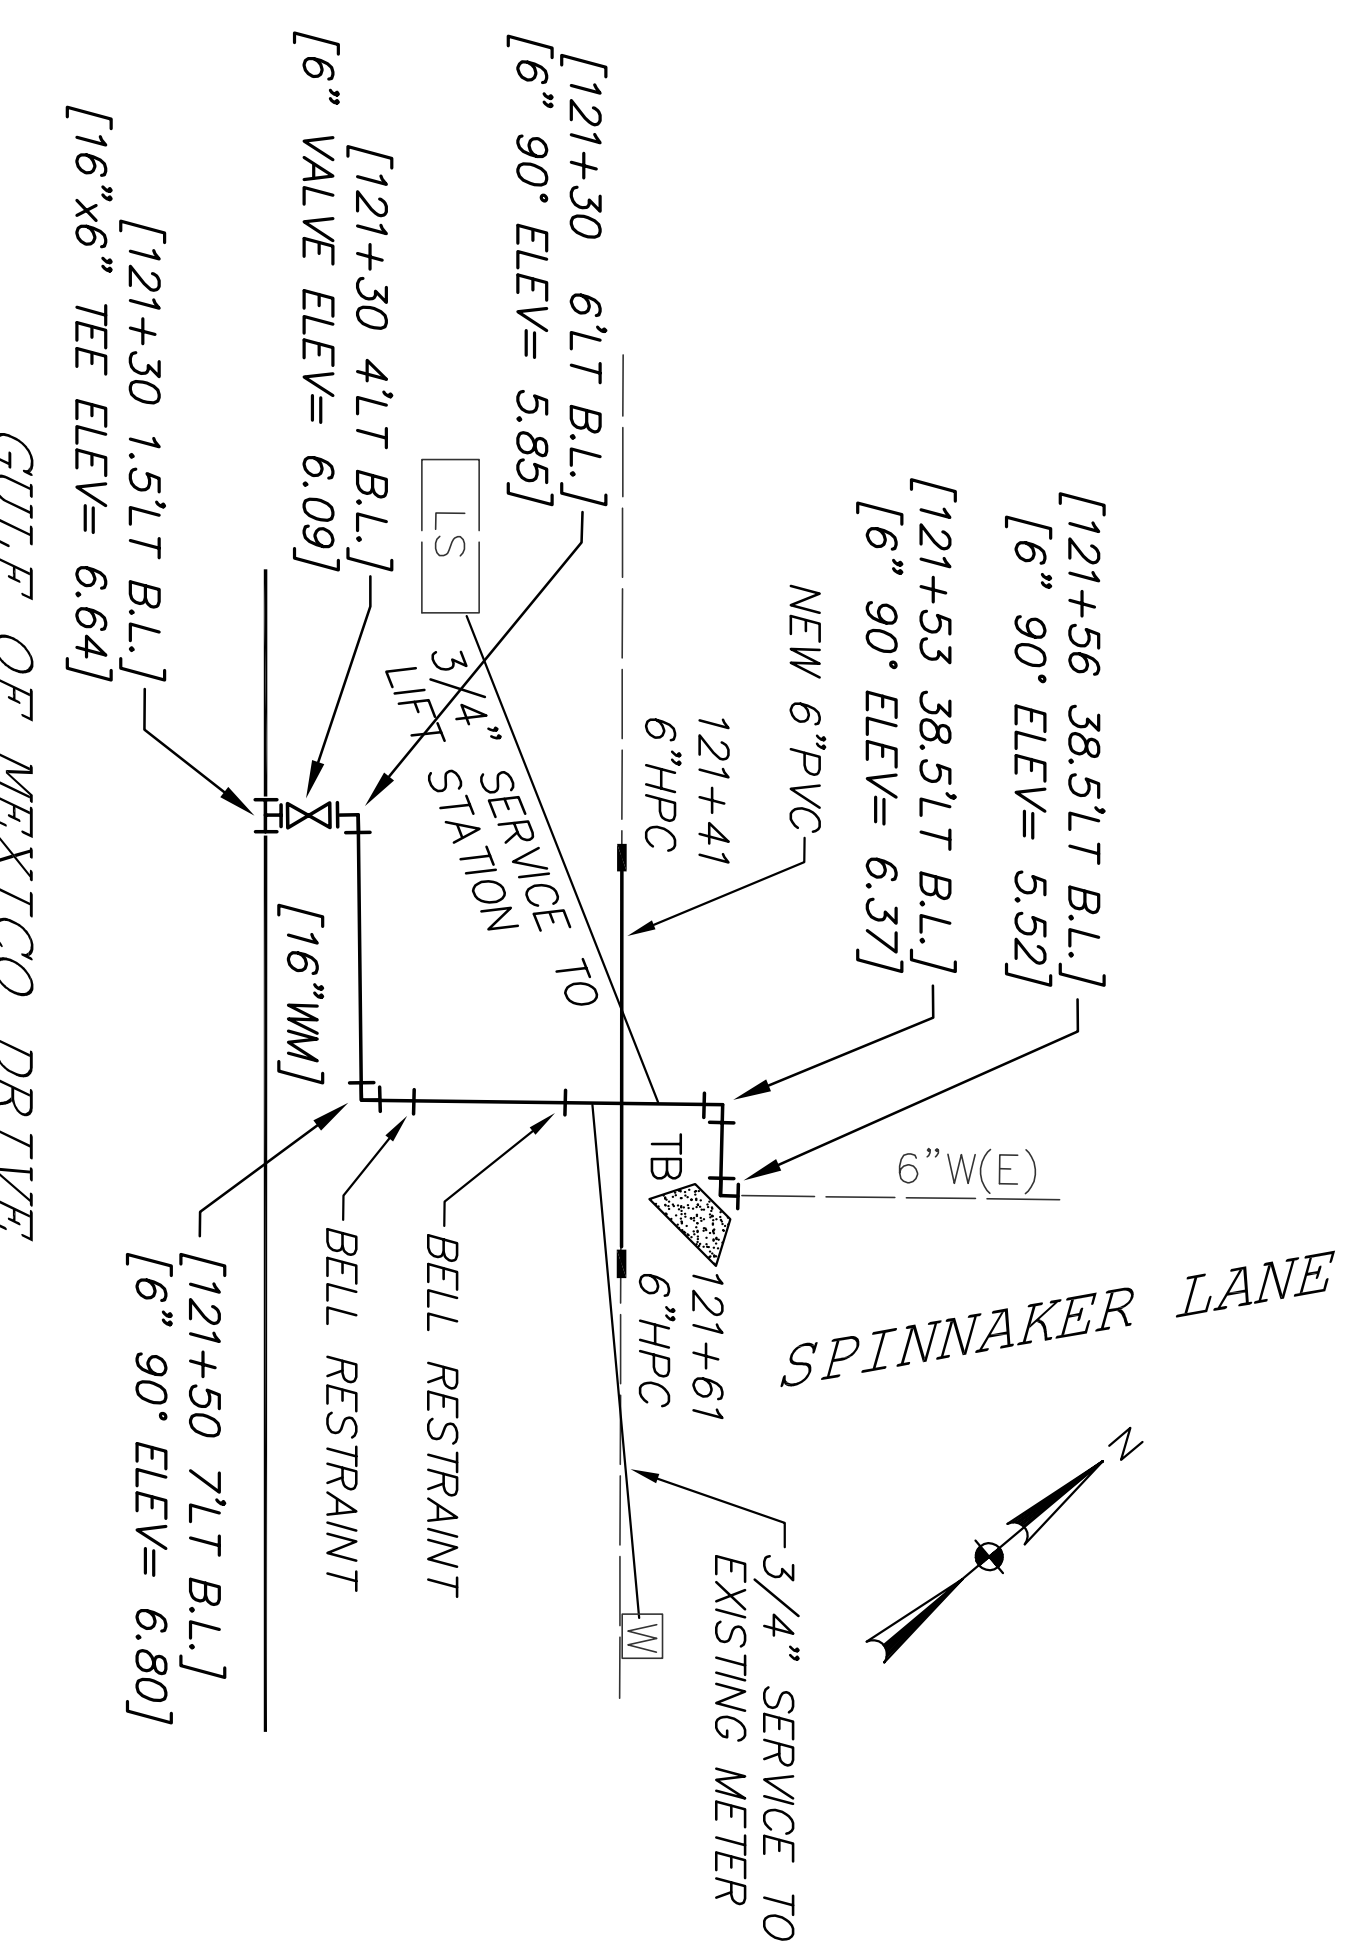

TAP #24 DETAIL
SEE SHEET C-121
FOR TAP LOCATION

TAP DETAILS

UPSIZED POTABLE WATER TRANSMISSION MAIN
TOWN OF LONGBOAT KEY, SARASOTA COUNTY, FLORIDA

ENGINEERING VISIONS, INC.
FL COA# 27192
3056 UNIVERSITY PARKWAY
SARASOTA, FLORIDA 34243
PH:(941) 355-0000, FAX:(941) 355-0006

ENGINEERING INC.
FL COA# 26755
3056 UNIVERSITY PARKWAY
SARASOTA, FLORIDA 34243
PH:(941) 355-0000, FAX:(941) 355-0006

PROJECT MANAGER:
LAURA S. ANDREWS, PE
FILE NAME:
LBK_WMA_T-100.DWG
ACCOUNT:

DESIGNED BY:
LSA/TGW
DRAWN BY:
KP
DATE
10/17/08

REVISIONS
CONFORMED DRAWING
ASBUILT DRAWINGS

DATE
11/04/09
6/13/11

DRWG. NO:
T-103
SHT. 59

Thomas G. Muller, P.E.
Florida PE 31403
Date:

DRAWING SIZE 24" x 36" - USE GRAPHIC SCALE OTHERWISE